

ORIGINAL DRAWING - INK ON POLYESTER FILM MEETING THE REQUIREMENTS OF 27 V.S.A. § 1403

STATE OF VERMONT
AGENCY OF TRANSPORTATION

RIGHT - OF - WAY DETAIL SHEET


TABLE OF PROPERTY ACQUISITION

PARCEL NO.	PROPERTY OWNER	SHEET NO.	BEGINNING STATION	ENDING STATION	TAKE	REMAINDER	RIGHT			RECORDING DATA				REMARKS	
					AREA±	AREA±	TYPE	(T)(P)	AREA ±	TITLE	DATE	TOWN / CITY	BOOK		PAGE
5B	GUILLE, PETER, JR. (CONTINUED)	27	174+80 RT	181+20 RT	0.28±					COND	08/25/90	SEARSBURG	13	189	
5C		28	188+52 RT	197+71 CL	0.88±					COND	08/25/90	SEARSBURG	13	184	
5D		29	207+57 RT	212+04 RT	0.43±					COND	08/27/90	WILMINGTON	129	499	
5E		26	163+70 LT	169+43 RT	0.55±					COND	08/25/90	SEARSBURG	13	187	HWY. EASE. VT. RTE. 9
5F		27	174+82 RT	181+20 RT	0.51±			ALL R.T. & I.		COND	08/25/90	SEARSBURG	13	189	HWY. EASE. VT. RTE. 9
5G		28	188+48 RT	197+73	0.52±			ALL R.T. & I.		COND	08/25/90	SEARSBURG	13	189	HWY. EASE. VT. RTE. 9
5H		29	207+55 RT	212+04 RT	0.37±			ALL R.T. & I.		COND	08/27/90	WILMINGTON	129	499	HWY. EASE. VT. RTE. 9 EXCEPTING & RESERVING TO NEW ENGLAND POWER COMPANY WHATEVER RIGHTS OF RECORD IT MAY HAVE INCLUDING FLOWAGE RIGHTS
6A	GREEN MOUNTAIN NATIONAL SERVICE U.S.D.A.	27	174+90 LT 175+15 LT	175+51 LT	0.07±					HED	11/13/89	SEARSBURG	13	143	3050 S.F.± 20' GRAVEL DRIVE MM 0503
6B		27	174+86 RT	175+51 LT	0.03			ALL R.T. & I.							1150 S.F.± HWY. EASE. EXCEPTING & RESERVING ALL OIL AND GAS MINERALS AS STATED IN HWY. EASE. DEED RECORDED IN BK. 13, PG. 143 SEARSBURG LAND RECORDS
7A	PENSON, RAYMOND	27	175+40 CL 178+35 LT 179+00 LT 179+25 LT 179+51 LT	181+18 LT 181+18 LT 181+18 LT	0.62±			CONST. EASE SLOPE	T P	0.04A± 0.01A±					16' GRAVEL DRIVE MM 0509 1350 S.F.± 455 S.F.±
7B			175+36 RT	181+19 RT	0.35±			ALL R.T. & I.							HWY. EASE. VT. RTE. 9 EXCEPTING & RESERVING TO NEW ENGLAND POWER COMPANY WHATEVER RIGHTS OF RECORD IT MAY HAVE INCLUDING FLOWAGE RIGHTS

TABLE OF REVISIONS

REVISION NO.	SHEET NO.	DESCRIPTION	DATE
55	13, 20, 29	PARCEL NO. 9C TOWNE. CHANGE ENDING STA. FROM 206+46 15' RT TO 207+46 15' RT PARCEL NO. 31B DAVIE. CHANGE BEGINNING STA. FROM 206+46 15' RT TO 207+46 15' RT PER C.O. 8249	07/27/92
56	8, 11, 23-26, 29-33, 35, 36	PARCEL NO. 2 NEW ENGLAND POWER COMPANY. REVISE PLANS AS SHOWN ON ATTACHED SHEETS PER C.O. 8427	08/31/93
57	8, 22, 26, 29-33, 35, 36	PARCEL NO. 2 NEW ENGLAND POWER COMPANY. CHANGE NAME TO USGEN NEW ENGLAND, INC. PER C.O. 8996	10/05/98
58	8, 9, 10	PARCEL NO. 2 USGEN NEW ENGLAND, INC. ON PARCEL 2C: CHANGE CHANNEL RELOCATION FROM (P) TO (T) AND DELETE (P) FROM EXCEPT & RESERVE. ON PARCEL 2N: DELETE ENDING STATION ON CUL., DIT. & DR (P). PER C.O. 9042 MYLARS TO DESIGN 05/25/99 CONTRACT 1 SHEETS 8,9,22-26	04/13/99
59	9	PARCEL NO. 2 USGEN NEW ENGLAND, INC. PARCEL 2C - REMOVE SLOPE (P) AT STA. 152+35 RT - 153+15 RT CHANGE ENDING STA. OF SLOPE (P) AT STA. 148+35 RT - 150+50 RT TO: 148+35 RT - 153+15 RT; 0.09A! 3922 S.F. !. PARCEL 2E - ADD DRIVE (T) AT BL "A" 35+96 LT - BL "A" 37+55 LT PER C.O. 9056	06/17/99
60	20, 36A	PARCEL NO. 35. MYRIC MASON, LLC. CREATE NEW PARCEL CONSISTING OF PARCEL 35A; 8.94A! OF WELANDS AND PARCEL 35B; 2.01A! OF ROW IN COMMON. PER C.O. 9060	07/23/99
61	20, 36A	PARCEL NO. 36. MOUNT SNOW, LTD. ADD PARCEL NO. 36. ALL R.T. & I. IN PARCEL NO. 35A. TAKING OF 8.94A! REMAINDER OF 213.32A!. PER C.O. 9075	10/11/99

PLAN LEGEND

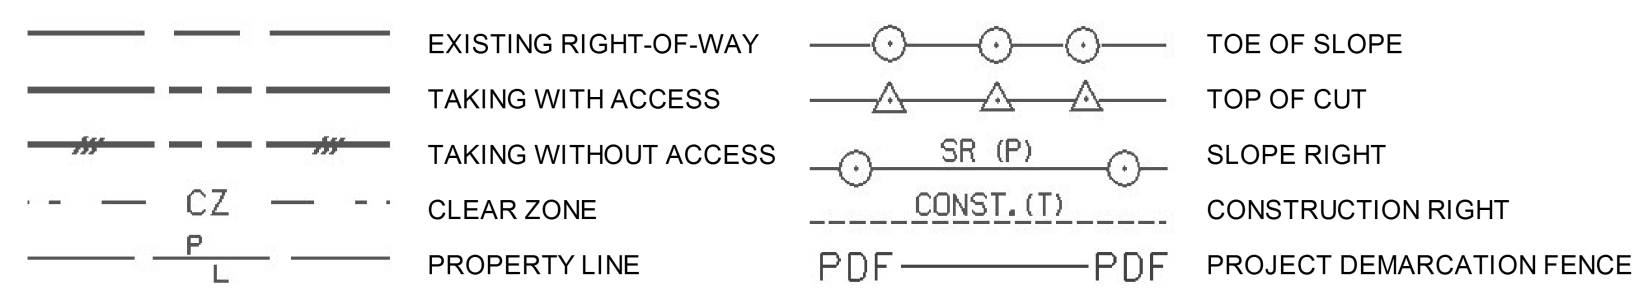

APPROVED: LAWRENCE W. BLISS DATE: 7-5-88
CHIEF, PLANS & TITLES

PLOT DATE 04/16/14

PROJECT NAME: SEARSBURG - WILMINGTON	
PROJECT NUMBER: F 010-1 (18)	
FILE NAME: 78d096	PLOT DATE:
PROJECT LEADER: DELLA SANTA	DRAWN BY: SQUAD B
DESIGNED BY: 0	CHECKED BY: SQUAD B
R.O.W. DETAIL SHEET	SHEET 12 OF 36