
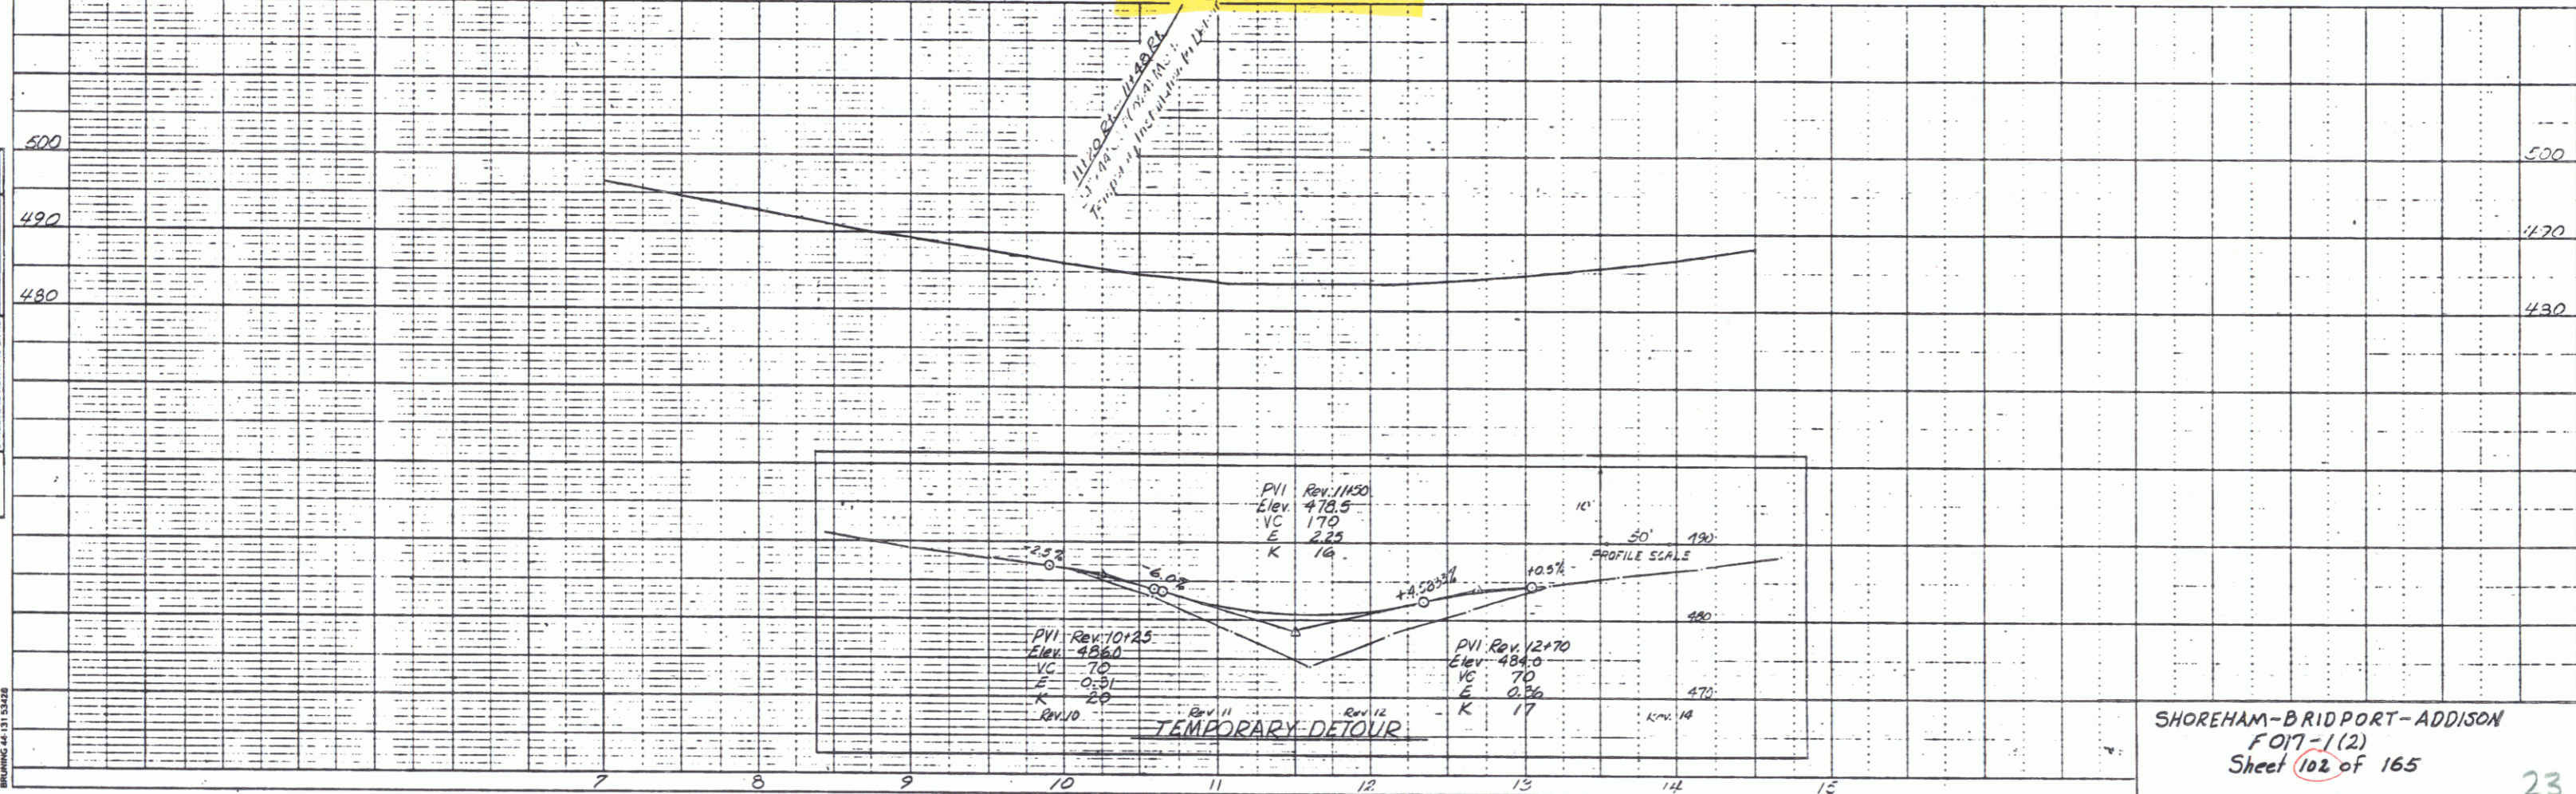


DATE: 5/1/94
 DRAWN BY: THOMAS
 CHECKED BY: THOMAS
 SURVEYED BY: THOMAS
 PLAN: REMOVE AND DISPOSEL OF GUIDE POSTS
 PART OF WAY CHECKED BY: THOMAS

DATE: 5/1/94
 DRAWN BY: HERBIE
 CHECKED BY: HERBIE
 SURVEYED BY: HERBIE
 PROFILE: REMOVE AND DISPOSEL OF GUIDE POSTS
 PART OF WAY CHECKED BY: HERBIE

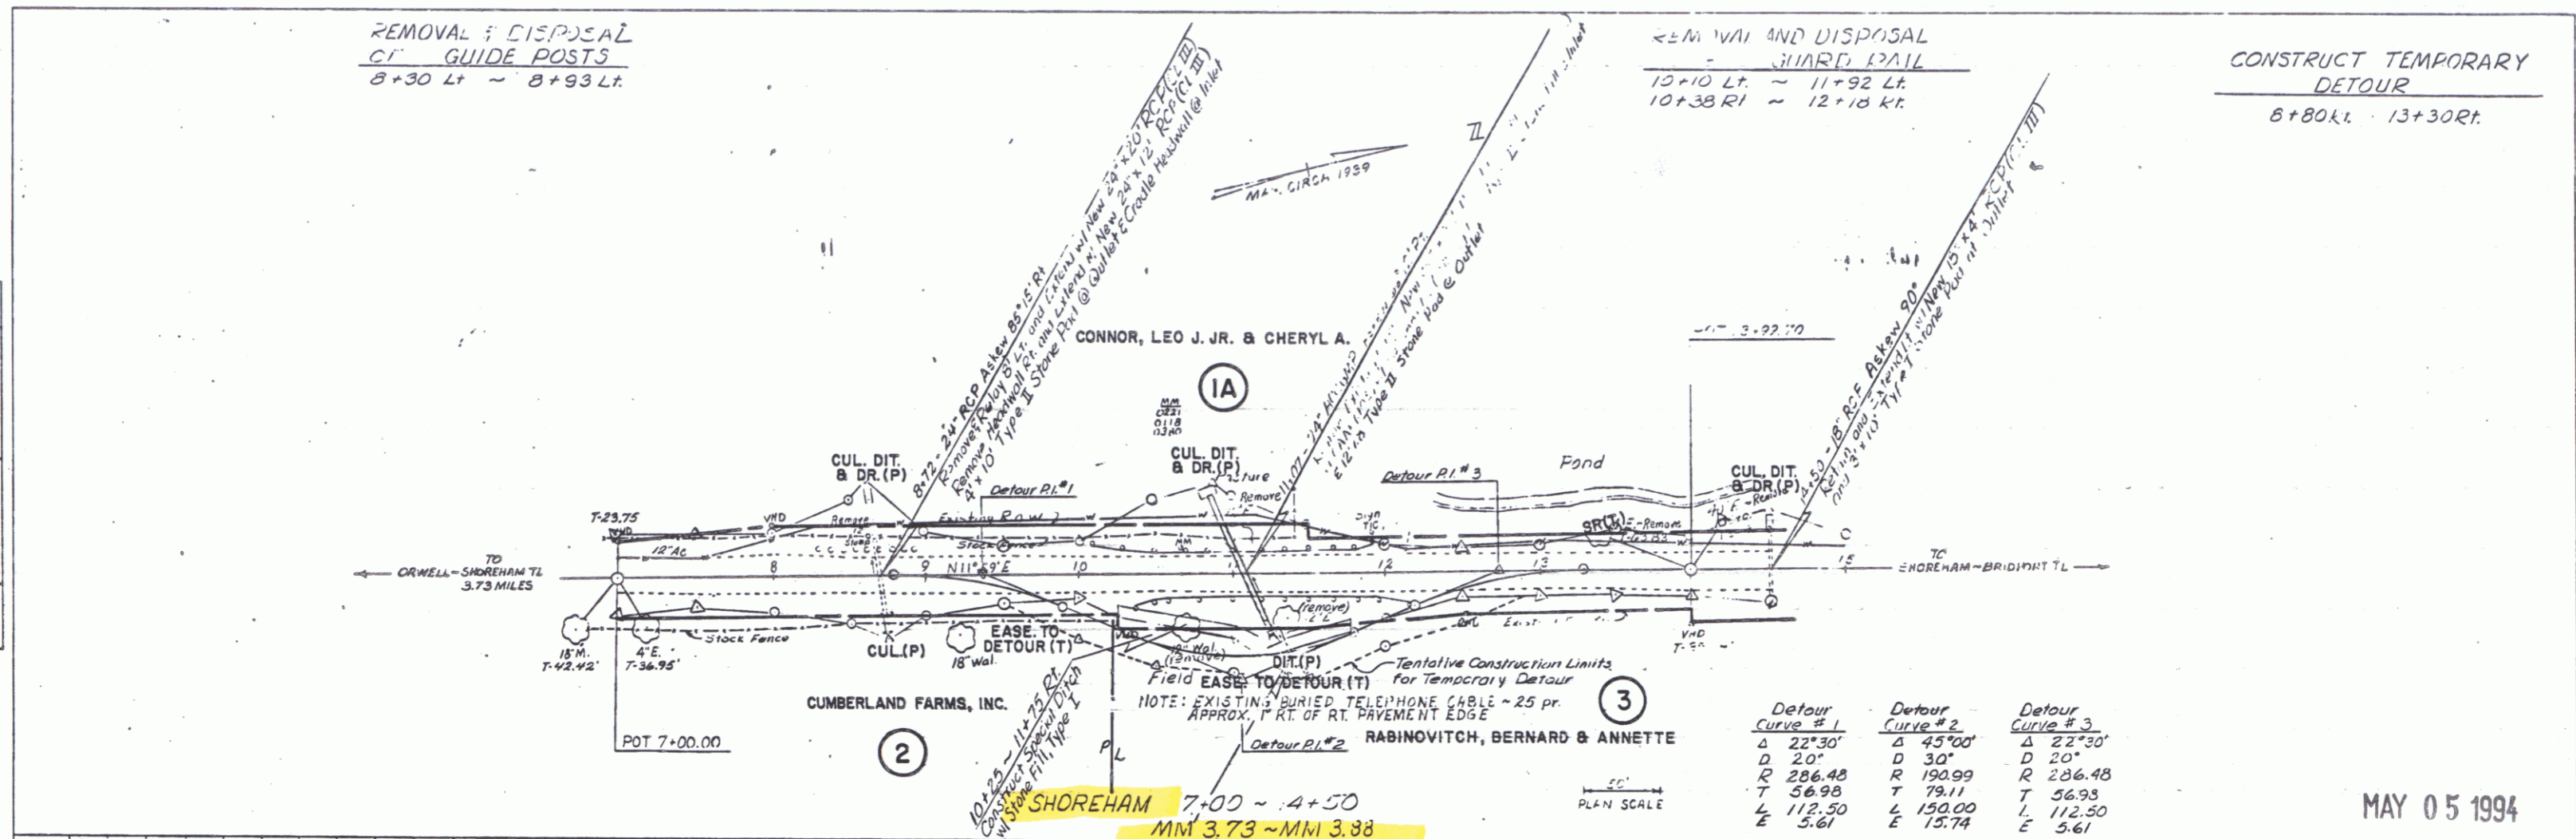

SHOREHAM-BRIDPORT-ADDISON
 F017-1(2)
 Sheet 102 of 165