
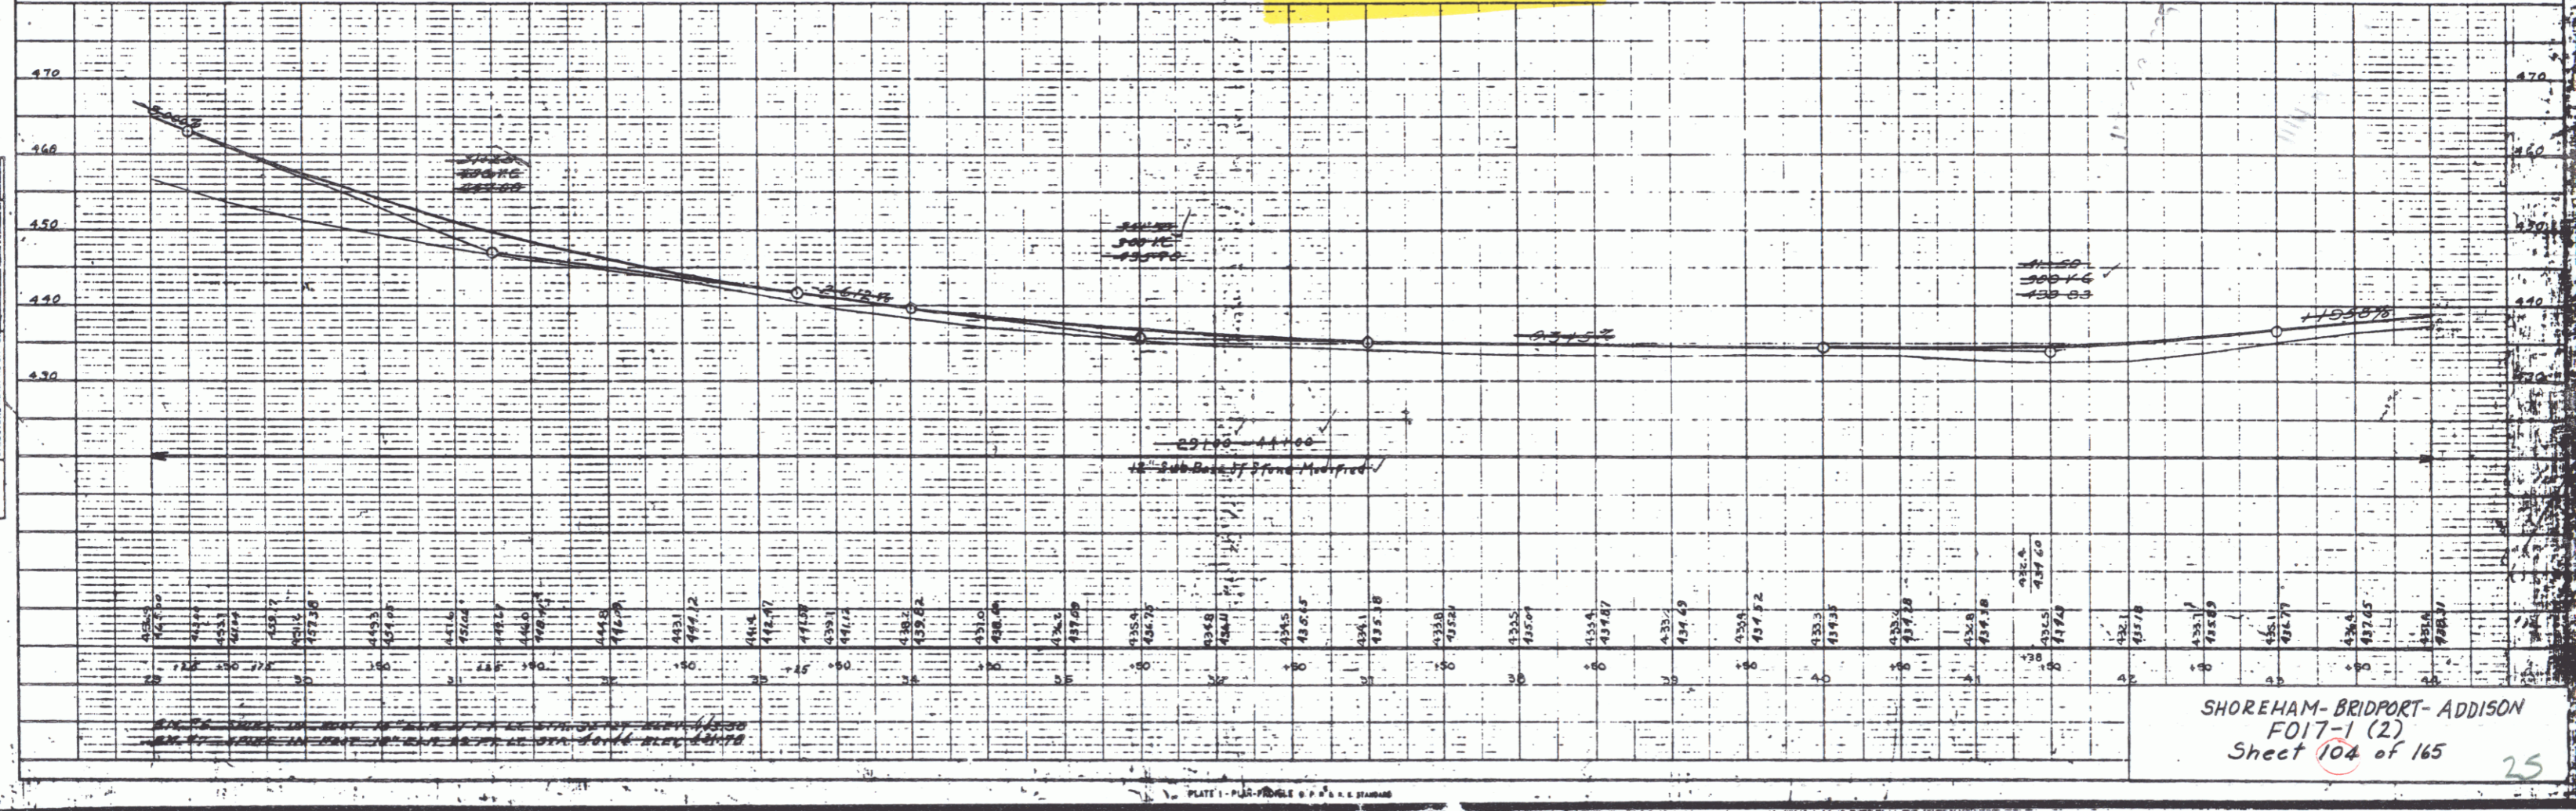


PLAN
 DRAWN BY: J. J. [unclear]
 CHECKED BY: [unclear]
 DATE: [unclear]

PROF. [unclear]
 DRAWN BY: J. J. [unclear]
 CHECKED BY: [unclear]
 DATE: [unclear]

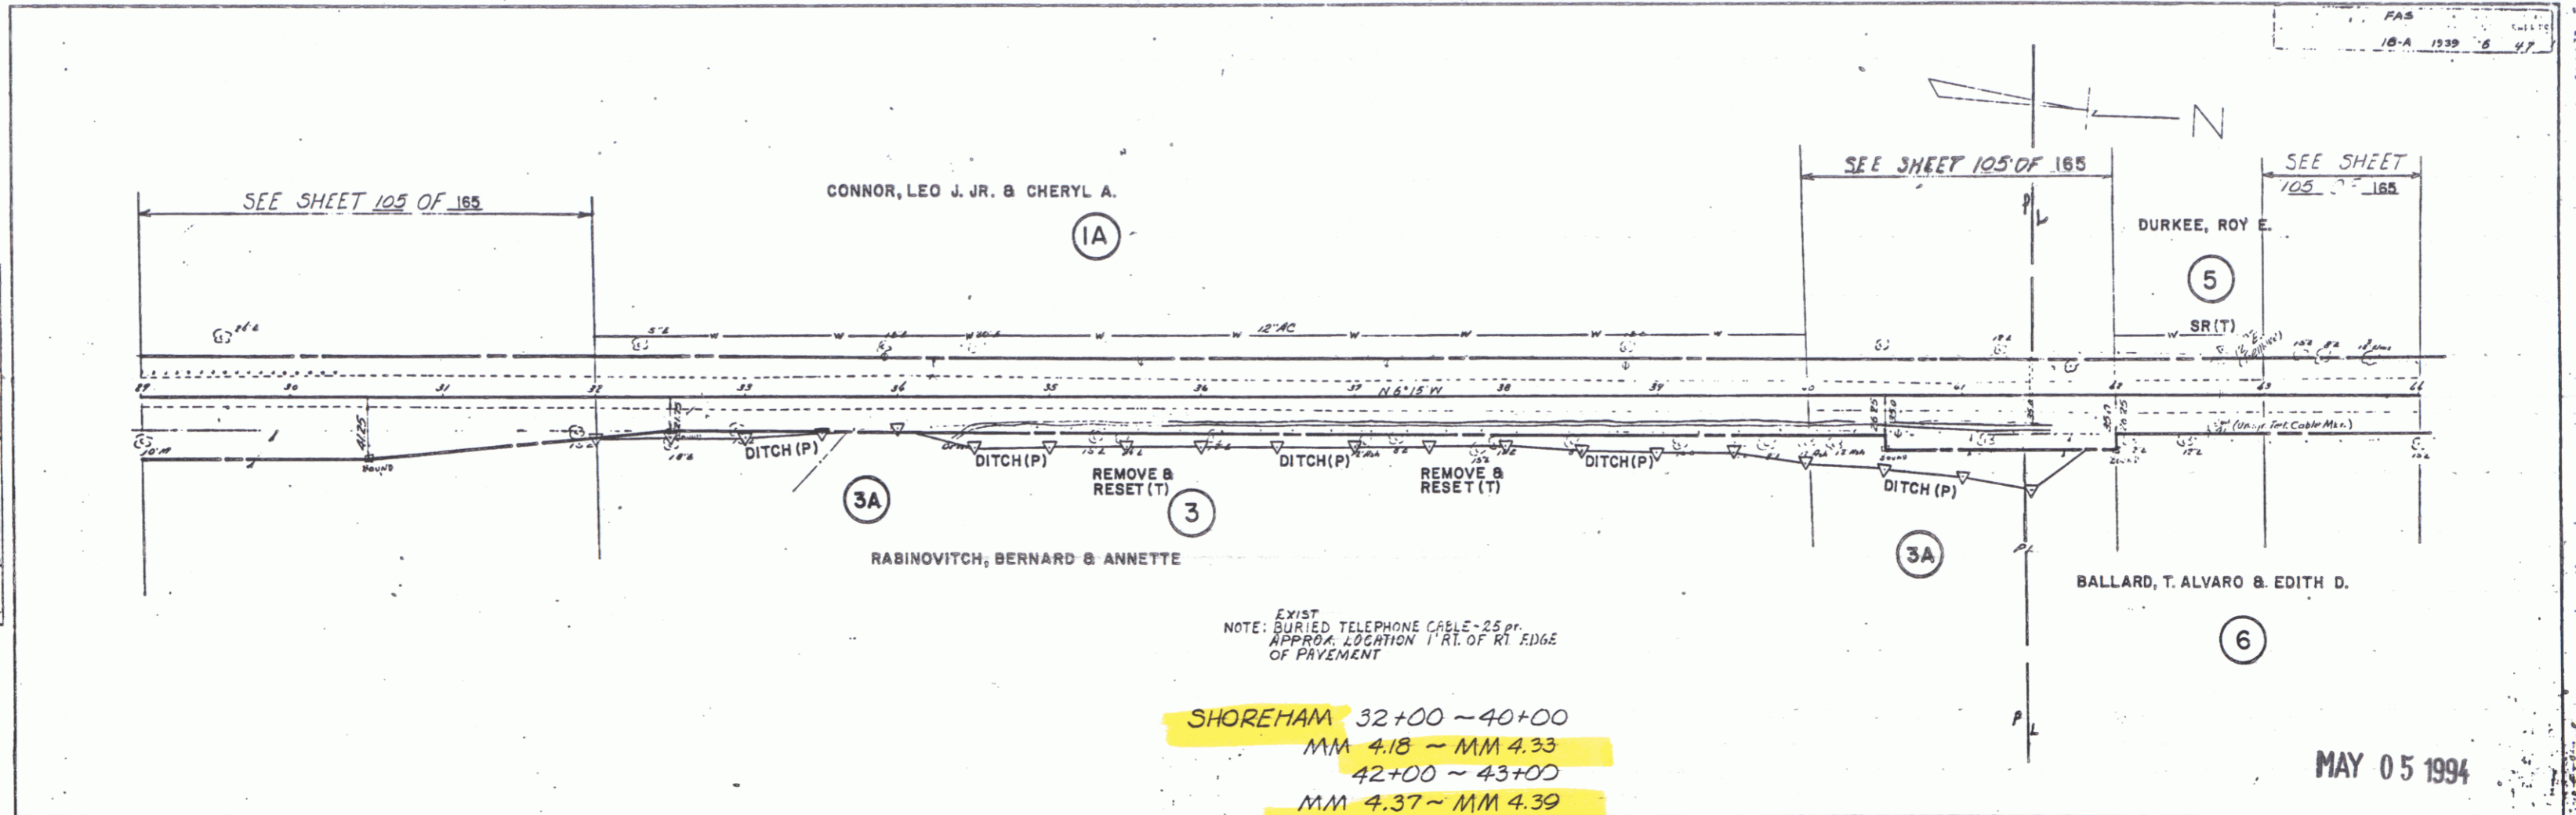

SHOREHAM-BRIDPORT-ADDISON
 FO17-1 (2)
 Sheet 104 of 165