


PLAN  
 SHEET NO. 106  
 PROJECT NO. 101  
 DATE 10-1-1939  
 DRAWN BY J. J. HANCOCK  
 CHECKED BY J. J. HANCOCK

VERTICAL  
 SHEET NO. 106  
 PROJECT NO. 101  
 DATE 10-1-1939  
 DRAWN BY J. J. HANCOCK  
 CHECKED BY J. J. HANCOCK

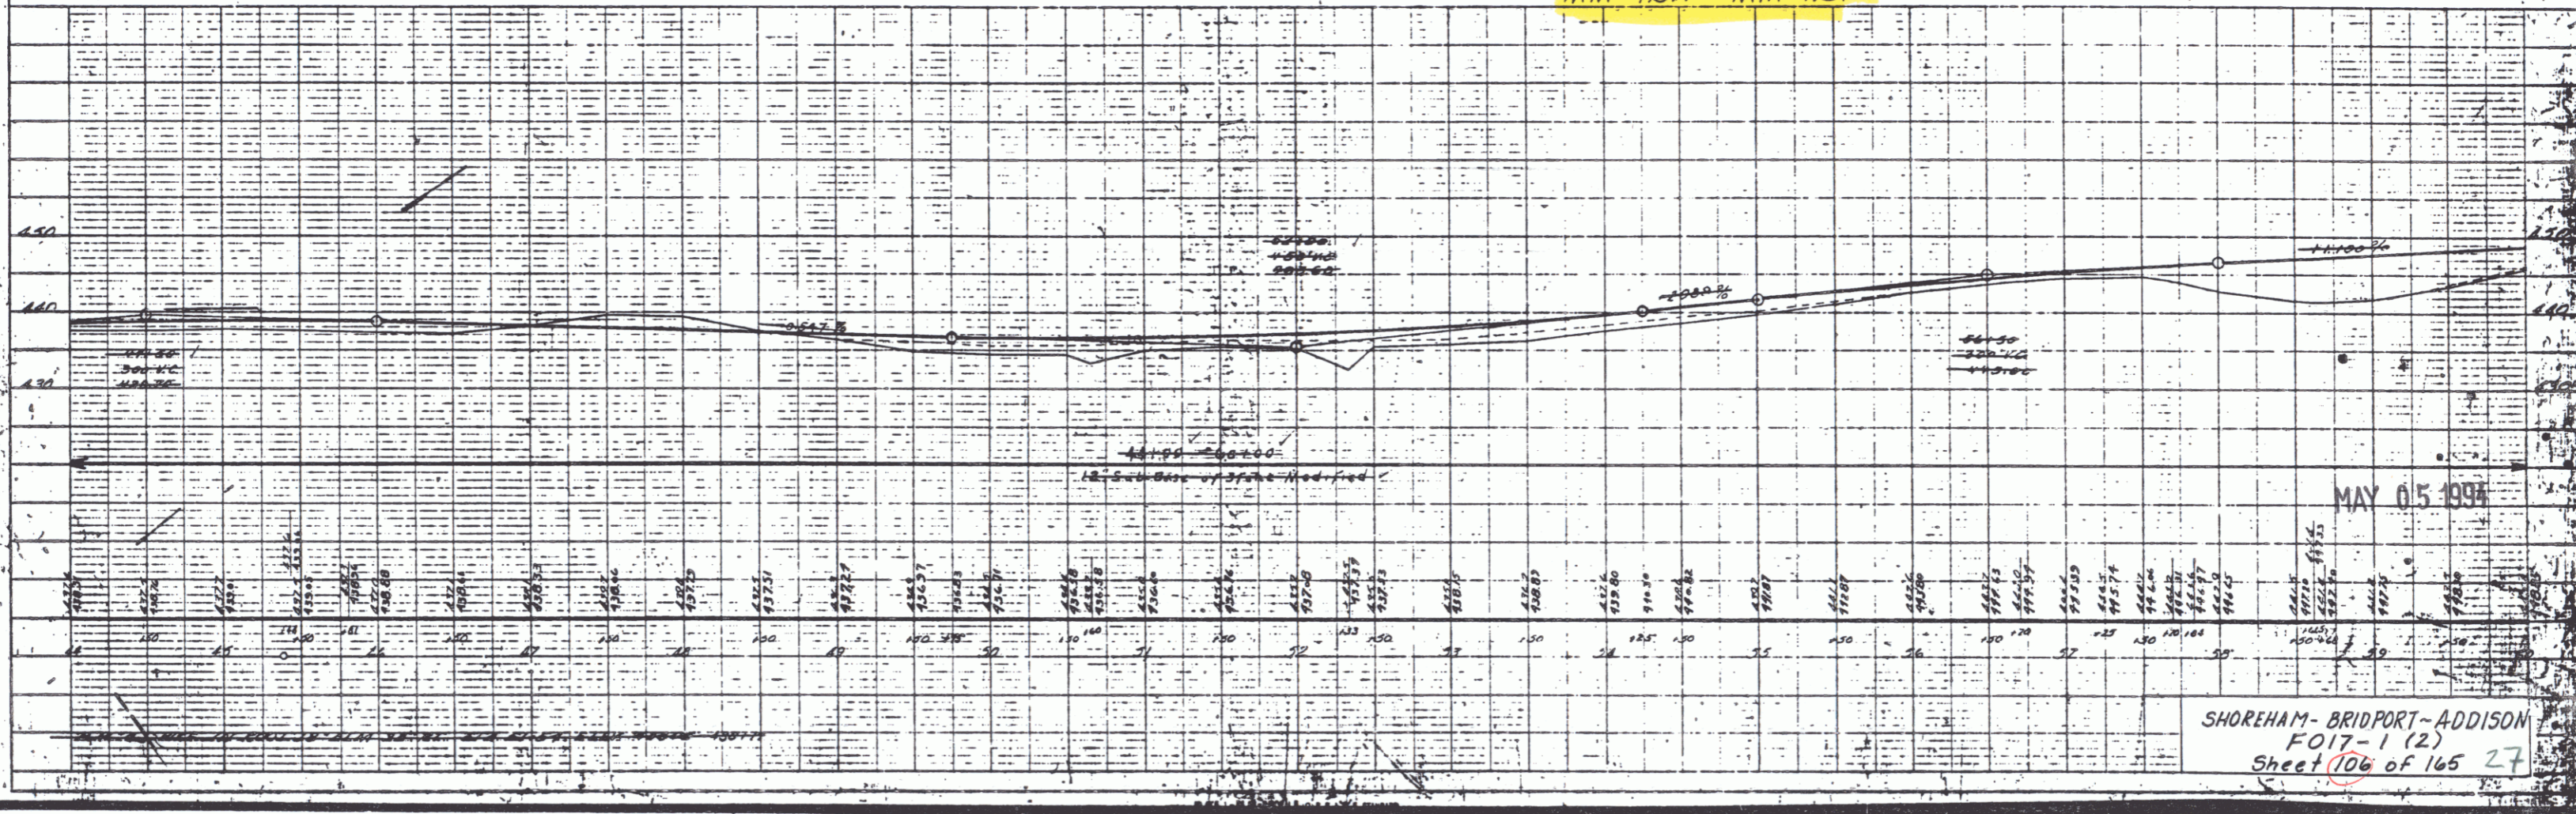

SHOREHAM - BRIDPORT - ADDISON  
 FO 17 1 (2)  
 Sheet 106 of 165 27