


NOTE: EXIST. BURIED TELEPHONE CABLE - 25 FT. APPROX. LOCATION - 1 FT. OF RT. EDGE OF PAYE.

6809-68109 Ditching
To be paid for as all purposes
Excavator Rental & Truck Rental

A = 10° 34' RC
D = 4'
R = 1432.7
T = 247.0
L = 483E
E = 311

PLAN	DATE	BY
NO. OF SHEETS		
NO. OF SHEETS		
NO. OF SHEETS		

DATE	BY

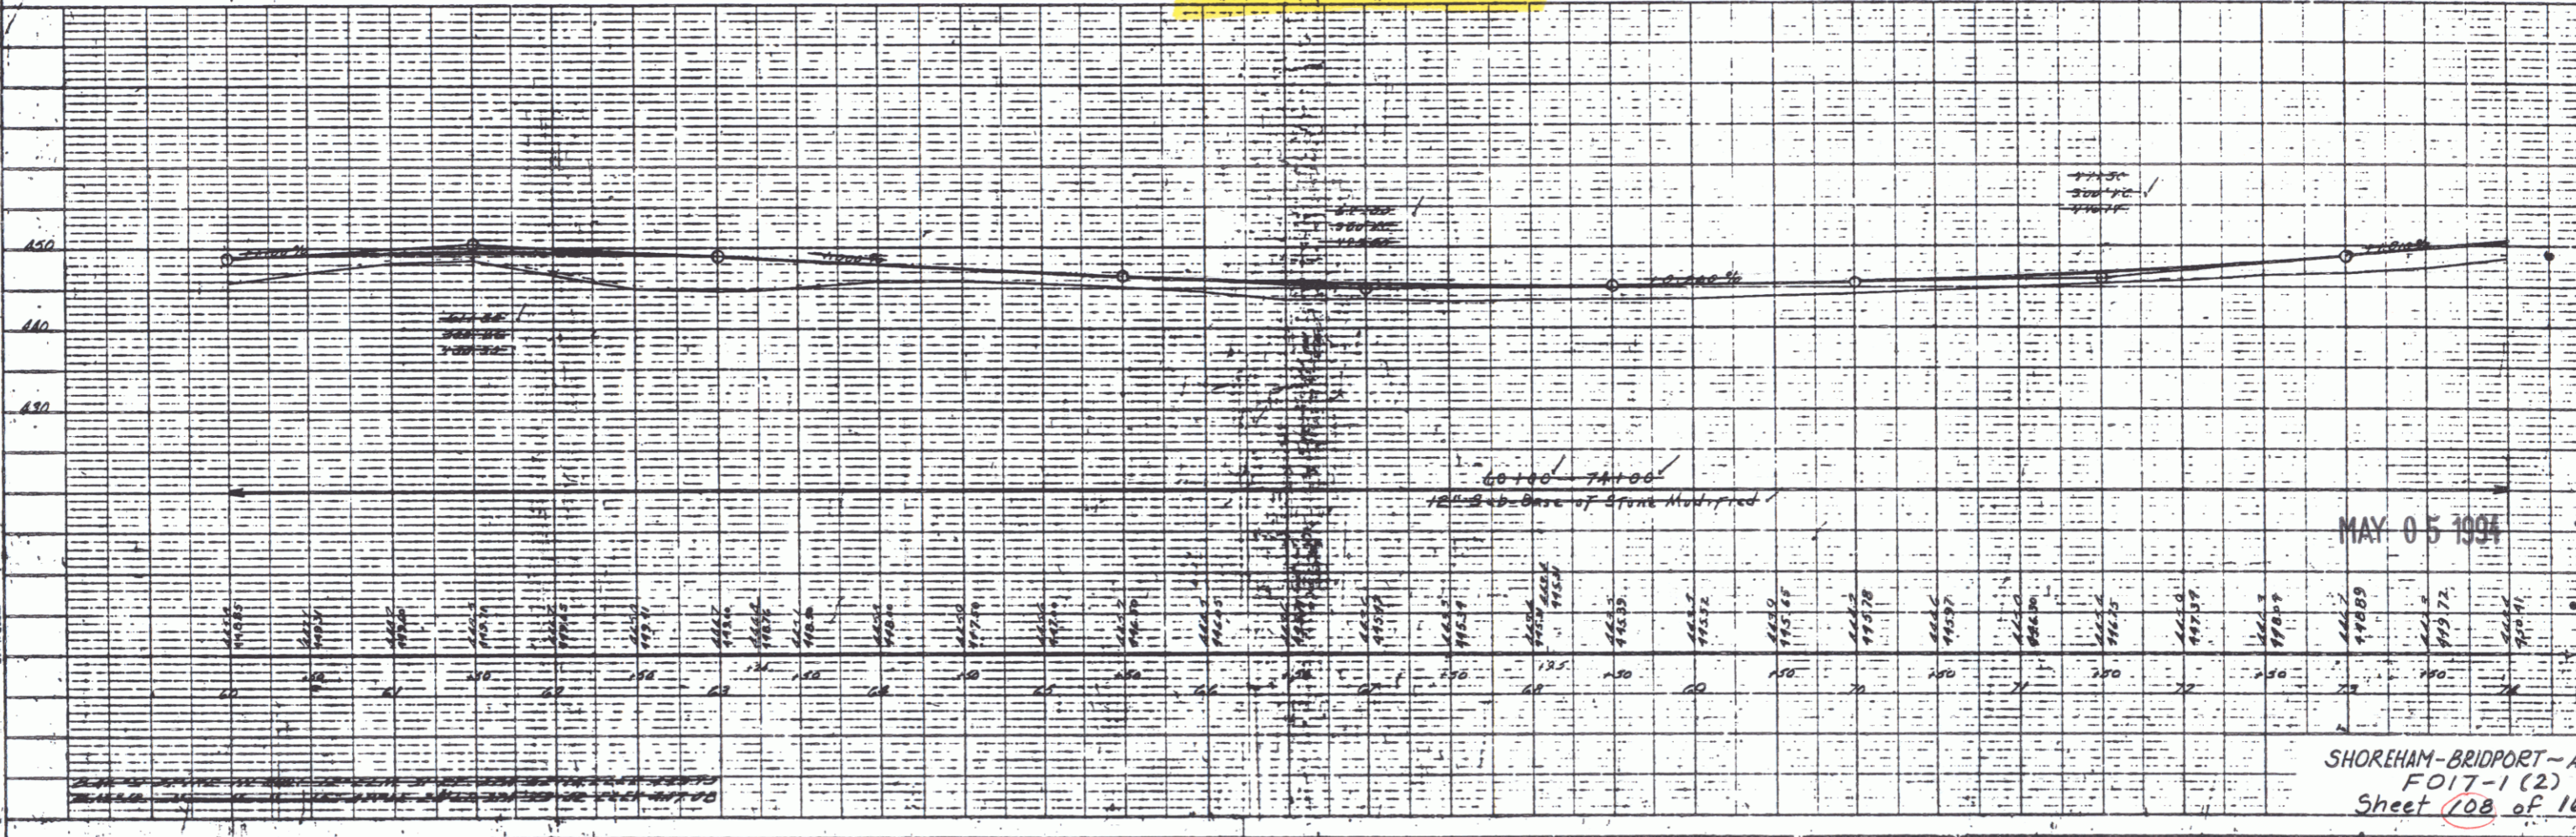

SHOREHAM-BRIDPORT-ADDISON
FO 17-1 (2)
Sheet 108 of 165 29