
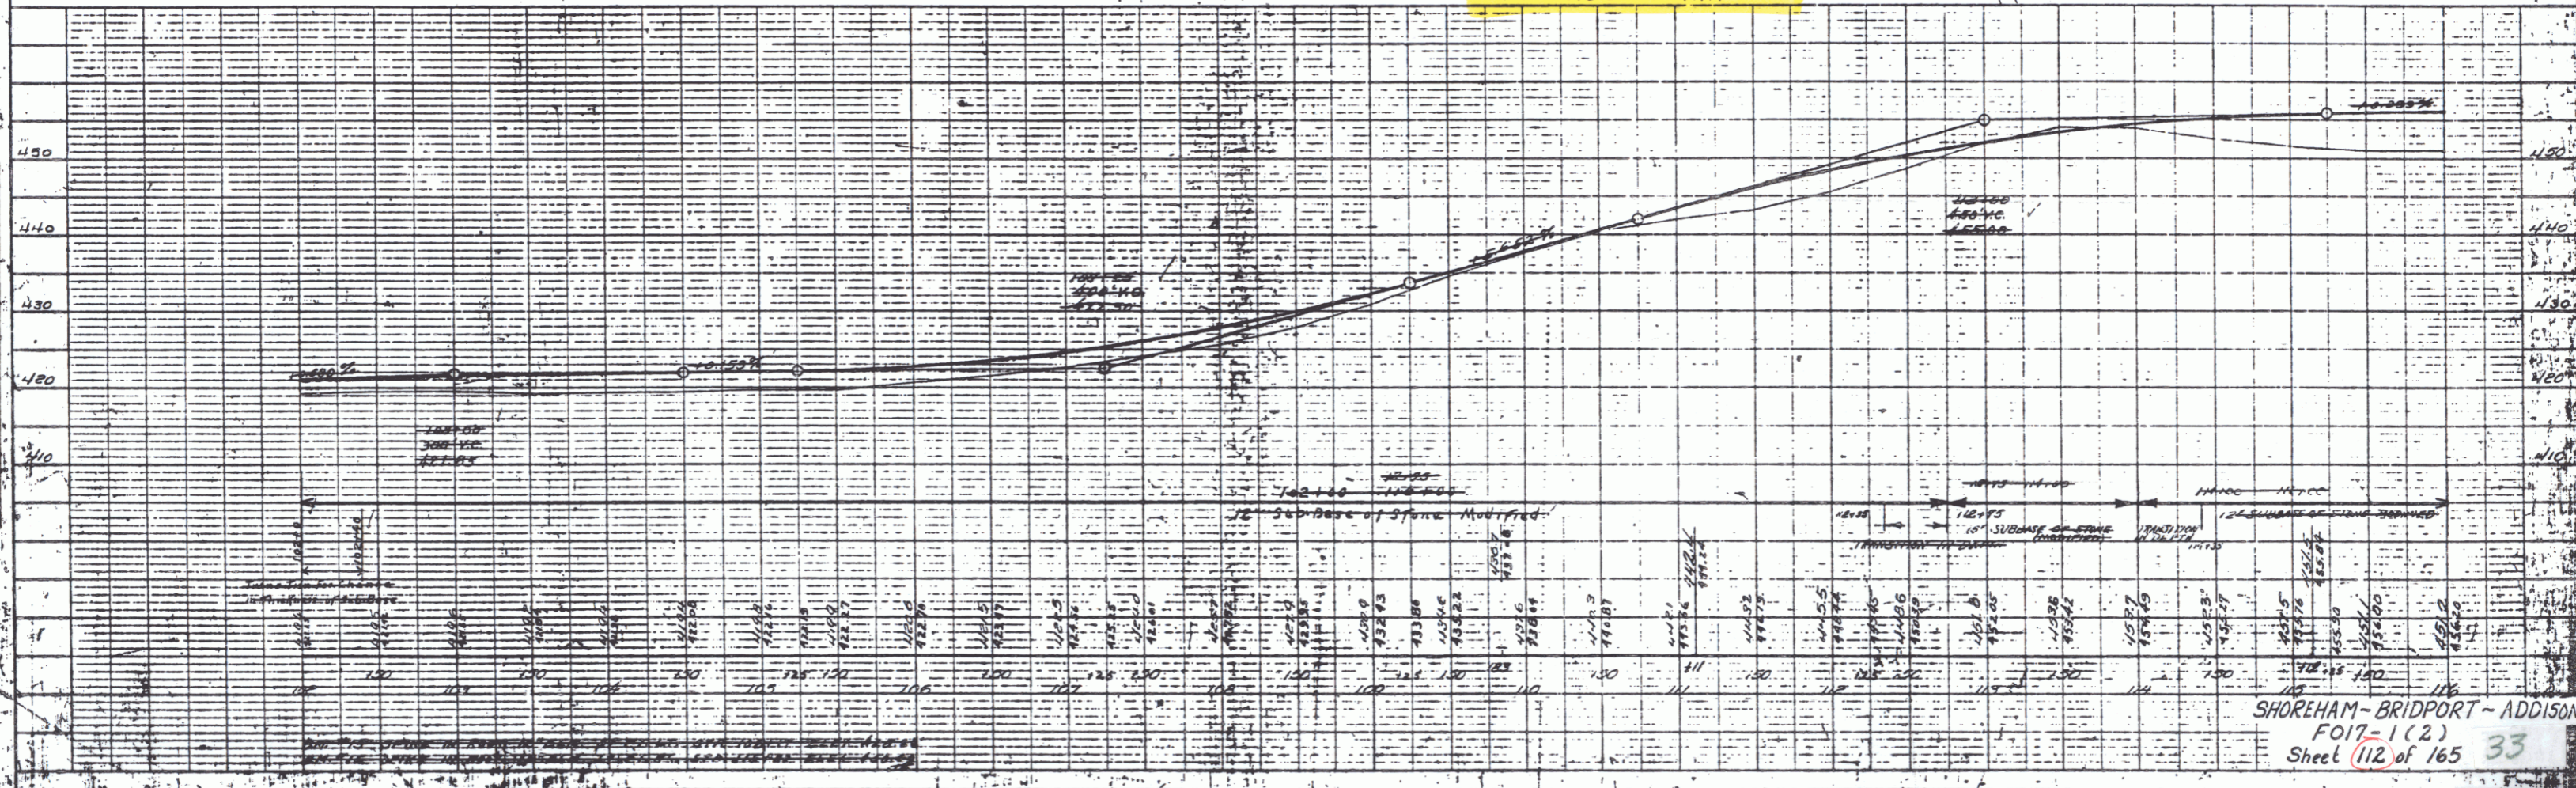


PLAN
 DATE
 DRAWN BY
 CHECKED BY
 IN CHARGE

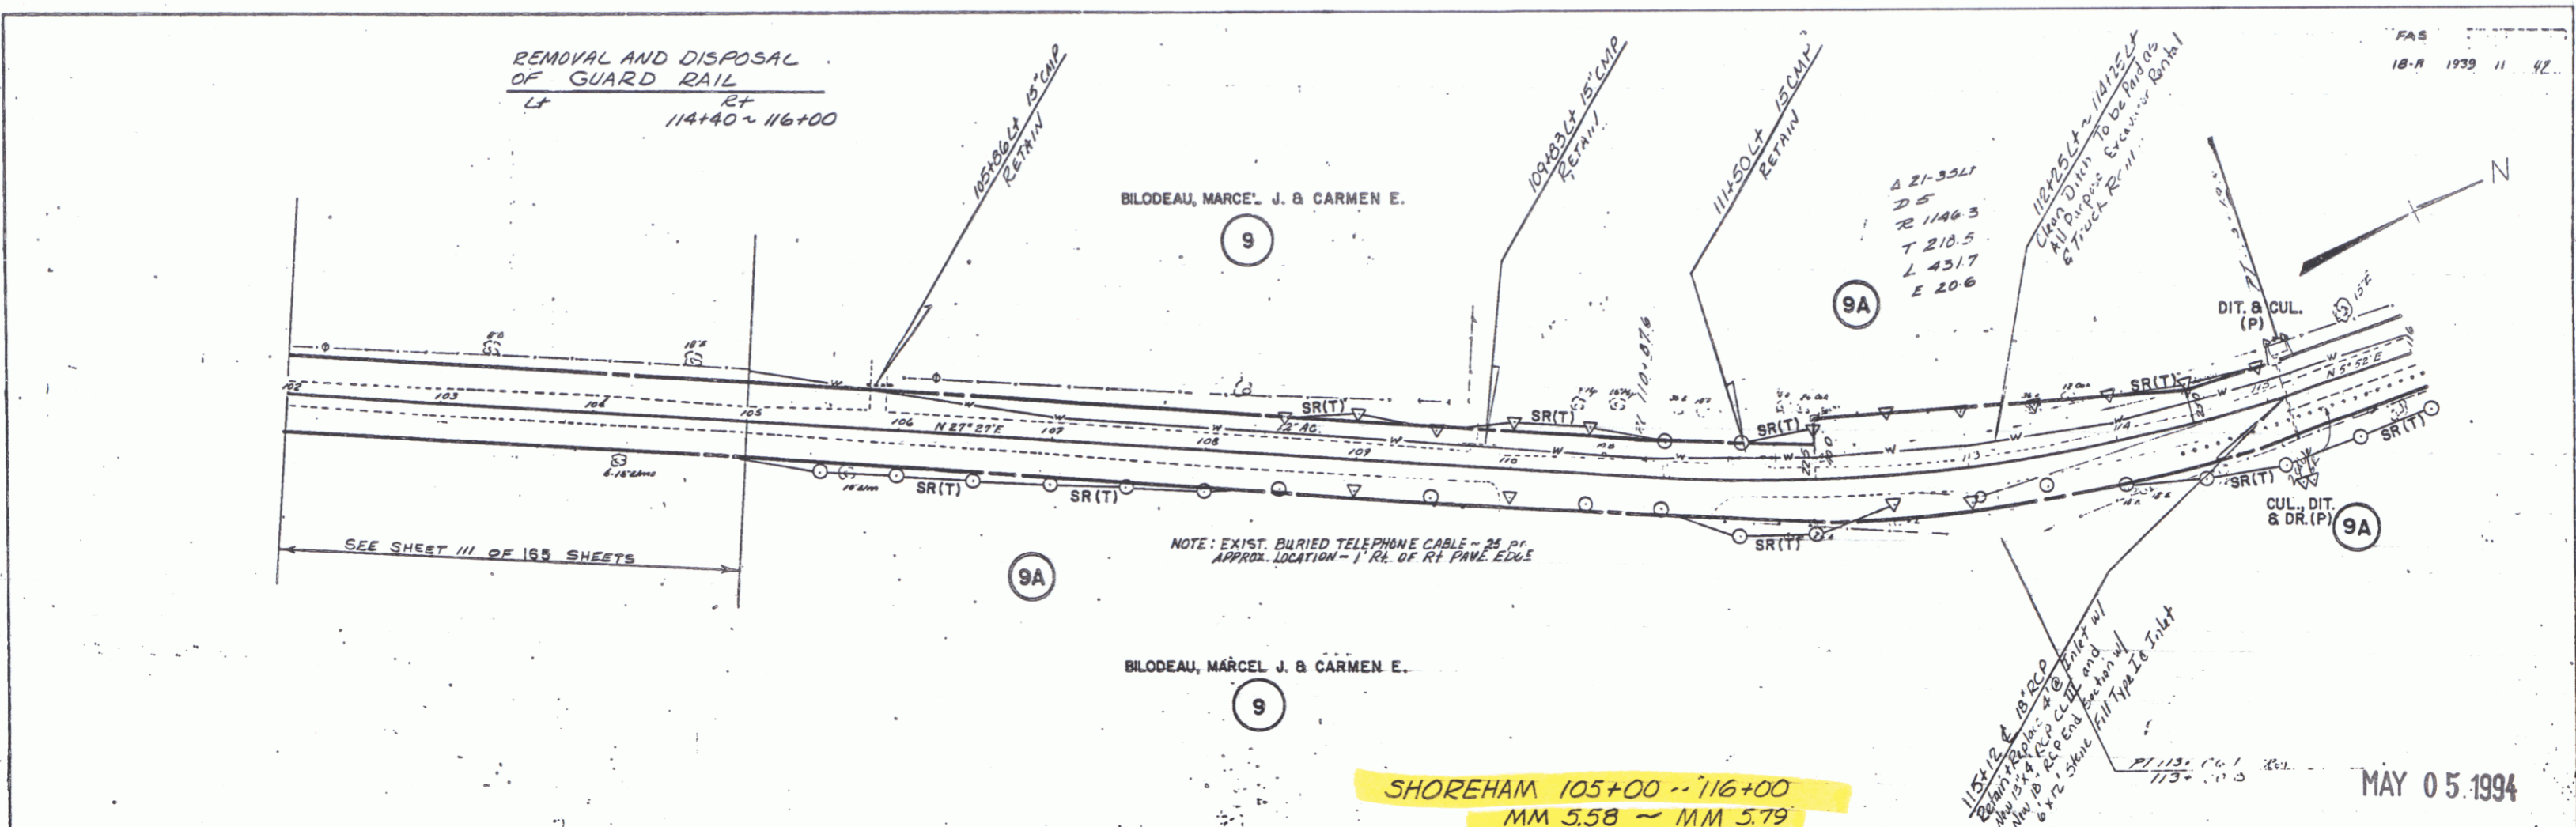

SHOREHAM - BRIDPORT - ADDISON
 FO17-1(2)
 Sheet 112 of 165 33