
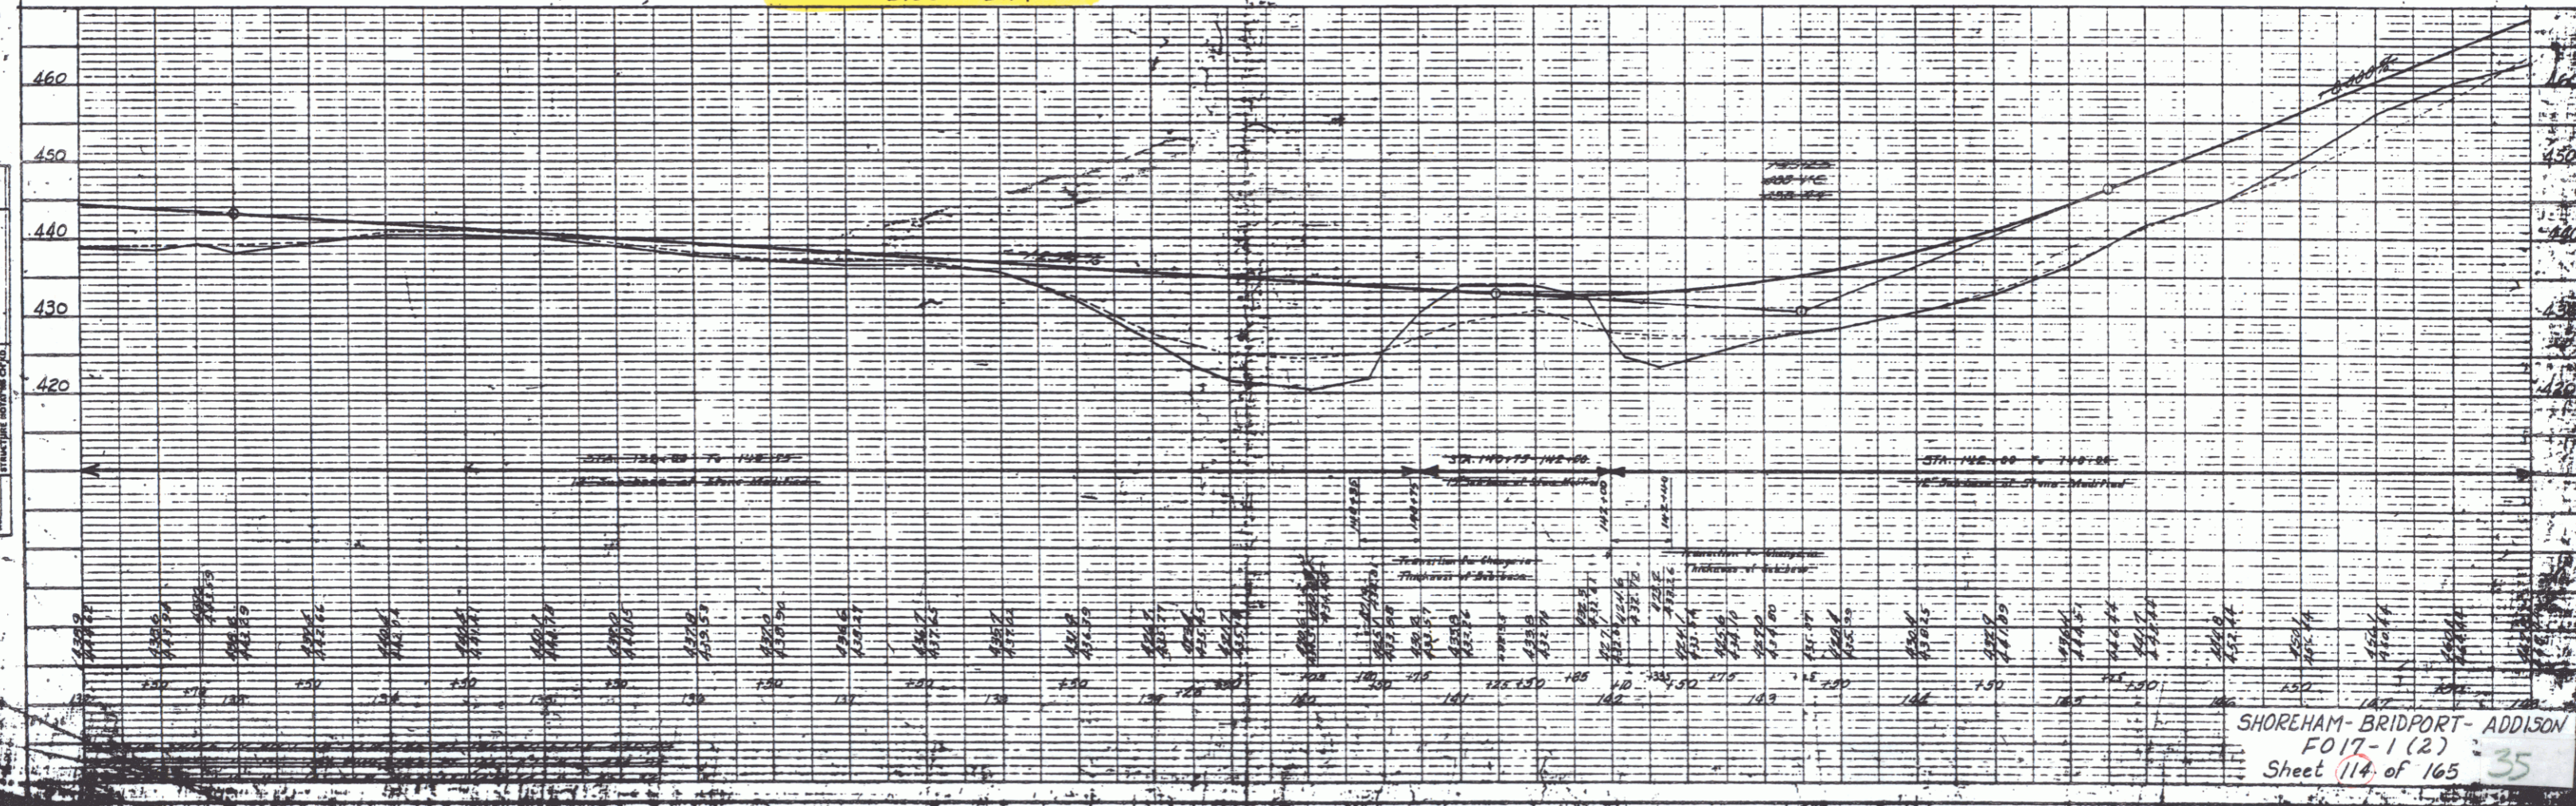


PLAN
 CONTROL
 CHECKED
 DATE
 BY
 REVISIONS
 NO. DATE BY

DATE
 BY
 REVISIONS
 NO. DATE BY

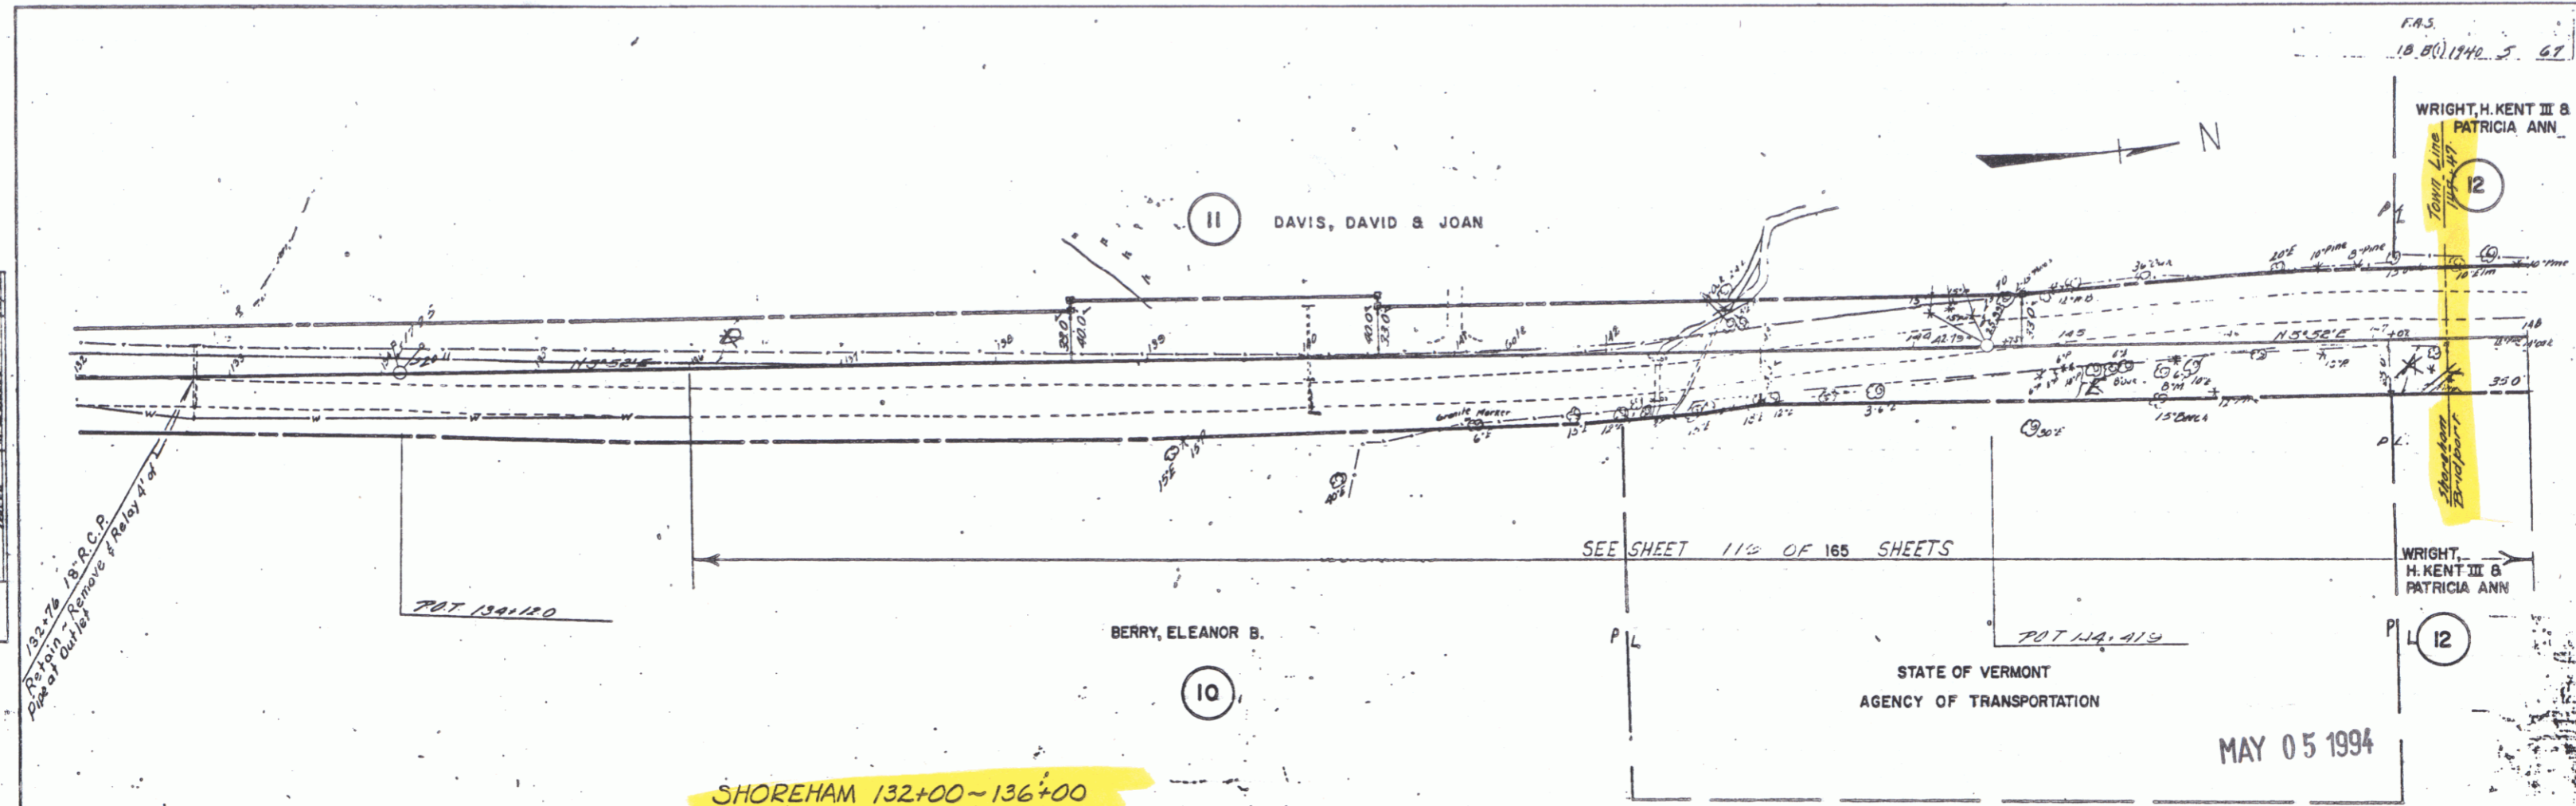

SHOREHAM-BRIDPORT-ADDISON
 FO 17-1 (2)
 Sheet 114 of 165 35