
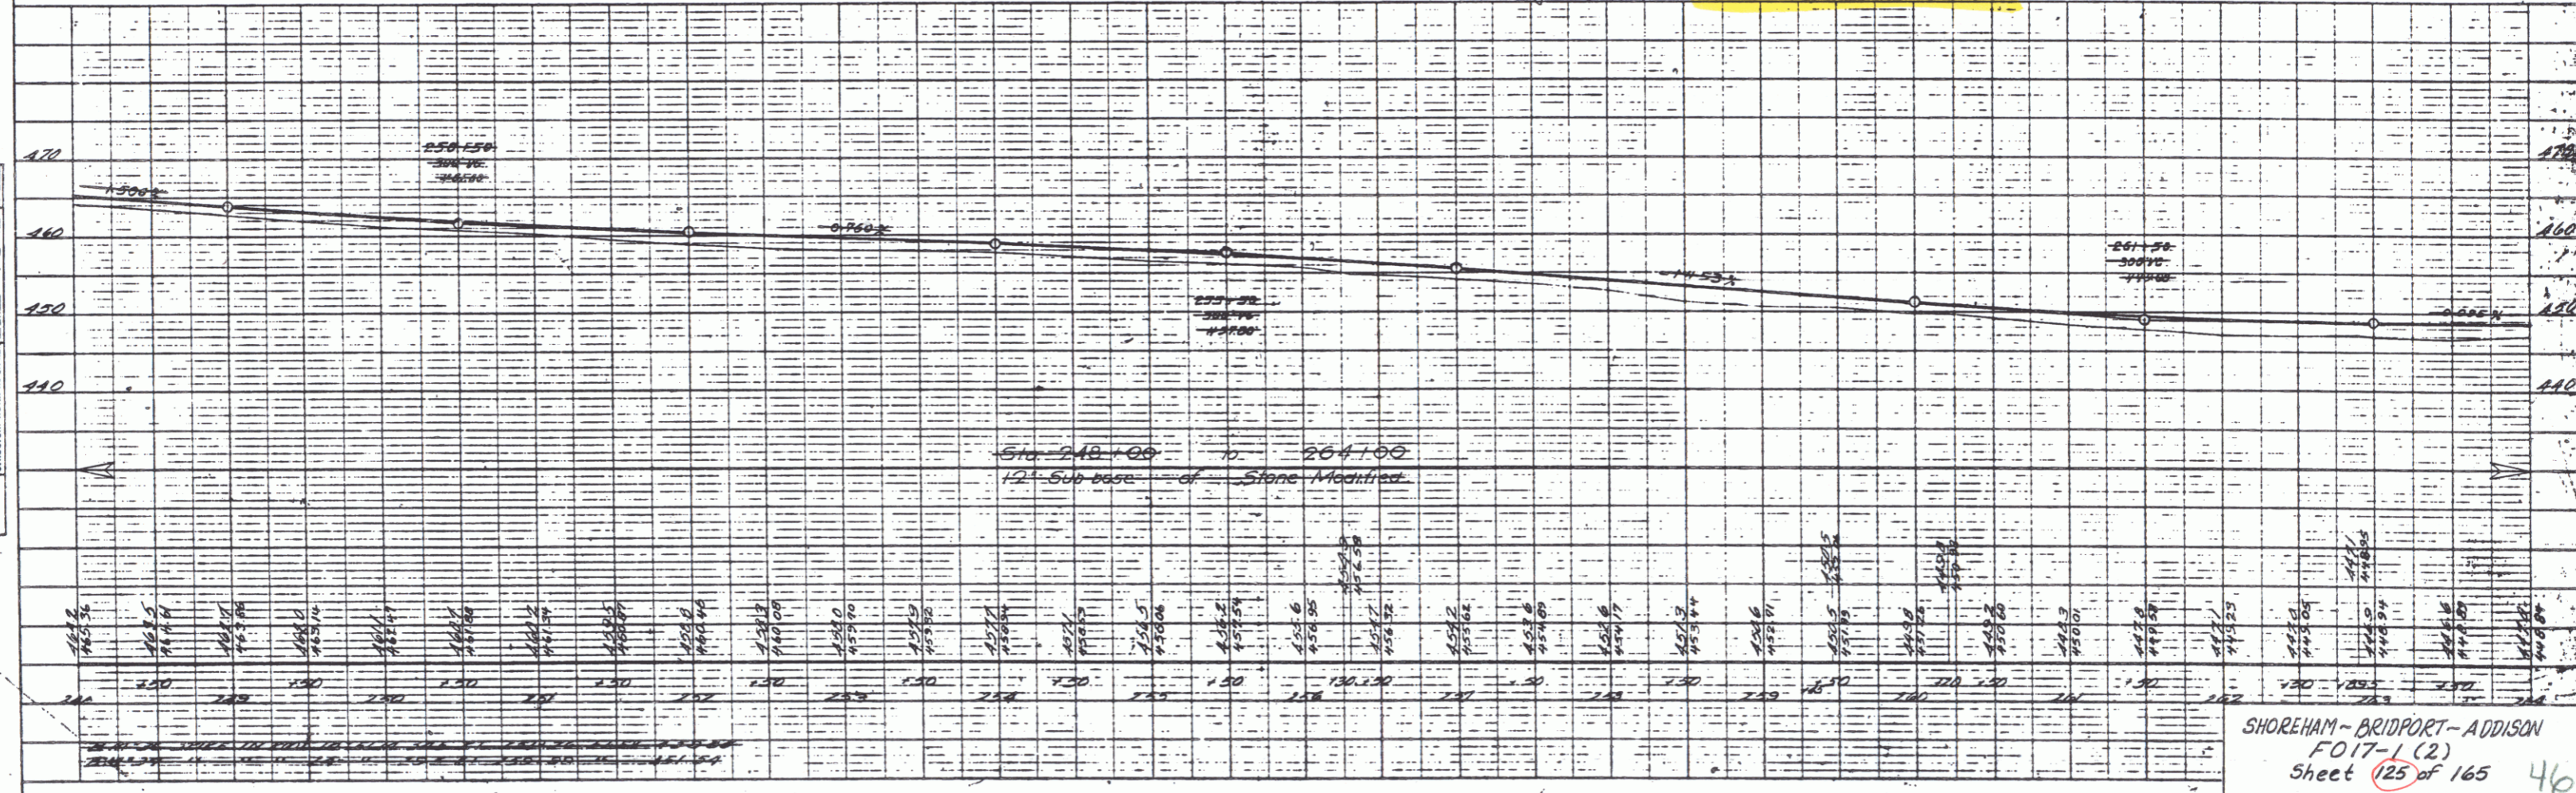


DATE	10/1/94
BY	J.P. [Signature]
CHECKED	[Signature]
SCALE	AS SHOWN
PROJECT	SHOREHAM - BRIDPORT - ADDISON
NO.	FO17-1(2)
SHEET	125 of 165

DATE	10/1/94
BY	J.P. [Signature]
CHECKED	[Signature]
SCALE	AS SHOWN
PROJECT	SHOREHAM - BRIDPORT - ADDISON
NO.	FO17-1(2)
SHEET	125 of 165

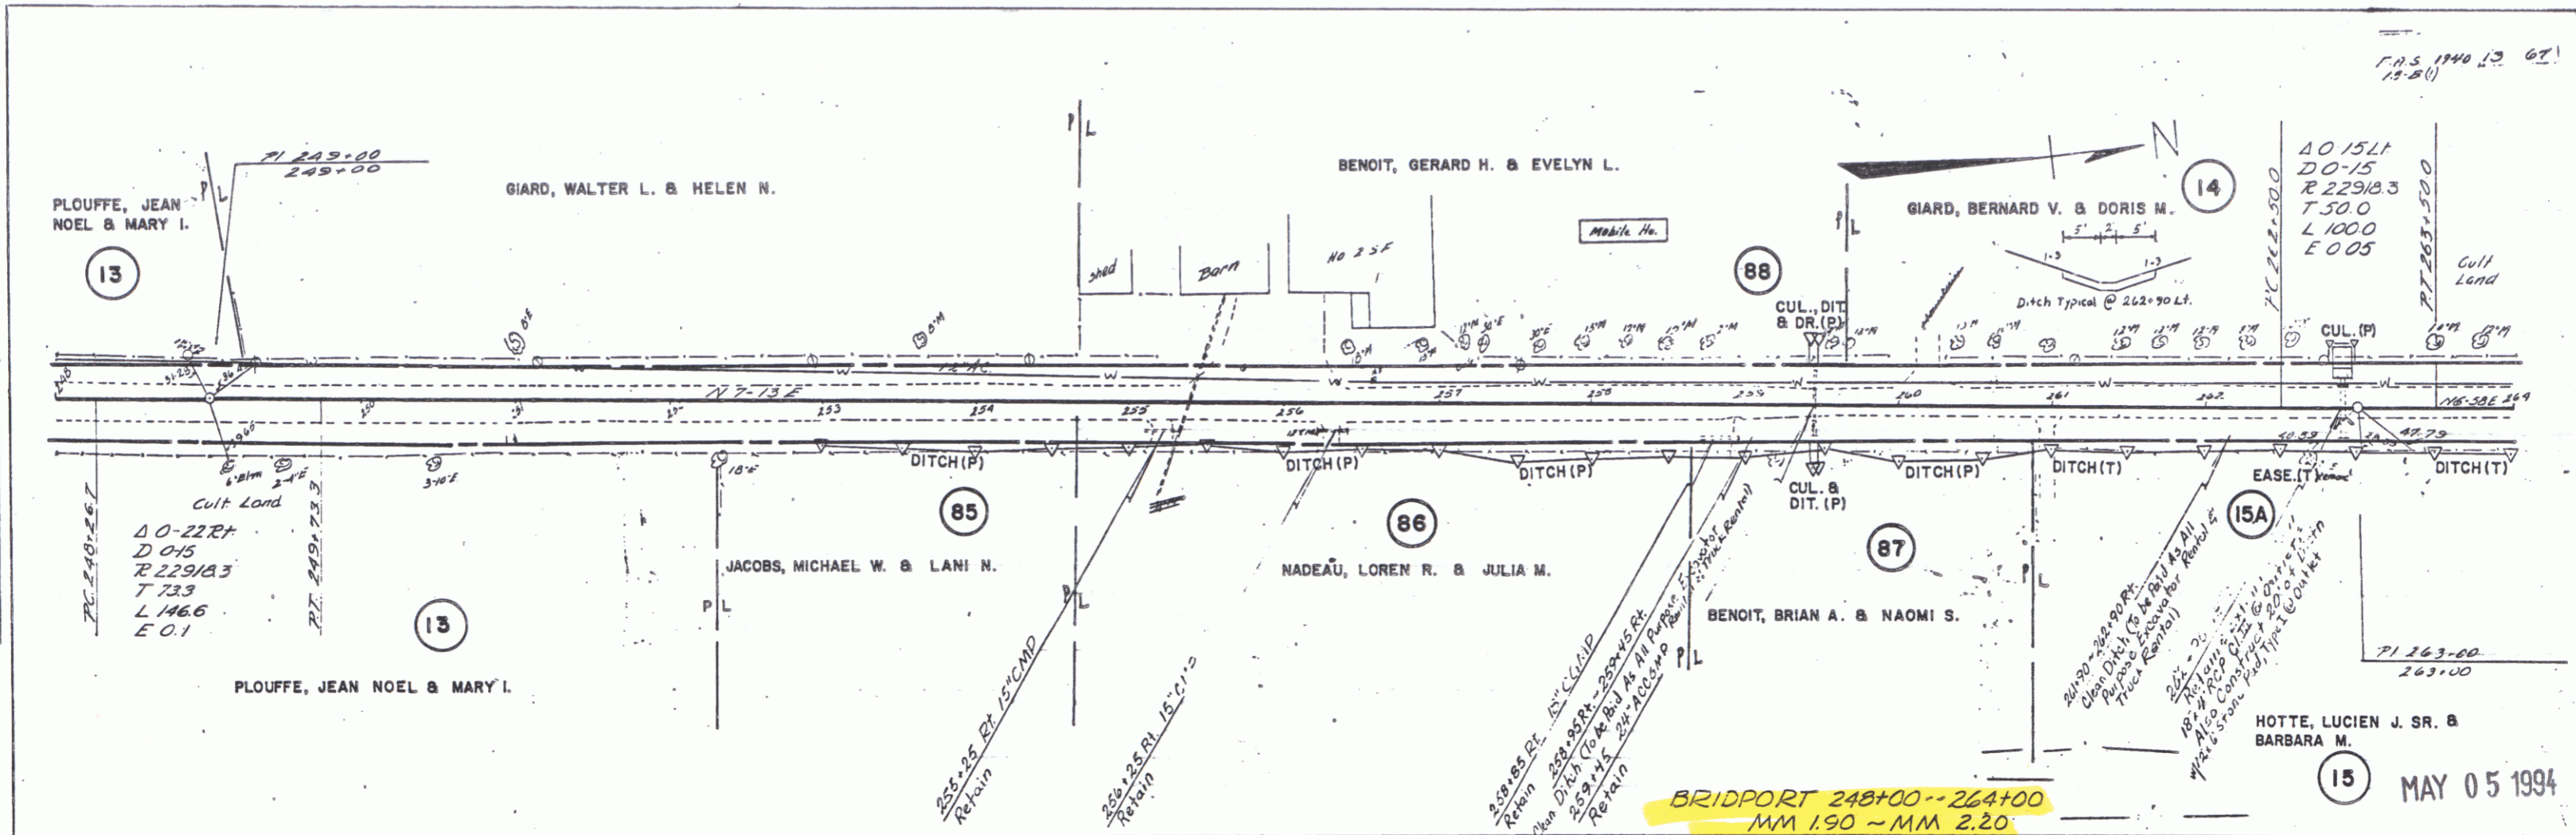

SHOREHAM - BRIDPORT - ADDISON
FO17-1(2)
Sheet 125 of 165 46

PLANNING - PROFILE & PAVEMENT
SCALE: 1" = 40' VERT. 1" = 40' HORIZ.