


PLAN  
 DATE: 10/15/93  
 DRAWN BY: J. J. BREEZ  
 CHECKED BY: J. J. BREEZ  
 PROJECT: SHOREHAM-BRIDPORT-ADDISON  
 SHEET NO. 126 OF 165

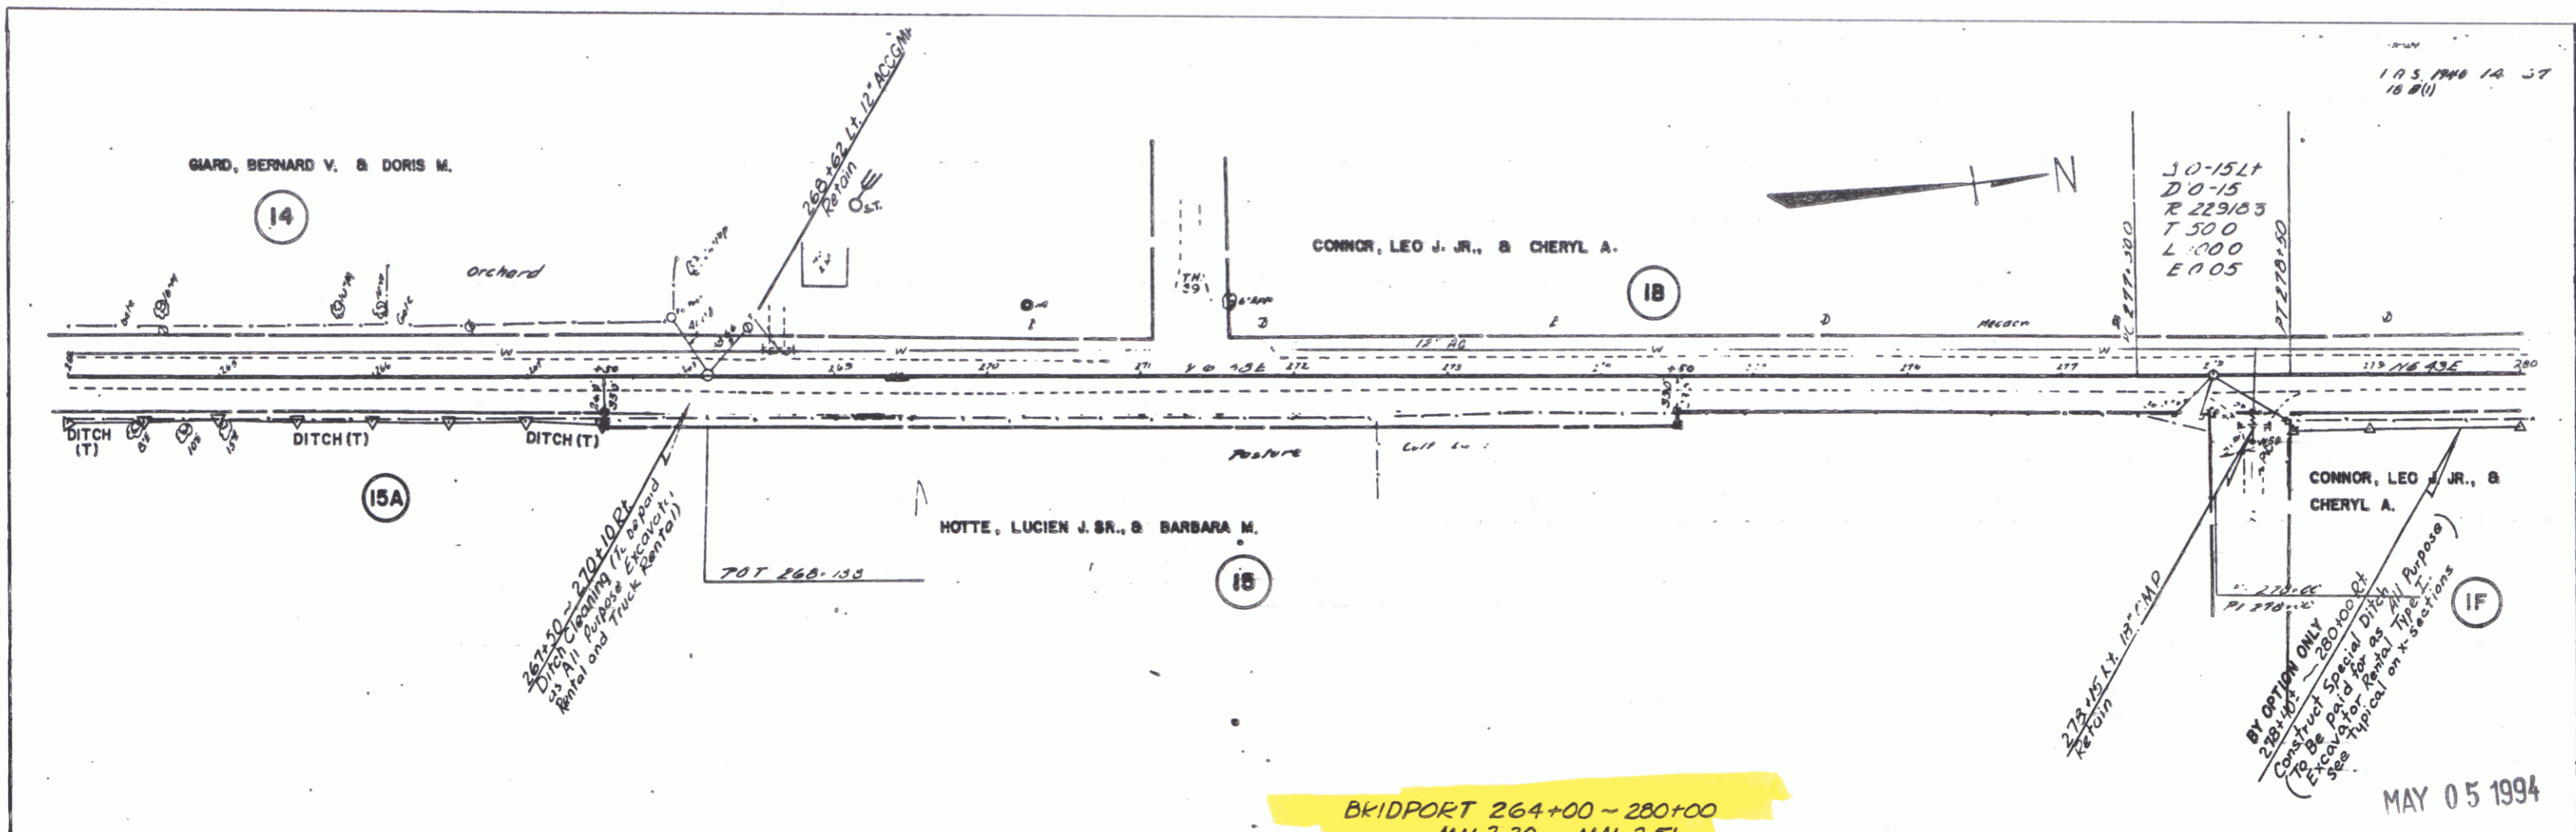

PROFILE  
 DATE: 10/15/93  
 DRAWN BY: J. J. BREEZ  
 CHECKED BY: J. J. BREEZ  
 PROJECT: SHOREHAM-BRIDPORT-ADDISON  
 SHEET NO. 126 OF 165

