



PLM	DATE	BY	CHKD
10/1/94	10/1/94	10/1/94	10/1/94
10/1/94	10/1/94	10/1/94	10/1/94
10/1/94	10/1/94	10/1/94	10/1/94
10/1/94	10/1/94	10/1/94	10/1/94

PLM	DATE	BY	CHKD
10/1/94	10/1/94	10/1/94	10/1/94
10/1/94	10/1/94	10/1/94	10/1/94
10/1/94	10/1/94	10/1/94	10/1/94
10/1/94	10/1/94	10/1/94	10/1/94

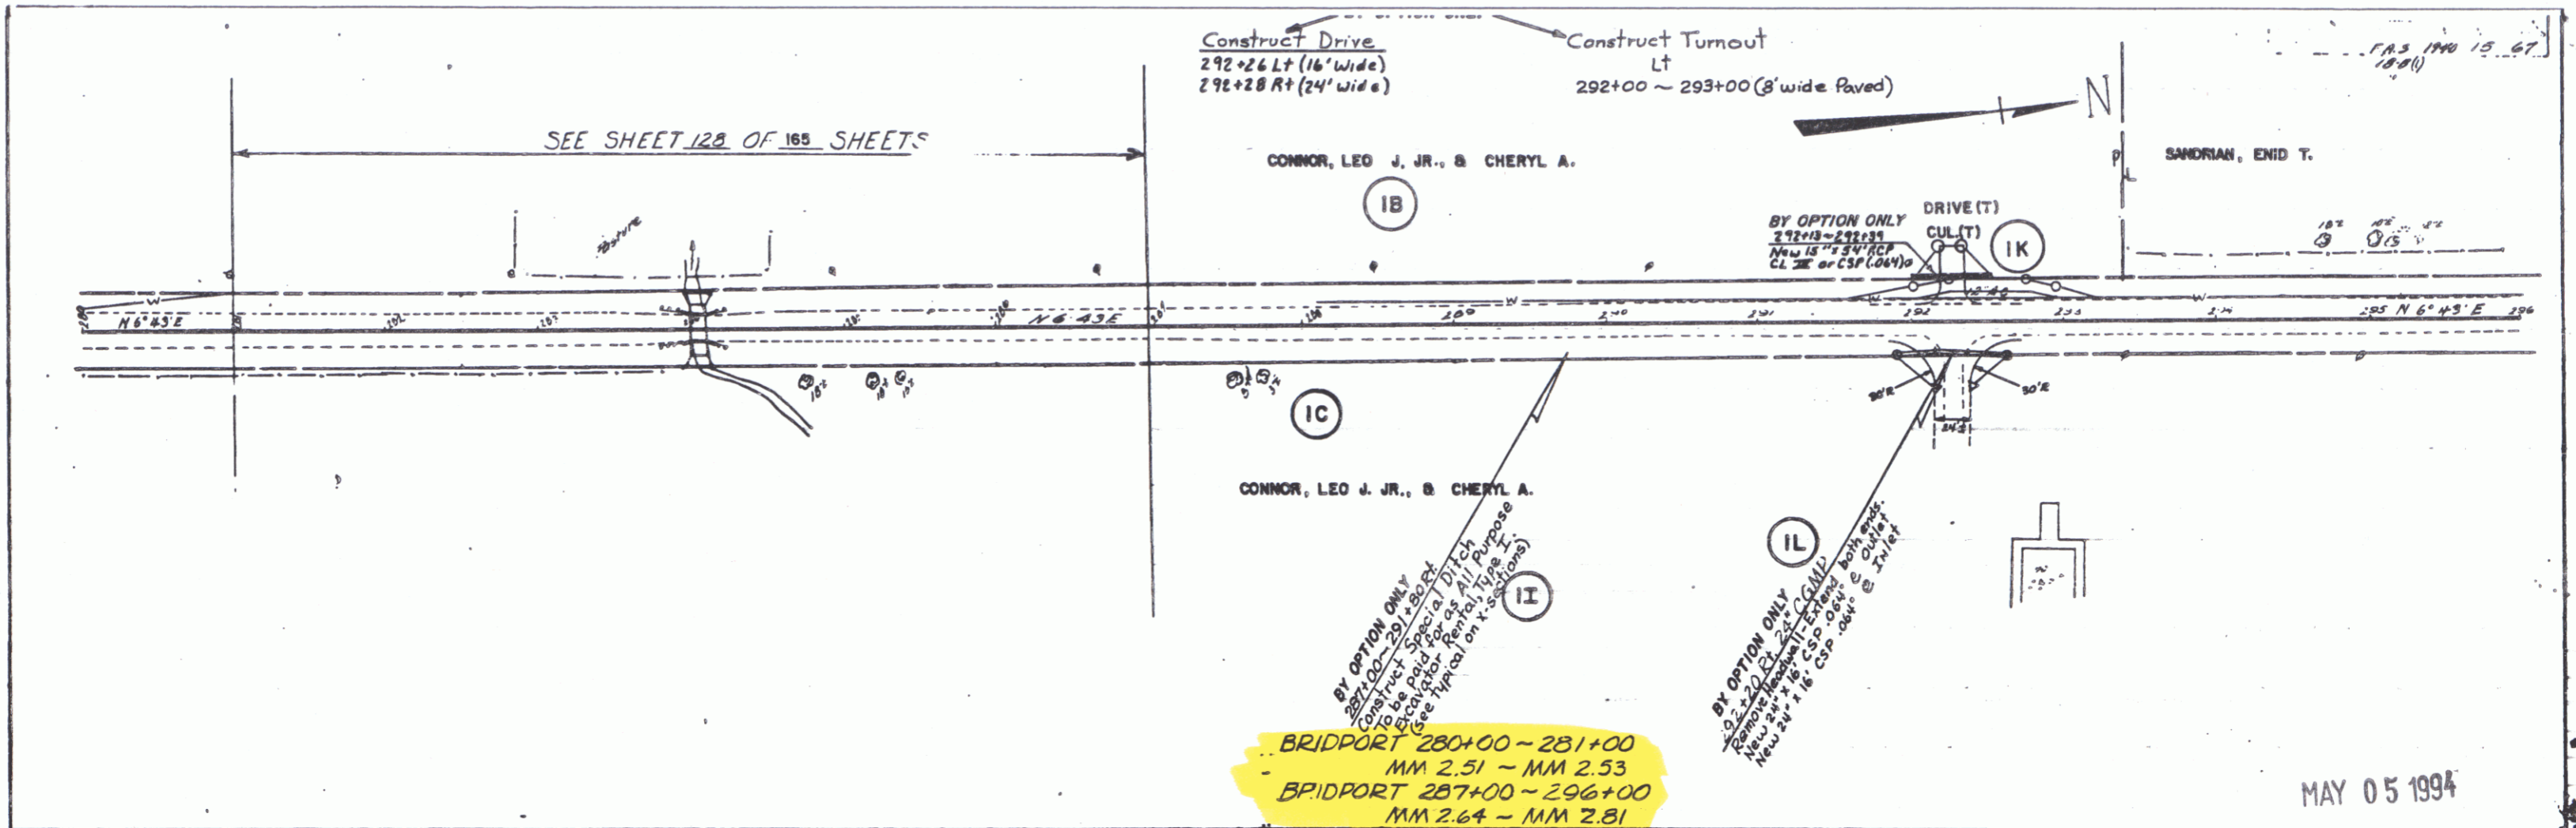

BRIDPORT 280+00 ~ 281+00
 MM 2.51 ~ MM 2.53
 BRIDPORT 287+00 ~ 296+00
 MM 2.64 ~ MM 2.81

MAY 05 1994

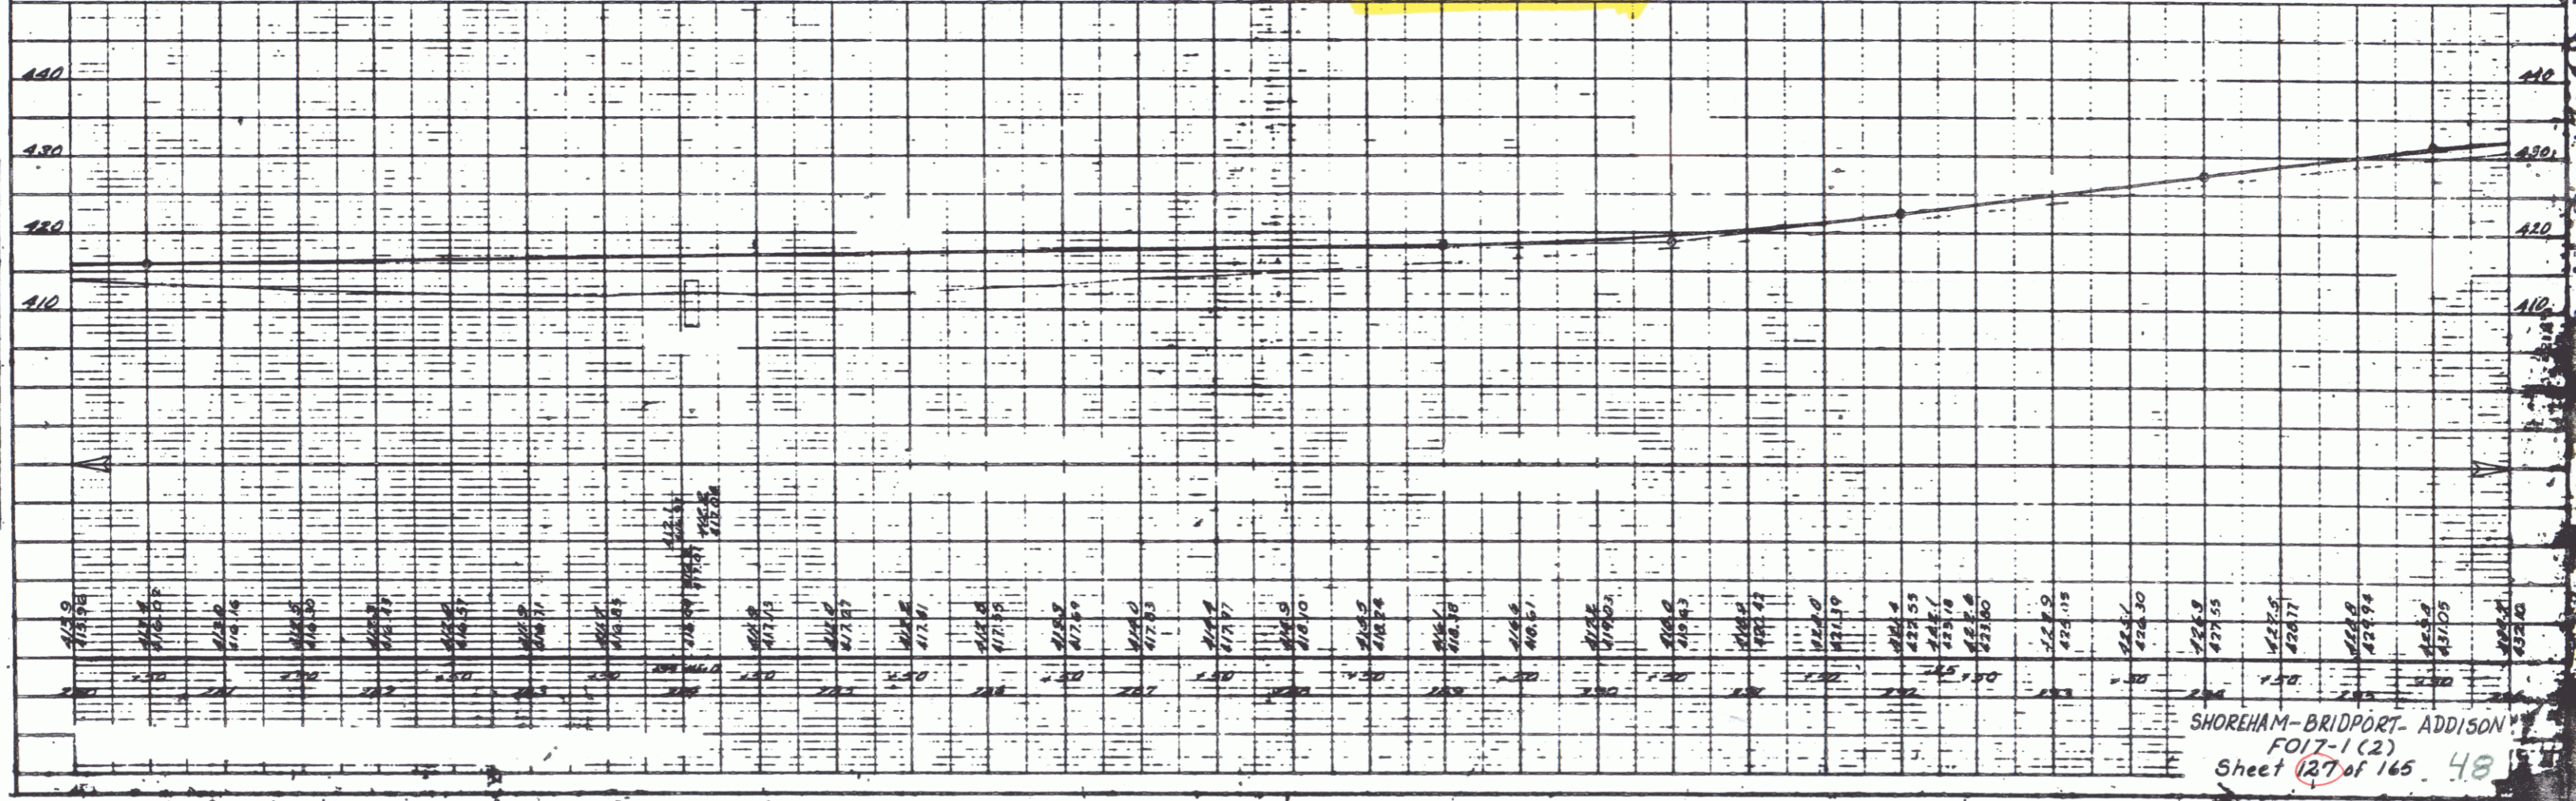

SHOREHAM-BRIDPORT-ADDISON
 FO17-1(2)
 Sheet 127 of 165 48