



DATE: 5/15/94  
 BY: [Signature]  
 CHECKED: [Signature]  
 PLAN  
 SURVEILED: [Signature]  
 PLANNED: [Signature]  
 DRAWN: [Signature]  
 NO. 134

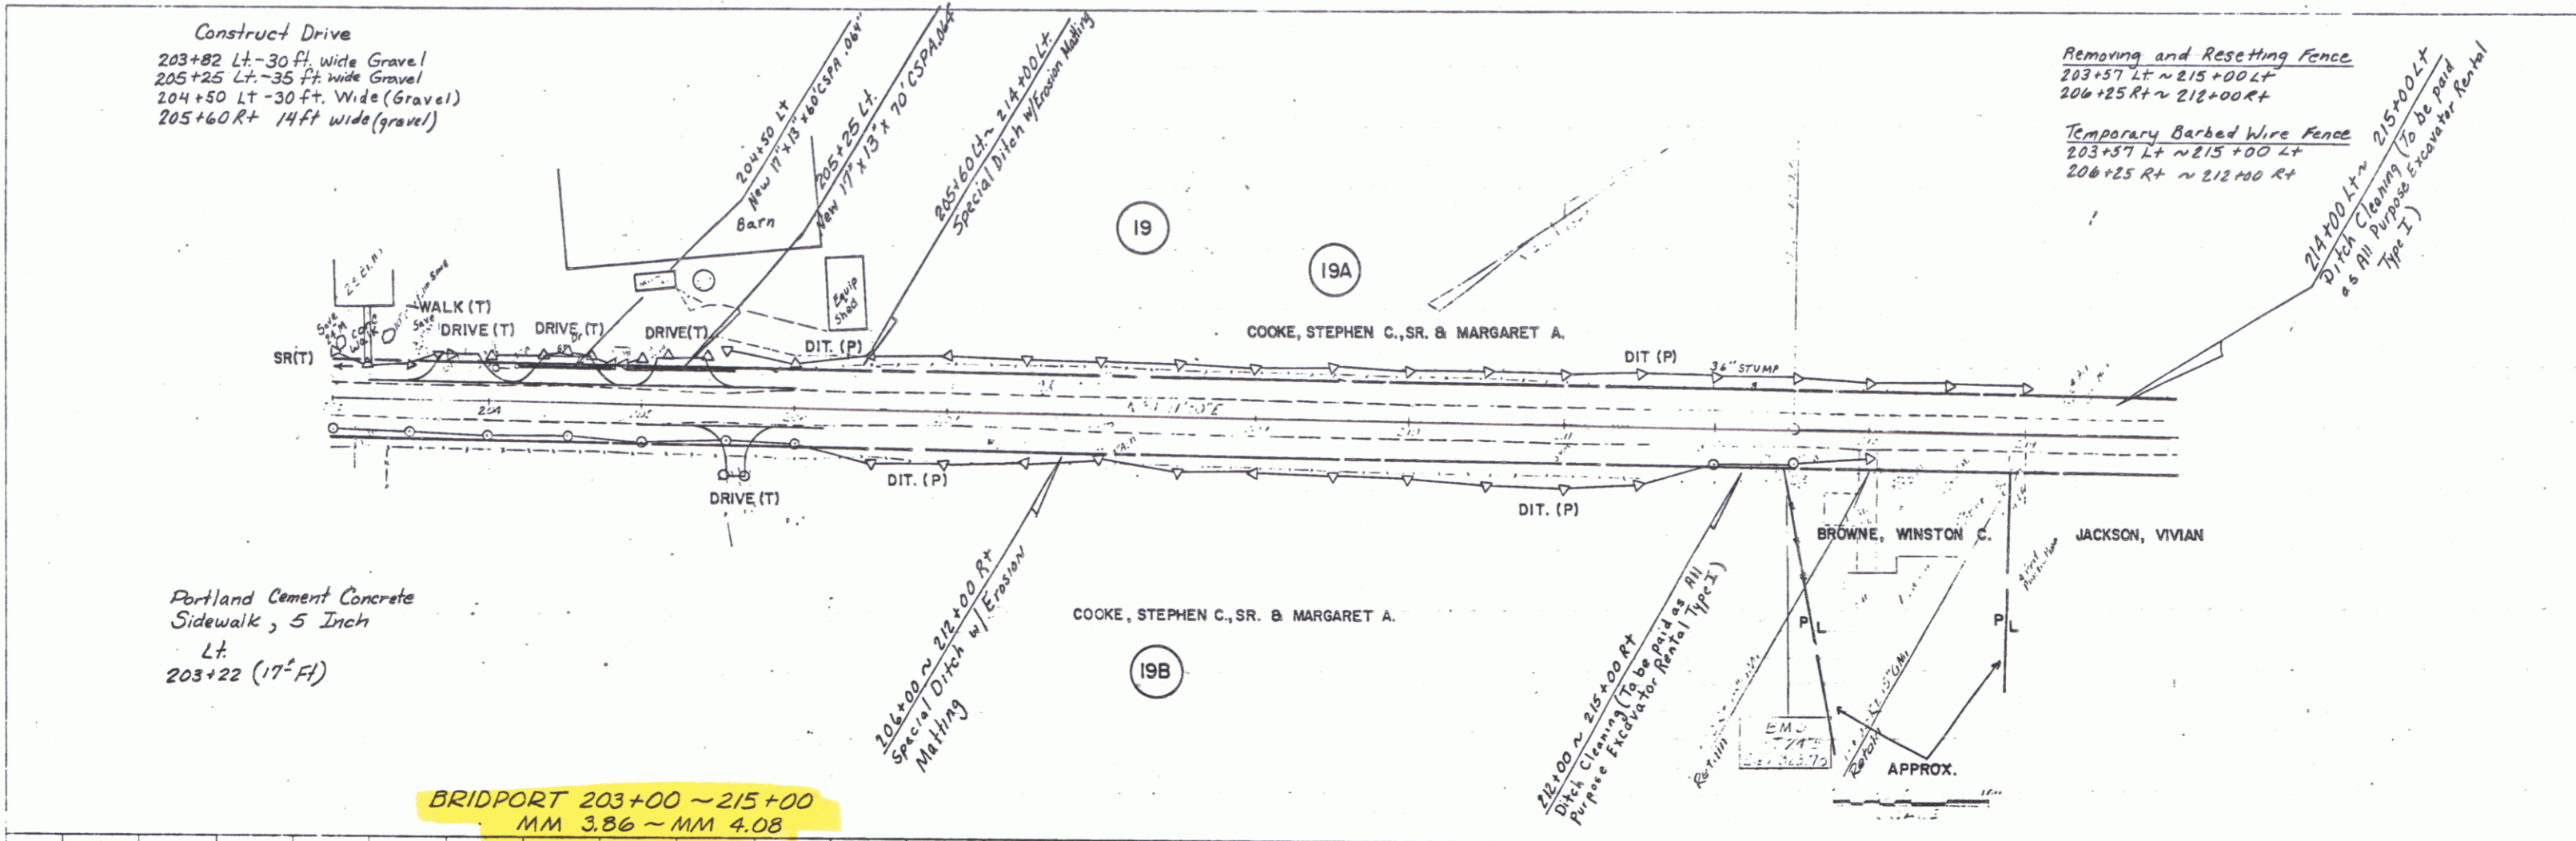

BRIDPORT 203+00 ~ 215+00  
 MM 3.86 ~ MM 4.08

DATE: 5/15/94  
 BY: [Signature]  
 CHECKED: [Signature]  
 PROFILE  
 SURVEILED: [Signature]  
 PLANNED: [Signature]  
 DRAWN: [Signature]  
 NO. 134

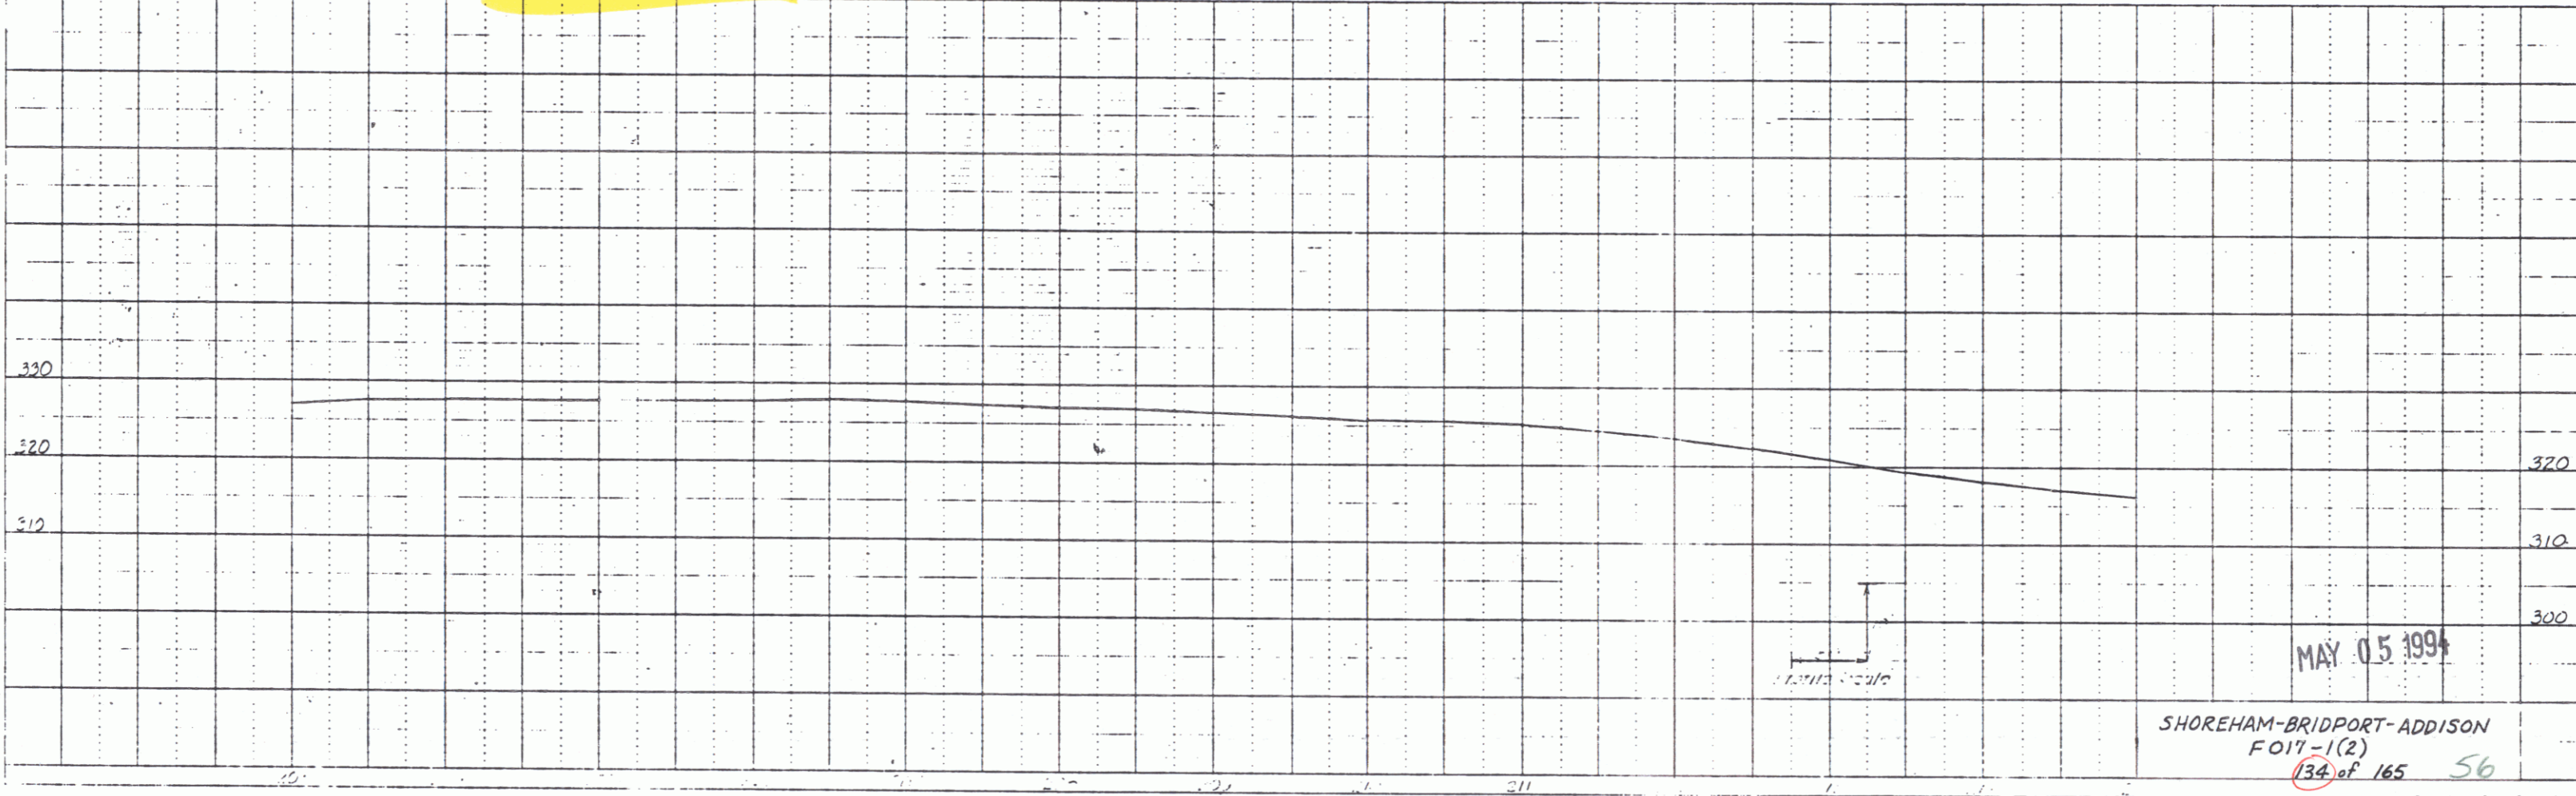

MAY 05 1994

SHOREHAM-BRIDPORT-ADDISON  
 FO17-1(2)  
 134 of 165 56