

DATE: 5/1/94
 BY: JAV/SM
 CHECKED: JAV/SM
 IN CHARGE: JAV/SM

PLAN
 SHEET NO. 136 OF 165

DATE: 5/1/94
 BY: JAV/SM
 CHECKED: JAV/SM
 IN CHARGE: JAV/SM

PROFILE
 SHEET NO. 136 OF 165

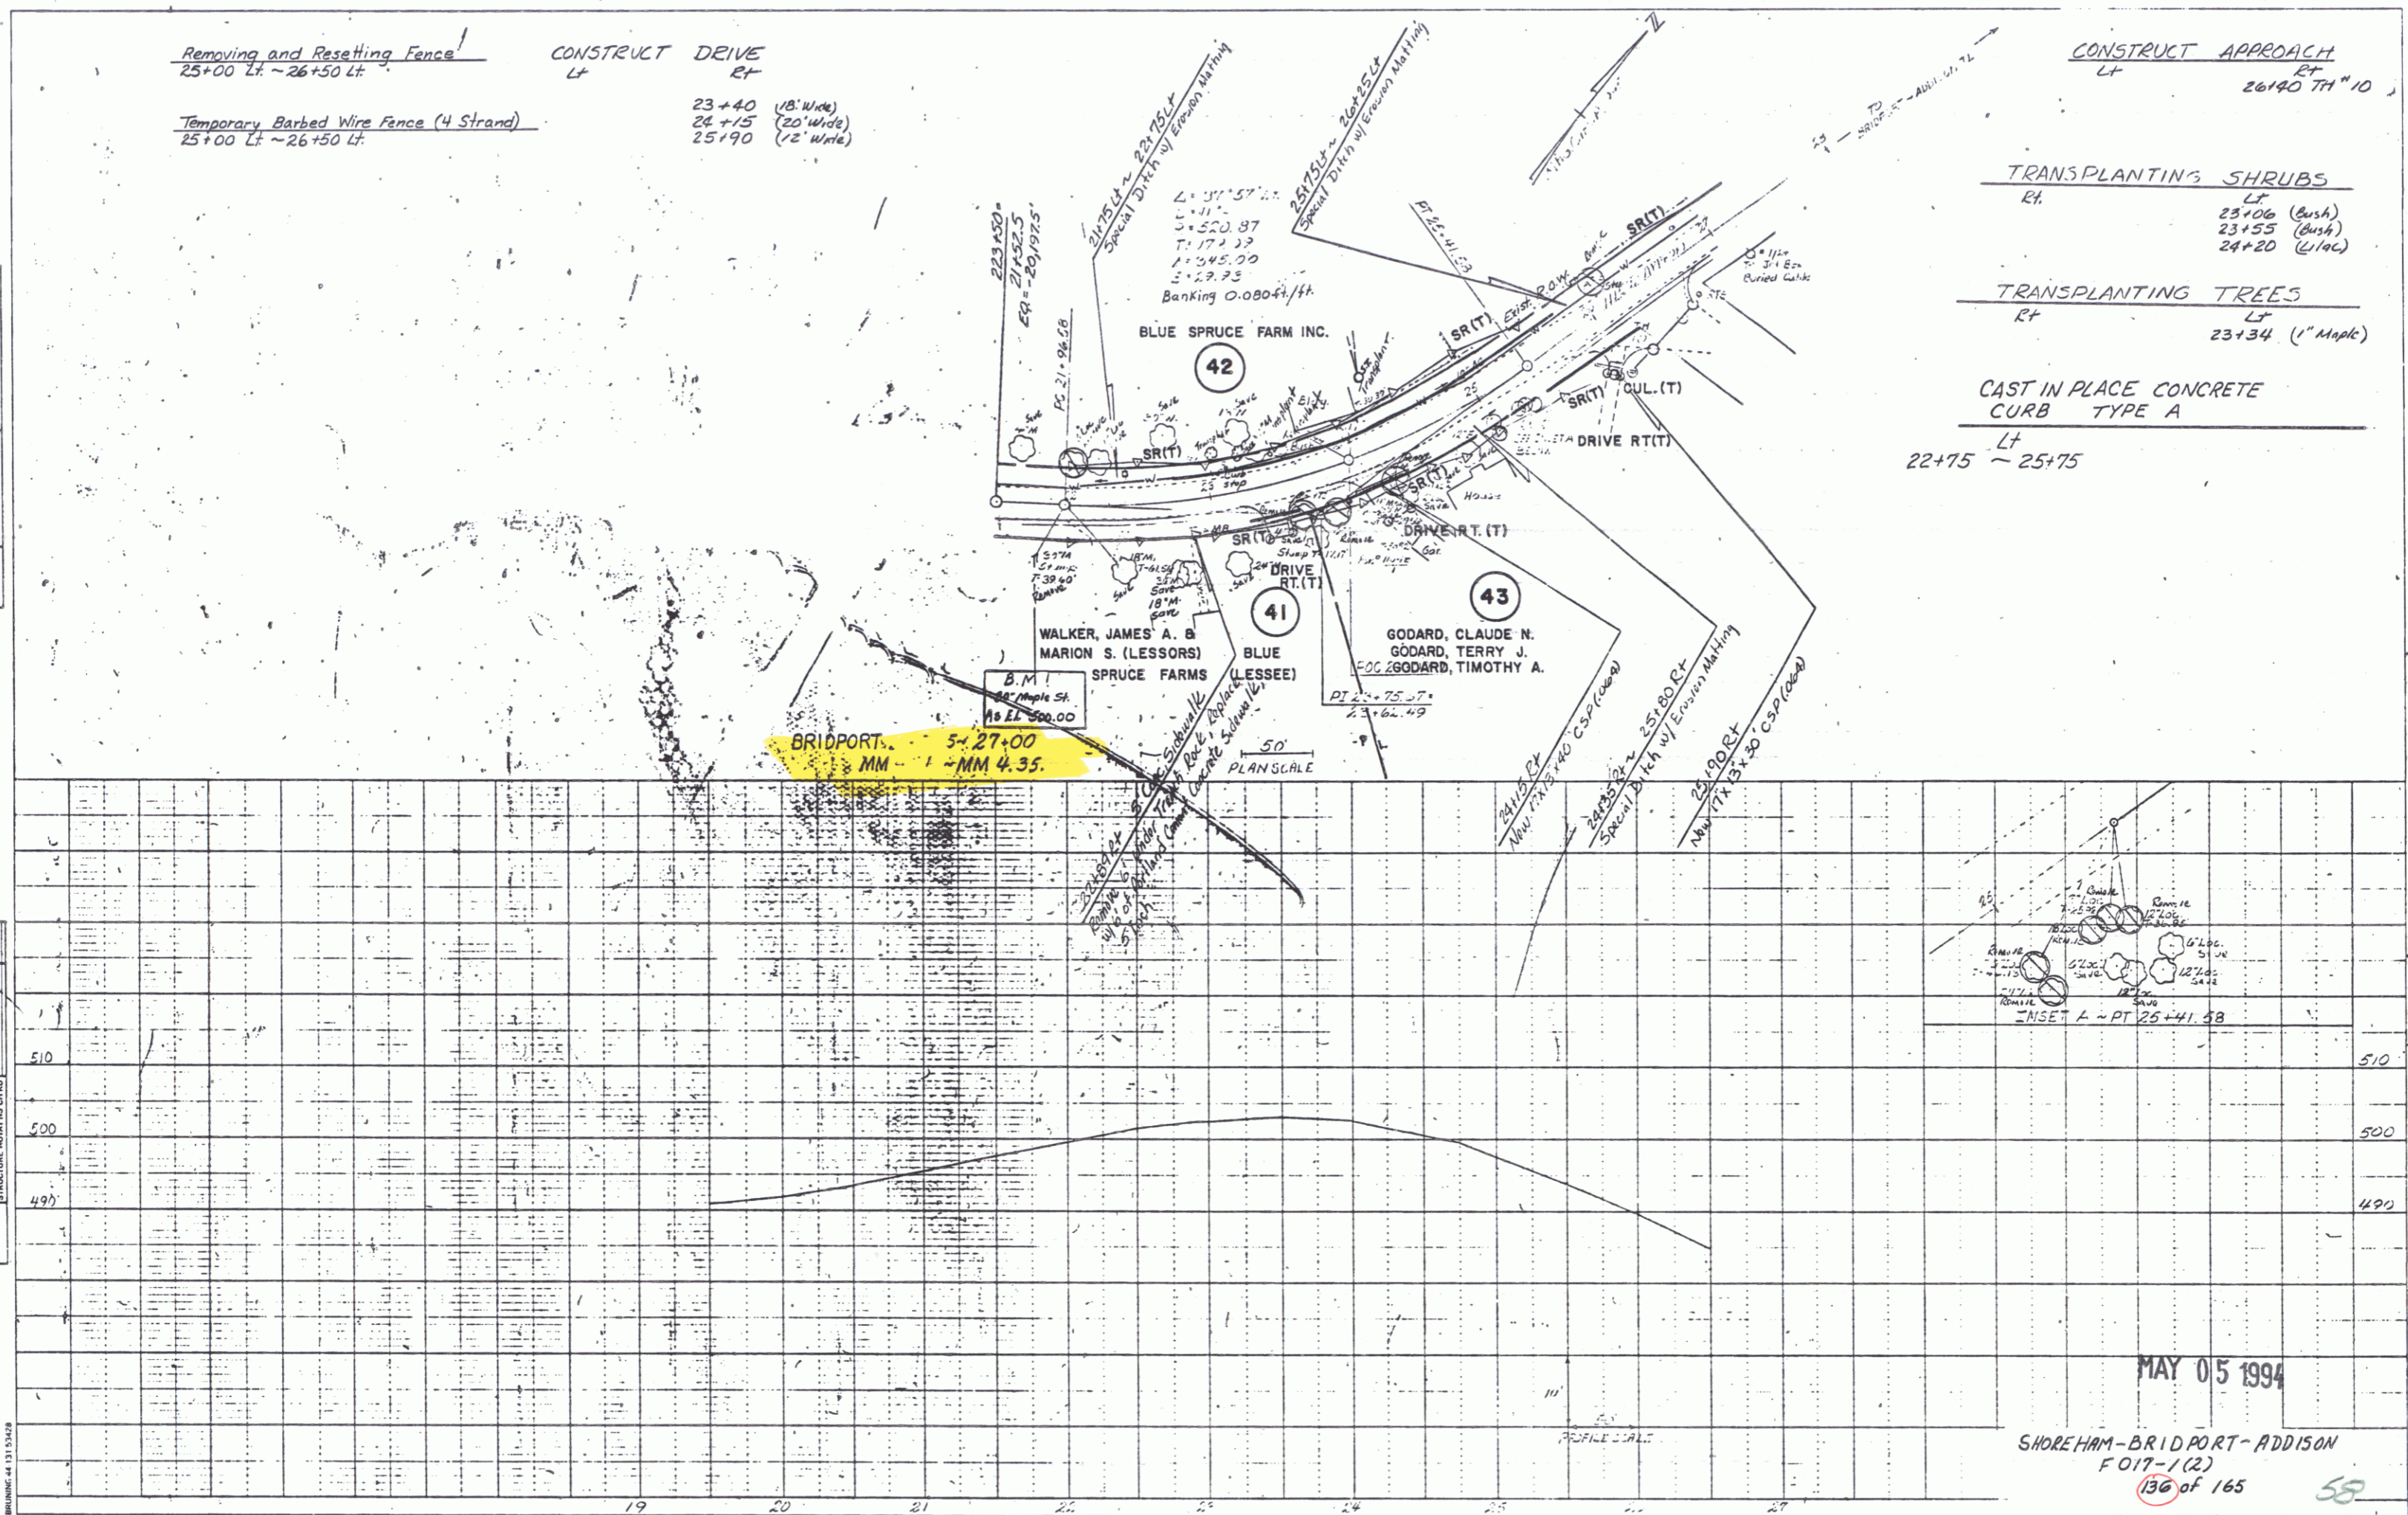


PLATE 1 SINGLE PLAN - PROFILE

MAY 05 1994
 SHOREHAM-BRIDPORT-ADDISON
 F017-1(2)
 136 of 165