


PLAN	SUBMITTED	DATE
	BY	5-1-84
PLAN	ALIGNED CHECKED	BY
	BY	ECT
PLAN	BY	
	BY	

PROFILE	SUBMITTED	DATE
	BY	
PROFILE	ALIGNED CHECKED	BY
	BY	
PROFILE	BY	
	BY	

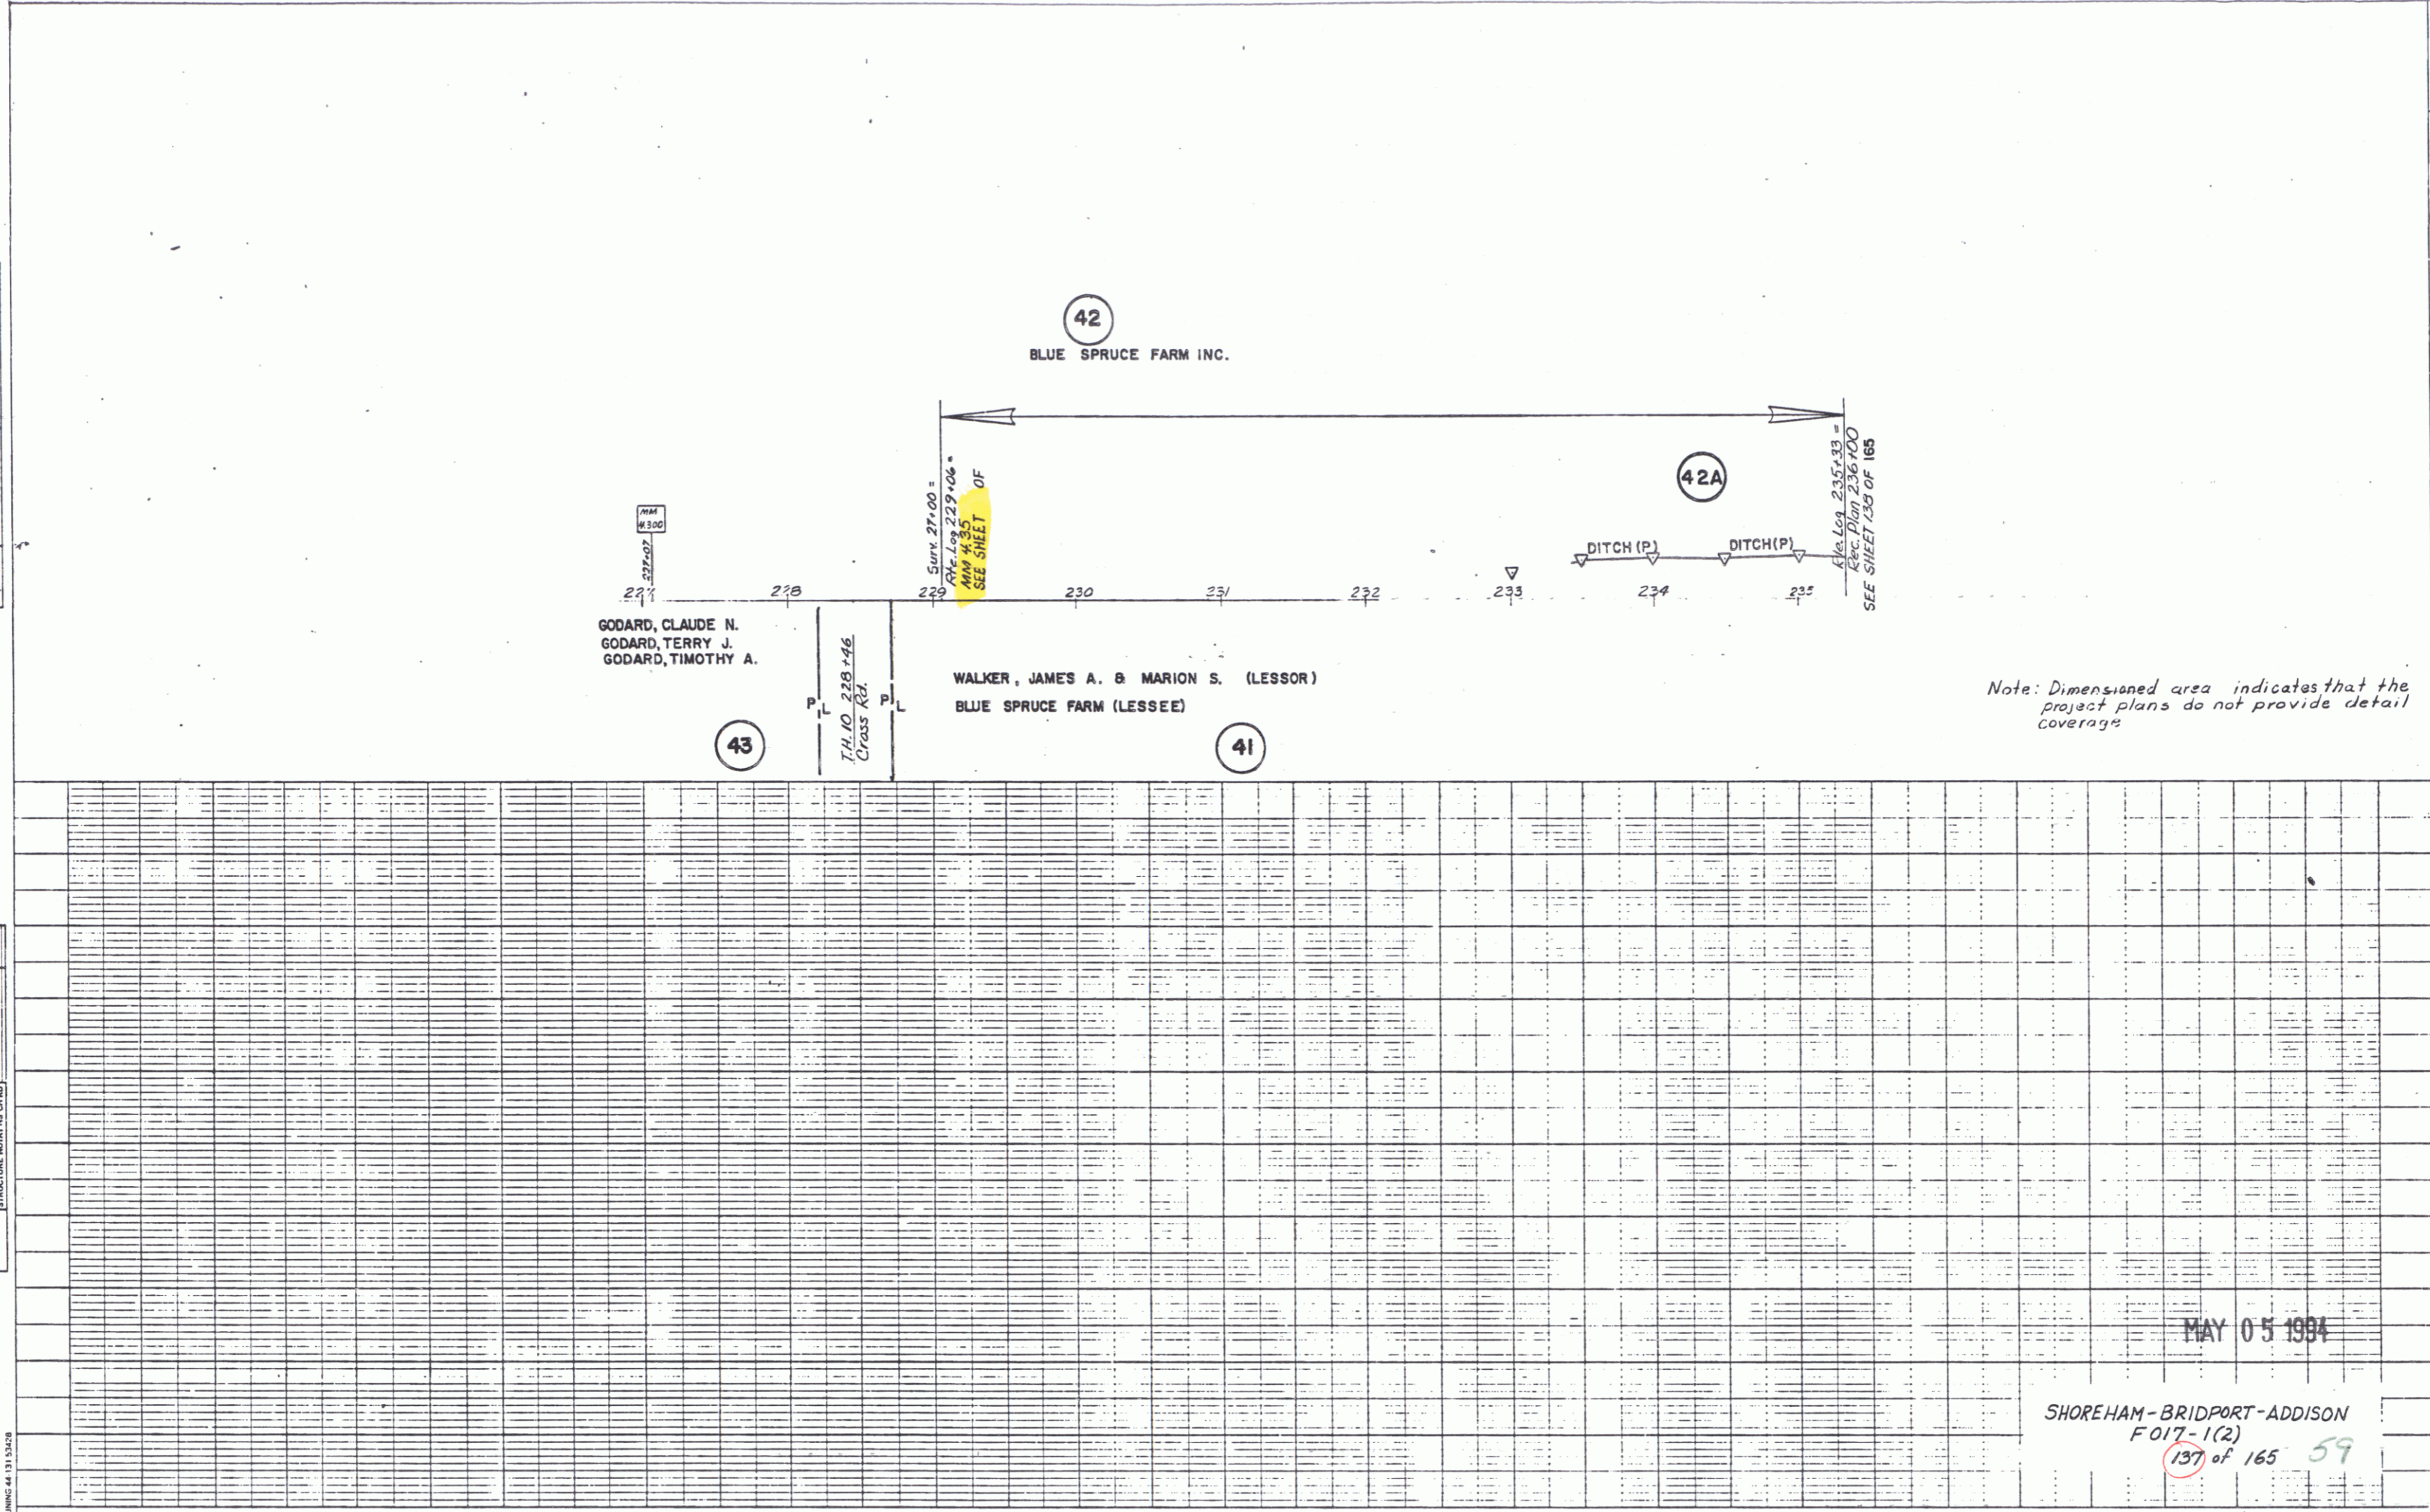

MAY 05 1984

SHOREHAM-BRIDPORT-ADDISON
 F017-1(2)
 137 of 165 59