
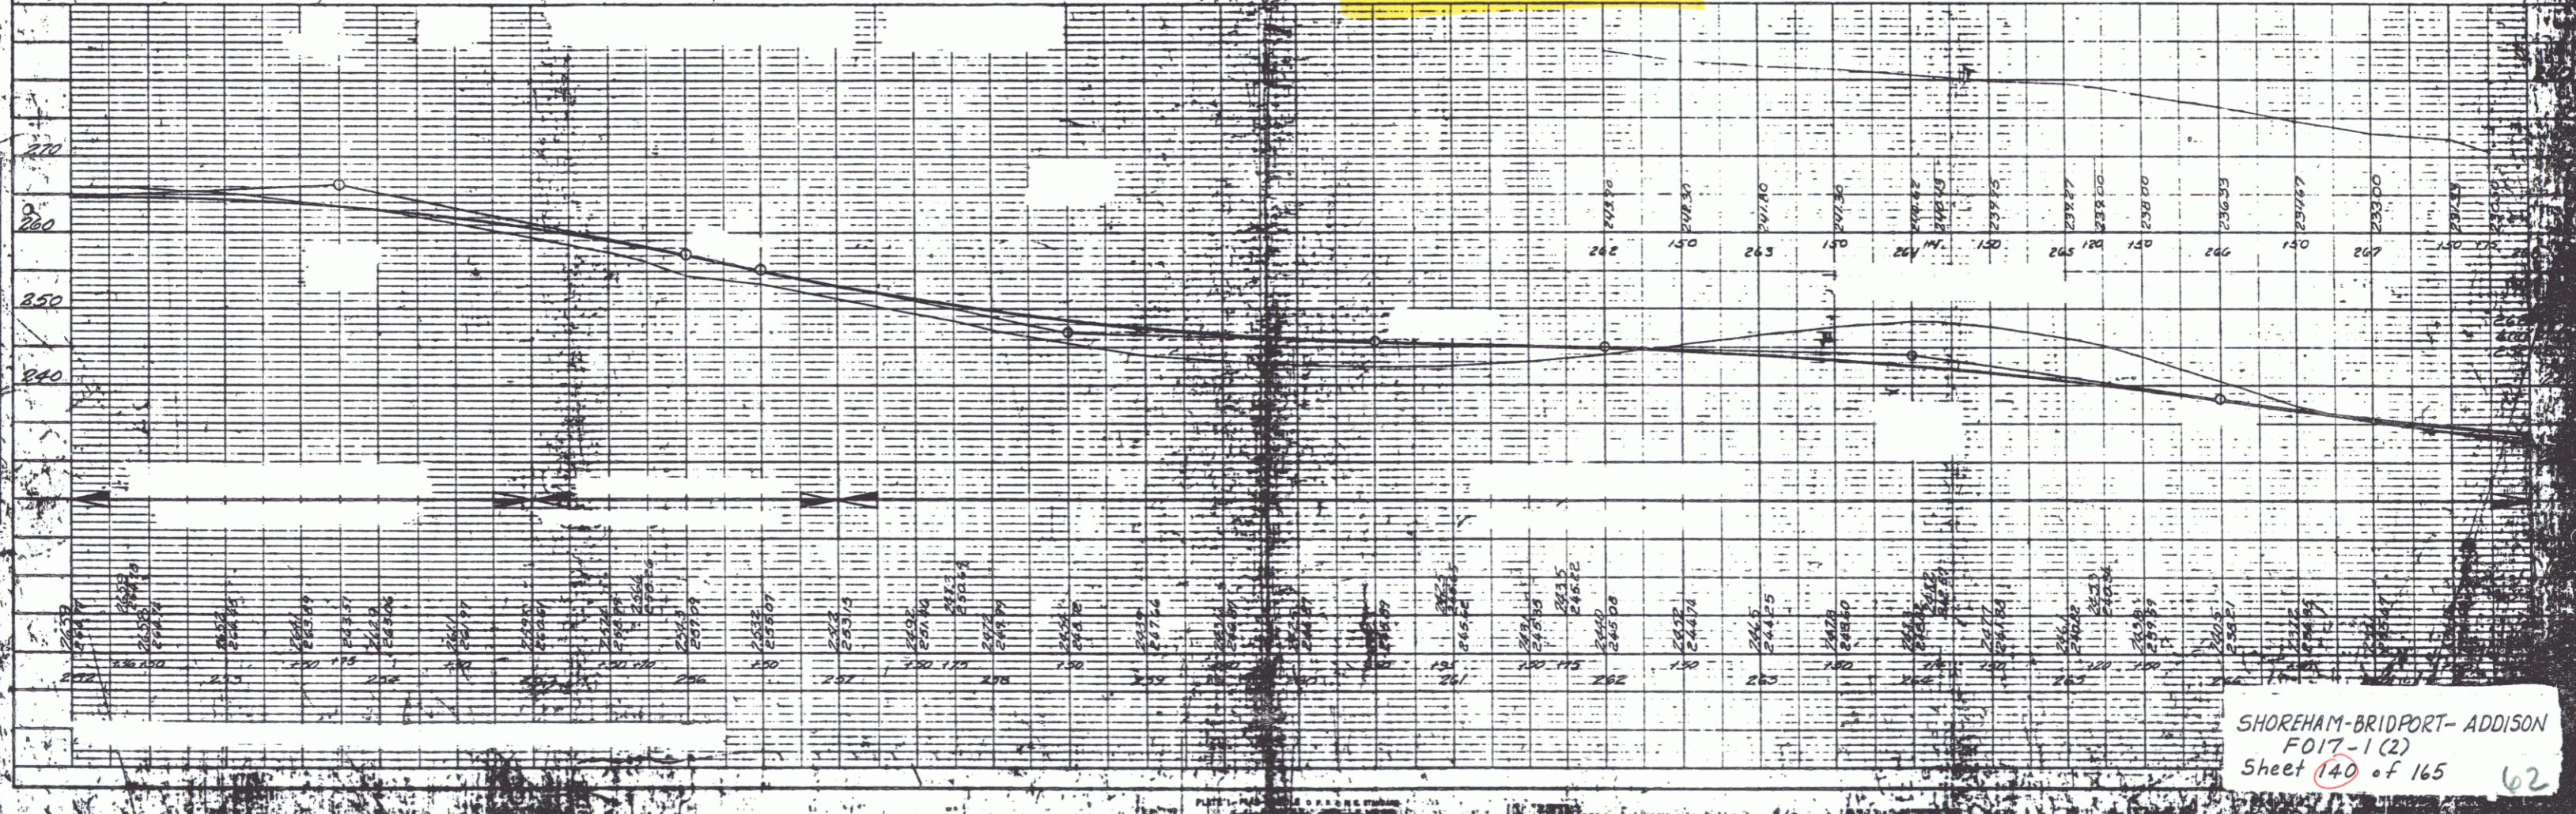


|              |         |
|--------------|---------|
| DATE         | 12/1/45 |
| BY           | J.C.L.  |
| CHECKED      |         |
| APPROVED     |         |
| PLANNING     |         |
| DESIGN       |         |
| CONSTRUCTION |         |
| REVISIONS    |         |
| NO.          |         |
| DESCRIPTION  |         |

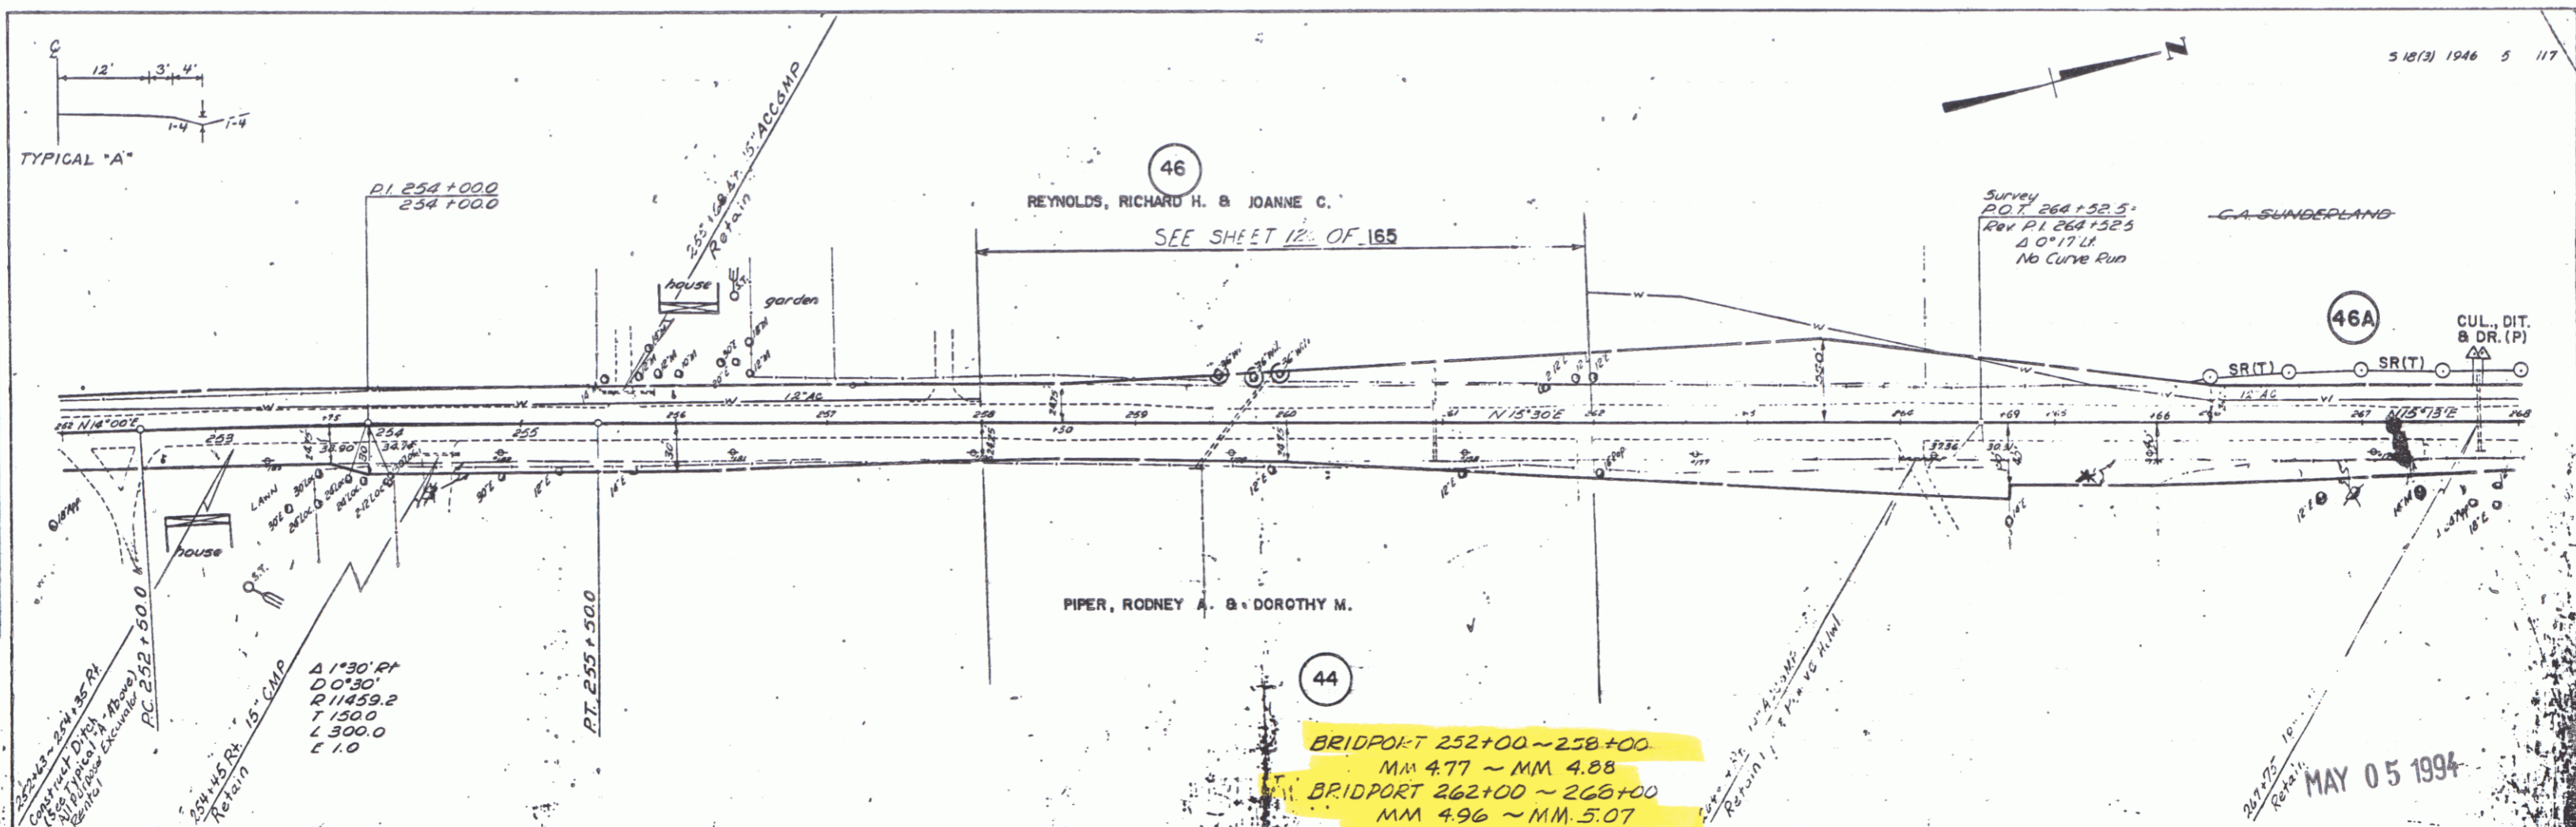

BRIDPORT 252+00 ~ 258+00  
MM 4.77 ~ MM 4.88  
BRIDPORT 262+00 ~ 268+00  
MM 4.96 ~ MM 5.07