
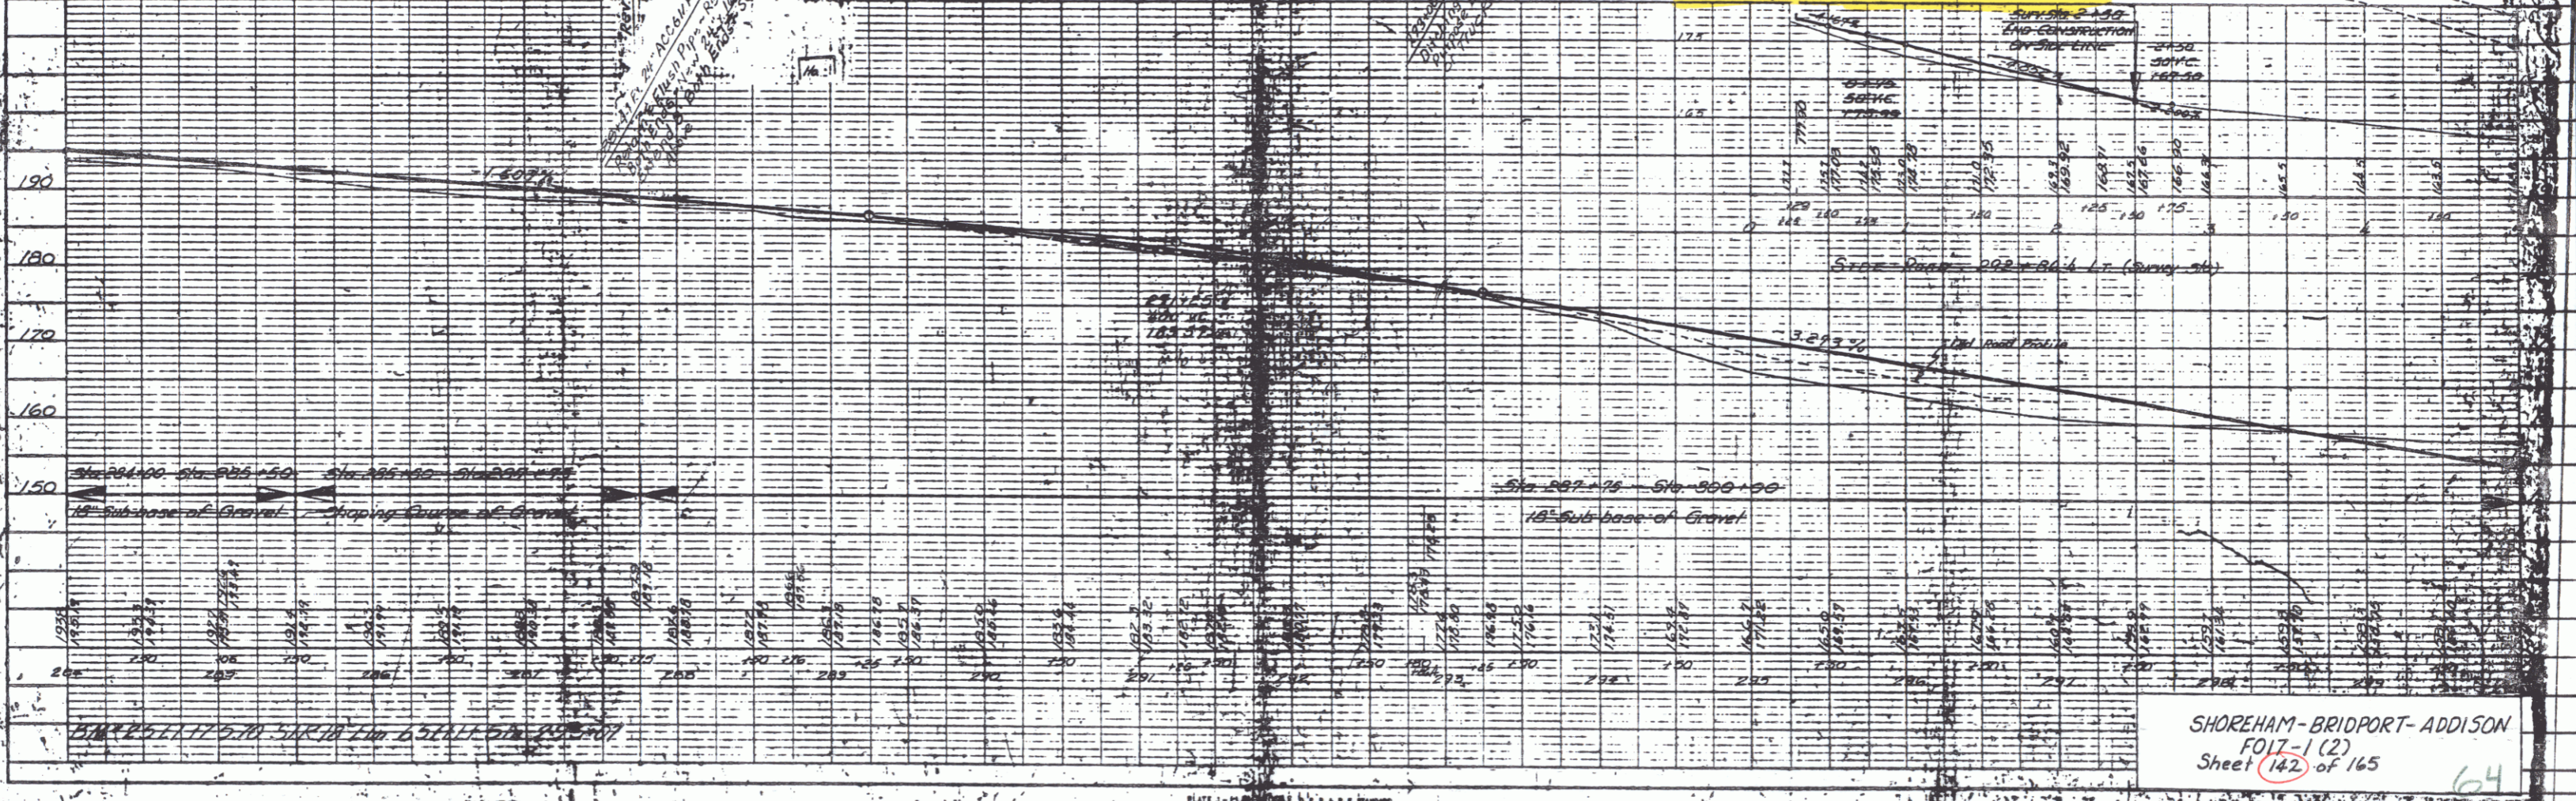


PLAN	DATE	BY	CHKD
REVISIONS			
1			
2			
3			
4			
5			
6			
7			
8			
9			
10			

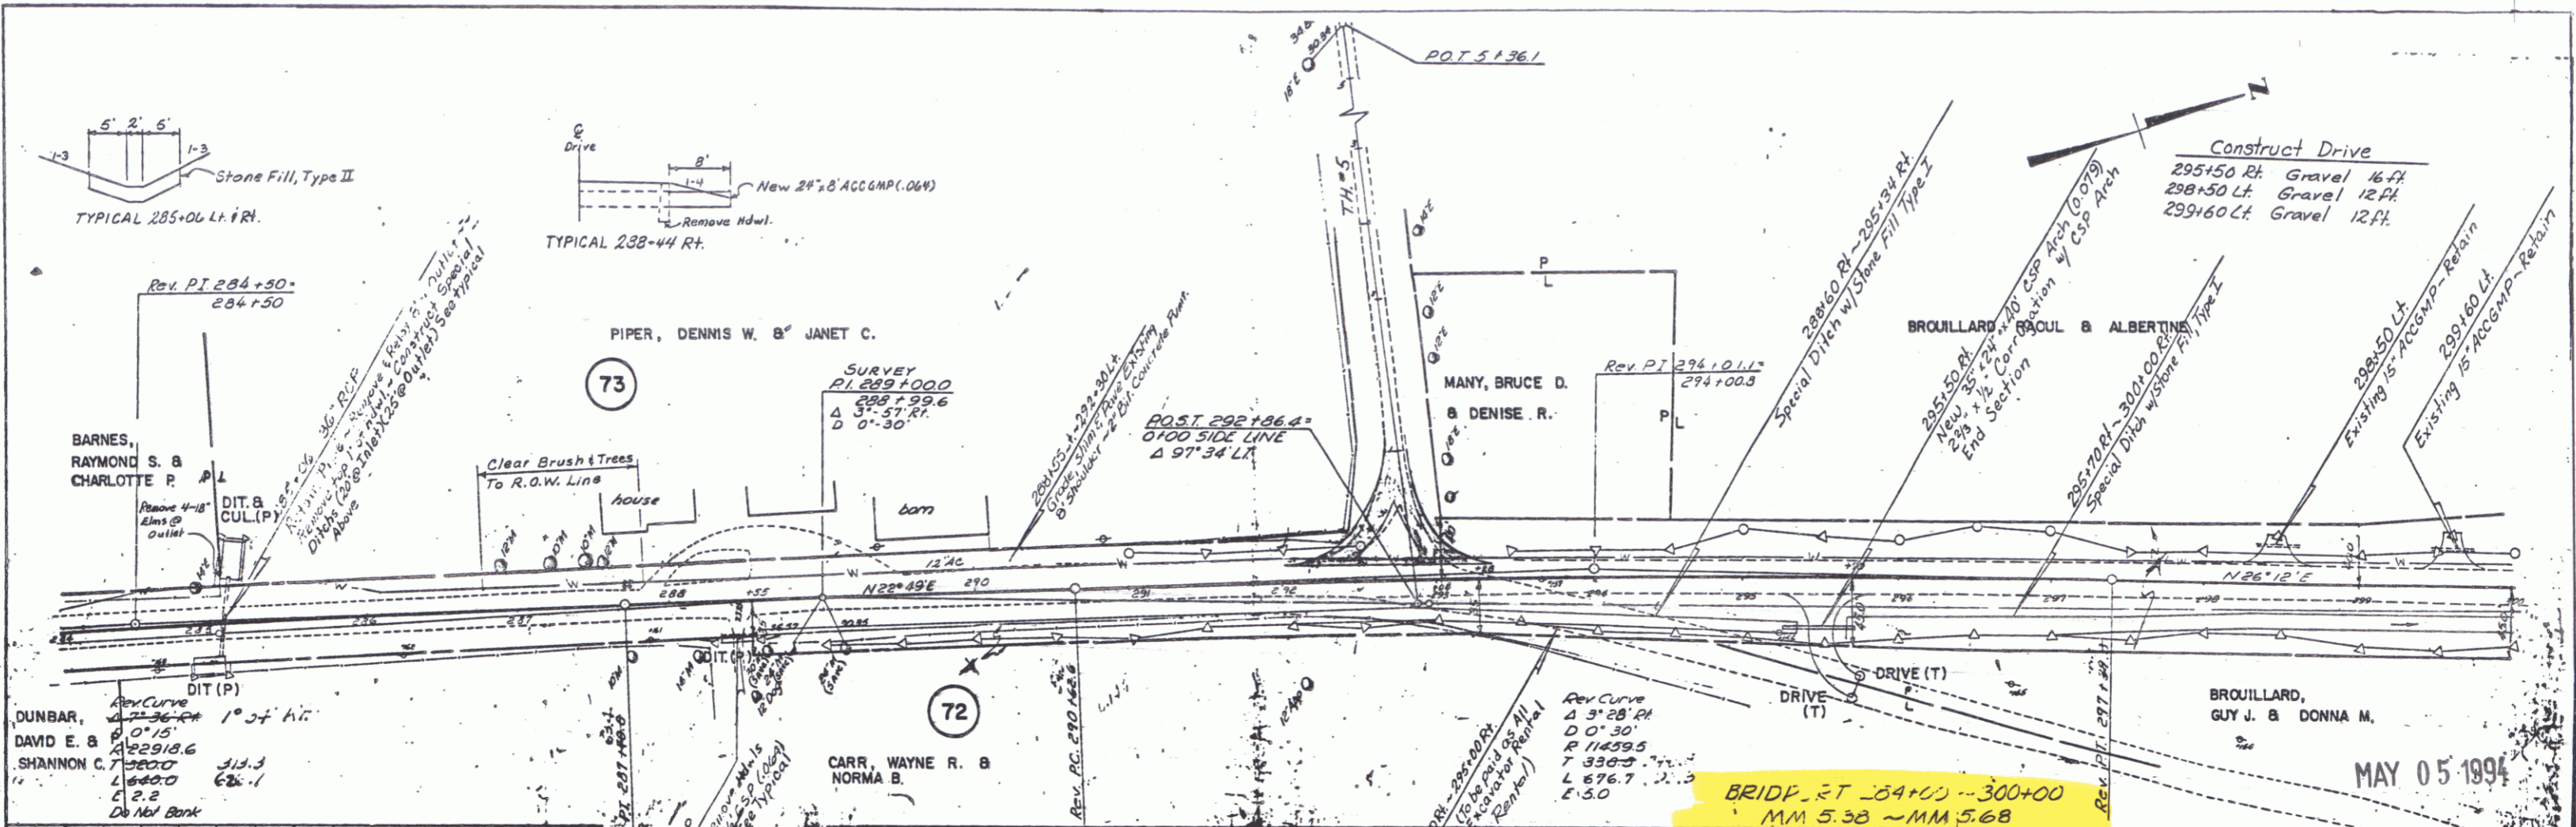

SHOREHAM-BRIDPORT-ADDISON
FOI 7-1 (2)
Sheet 142 of 165
64

MAY 05 1994