


DATE: 4-24-94
 BY: F. J. S. / J. S. / J. S.
 CHECKED: J. S. / J. S. / J. S.
 IN CHARGE: J. S. / J. S. / J. S.

DATE: 4-24-94
 BY: F. J. S. / J. S. / J. S.
 CHECKED: J. S. / J. S. / J. S.
 IN CHARGE: J. S. / J. S. / J. S.

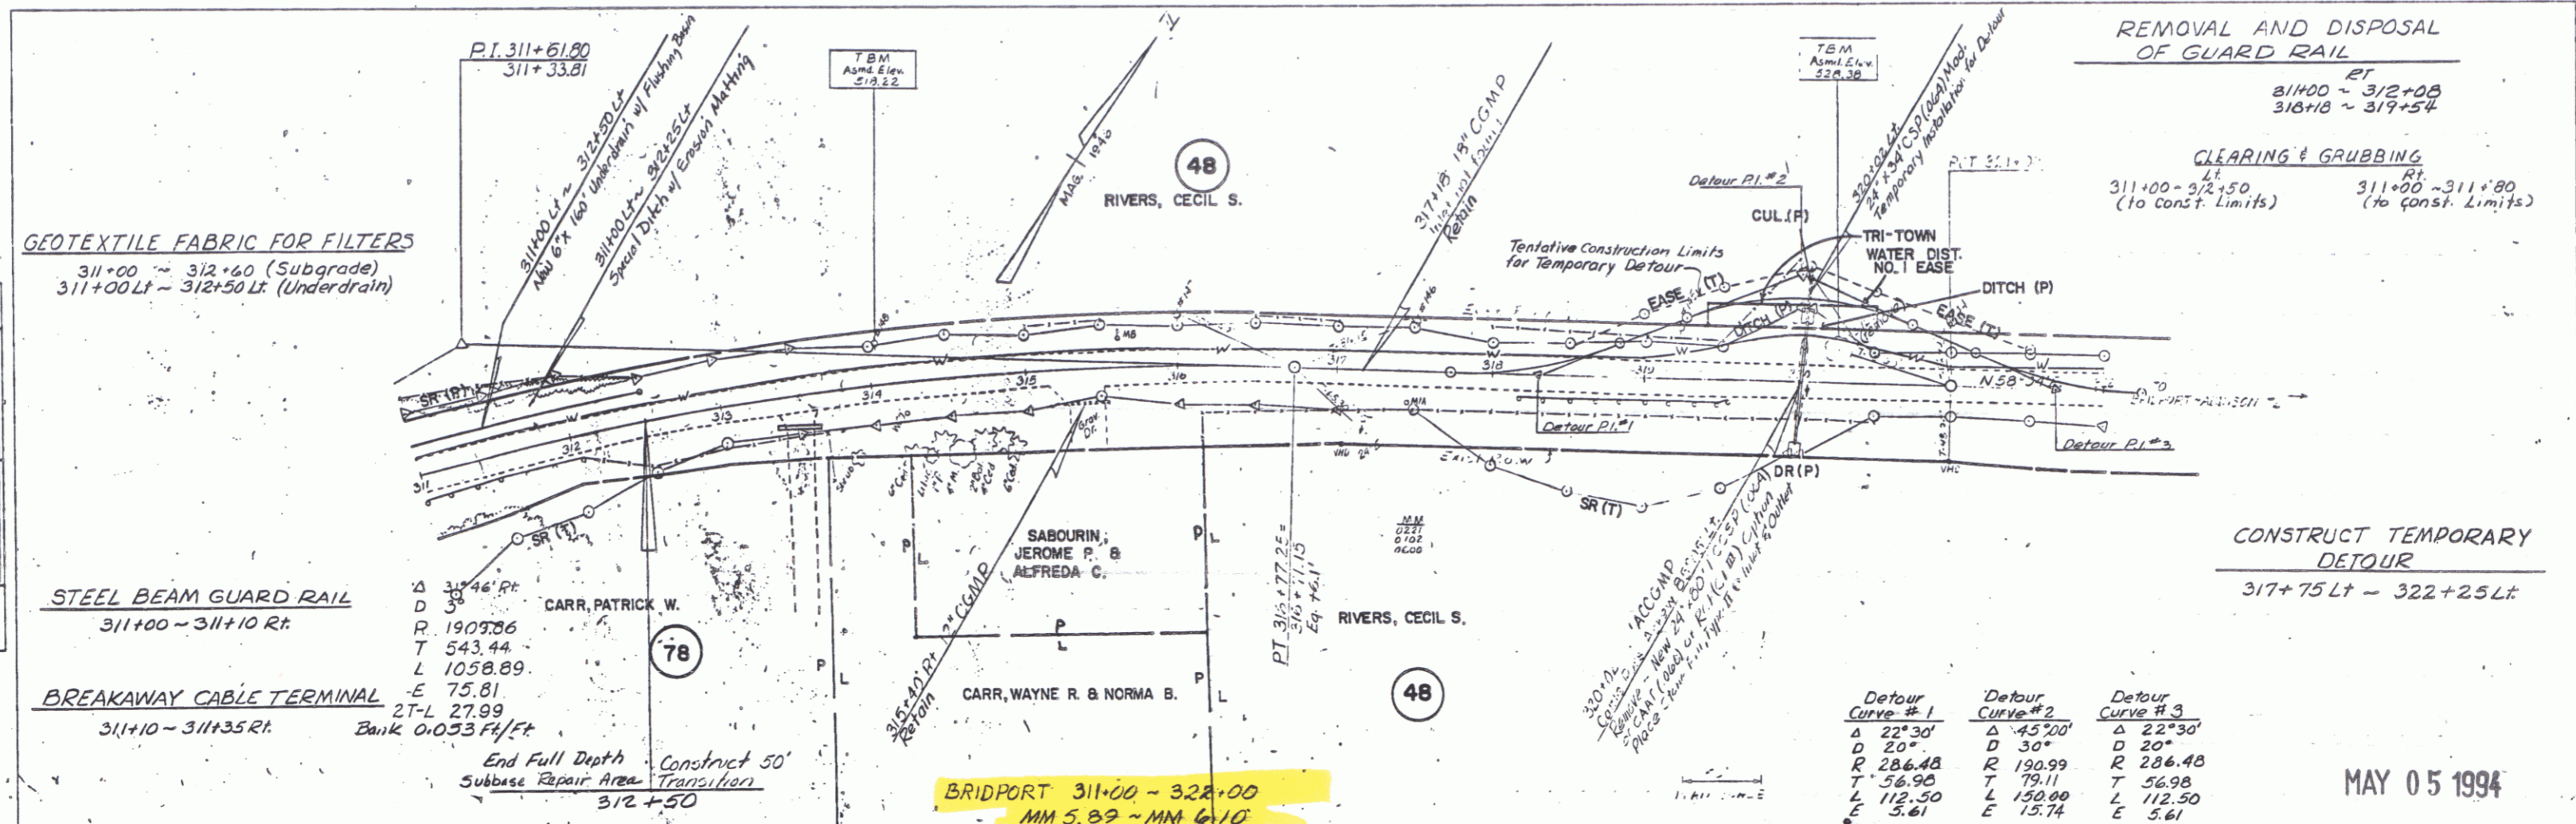


REMOVAL AND DISPOSAL
 OF GUARD RAIL
 RT
 311+00 ~ 312+08
 LT
 318+18 ~ 319+54

CLEARING & GRUBBING
 RT
 311+00 ~ 312+50
 LT
 (to const. Limits)

CONSTRUCT TEMPORARY
 DETOUR
 317+75 Lt - 322+25 Lt

Detour Curve #1	Detour Curve #2	Detour Curve #3
Δ 22°30'	Δ 45°00'	Δ 22°30'
D 20'	D 30'	D 20'
R 286.48	R 190.99	R 286.48
T 56.98	T 79.11	T 56.98
L 112.50	L 150.00	L 112.50
E 5.61	E 15.74	E 5.61

MAY 05 1994

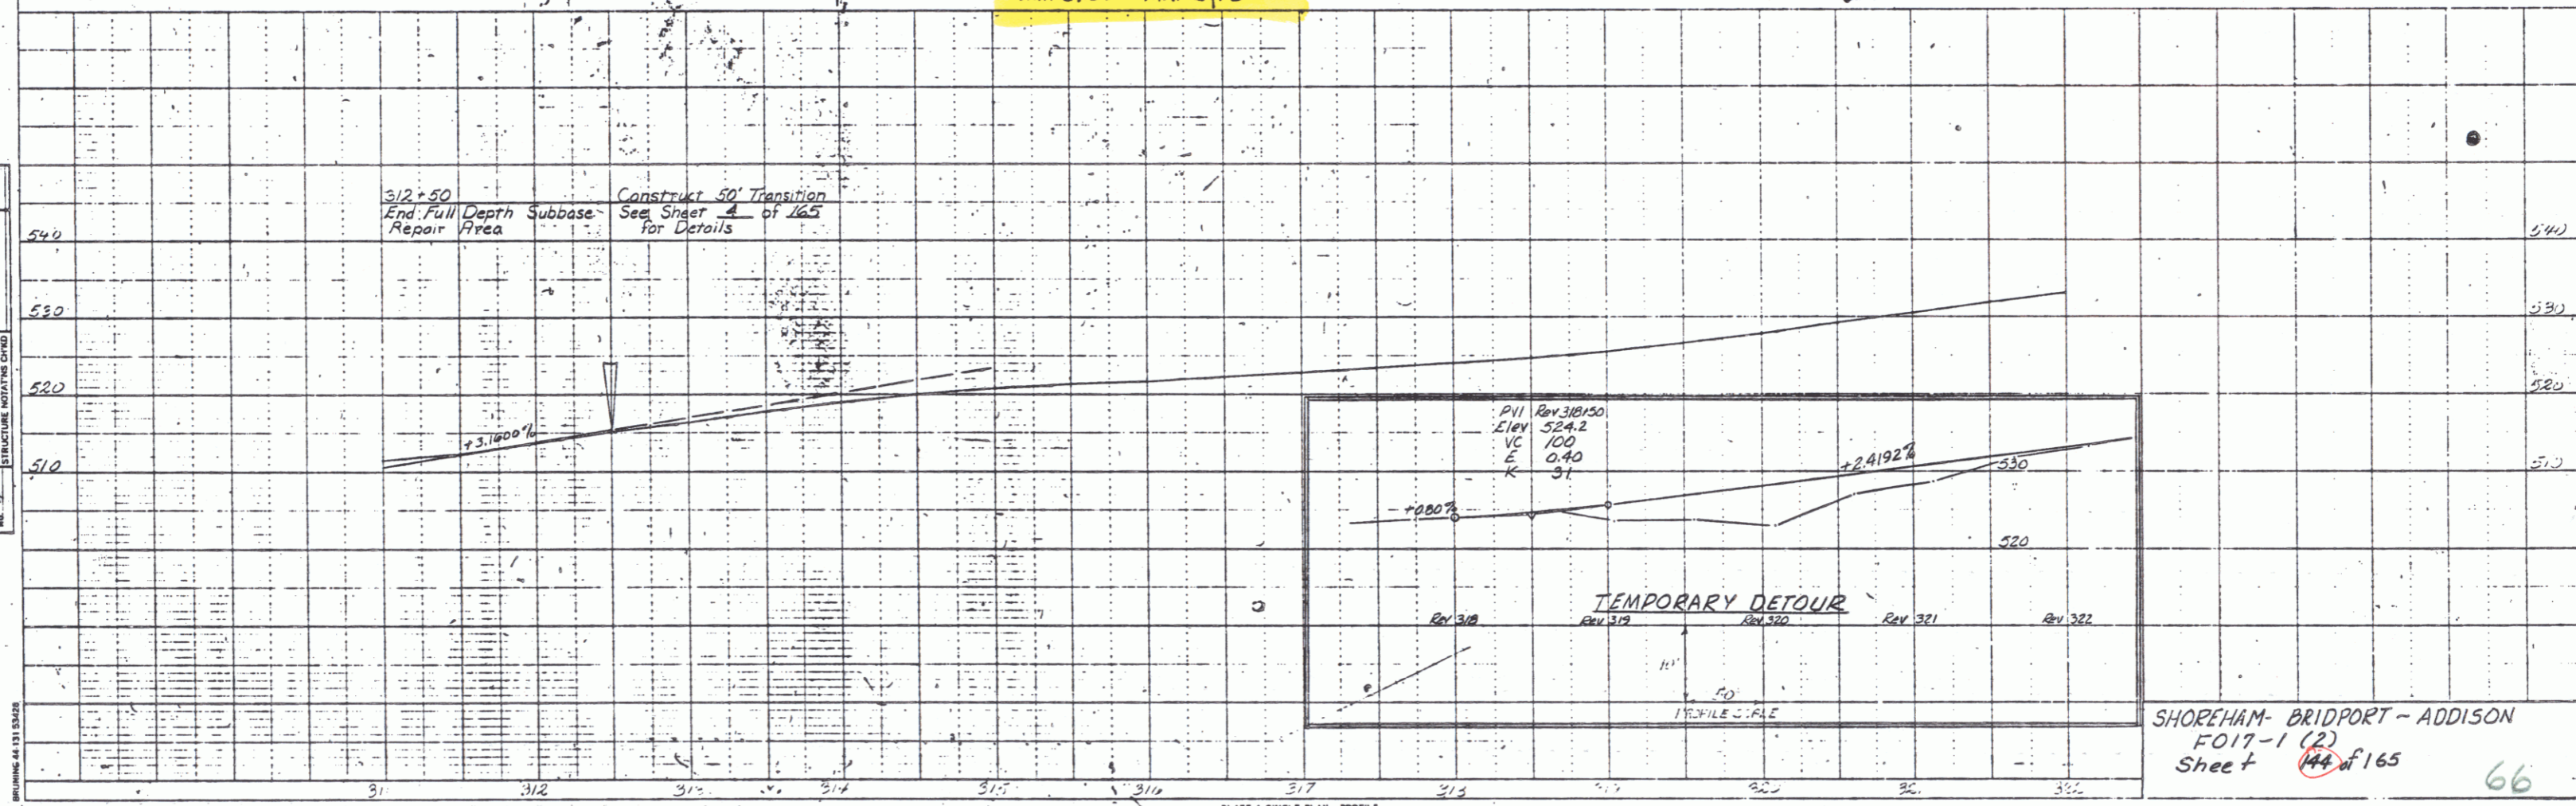

SHOREHAM-BRIDPORT-ADDISON
 FO17-1 (2)
 Sheet 144 of 165
 66