

5/10/20 1946 9 117

SEE SHEET 144 OF 165 SHEETS

RIVERS, CECIL S. 48

RIVERS, CECIL S. 48

POT 323+00

Sta 322+00 to 324+00
12' AC
24' x 24' ACCOUNT

PC 325+24.4


BRIDPORT 322+00 ~ 326+00
MM 6.10 ~ MM 6.17

Sta 320+
Cottic Pass 72" CBMPAC (12' dia)
Construct
Floor in Pipe
9/8 bars spaced 6" c/c
(EXISTING)

MAY 05 1994

PLAN	DATE	BY	CHECKED
5/10/20	1946	9	117
NO. OF ANY CHECKS			
12/16			

PROFILE	DATE	BY	CHECKED
5/10/20	1946	9	117
NO. OF ANY CHECKS			
12/16			

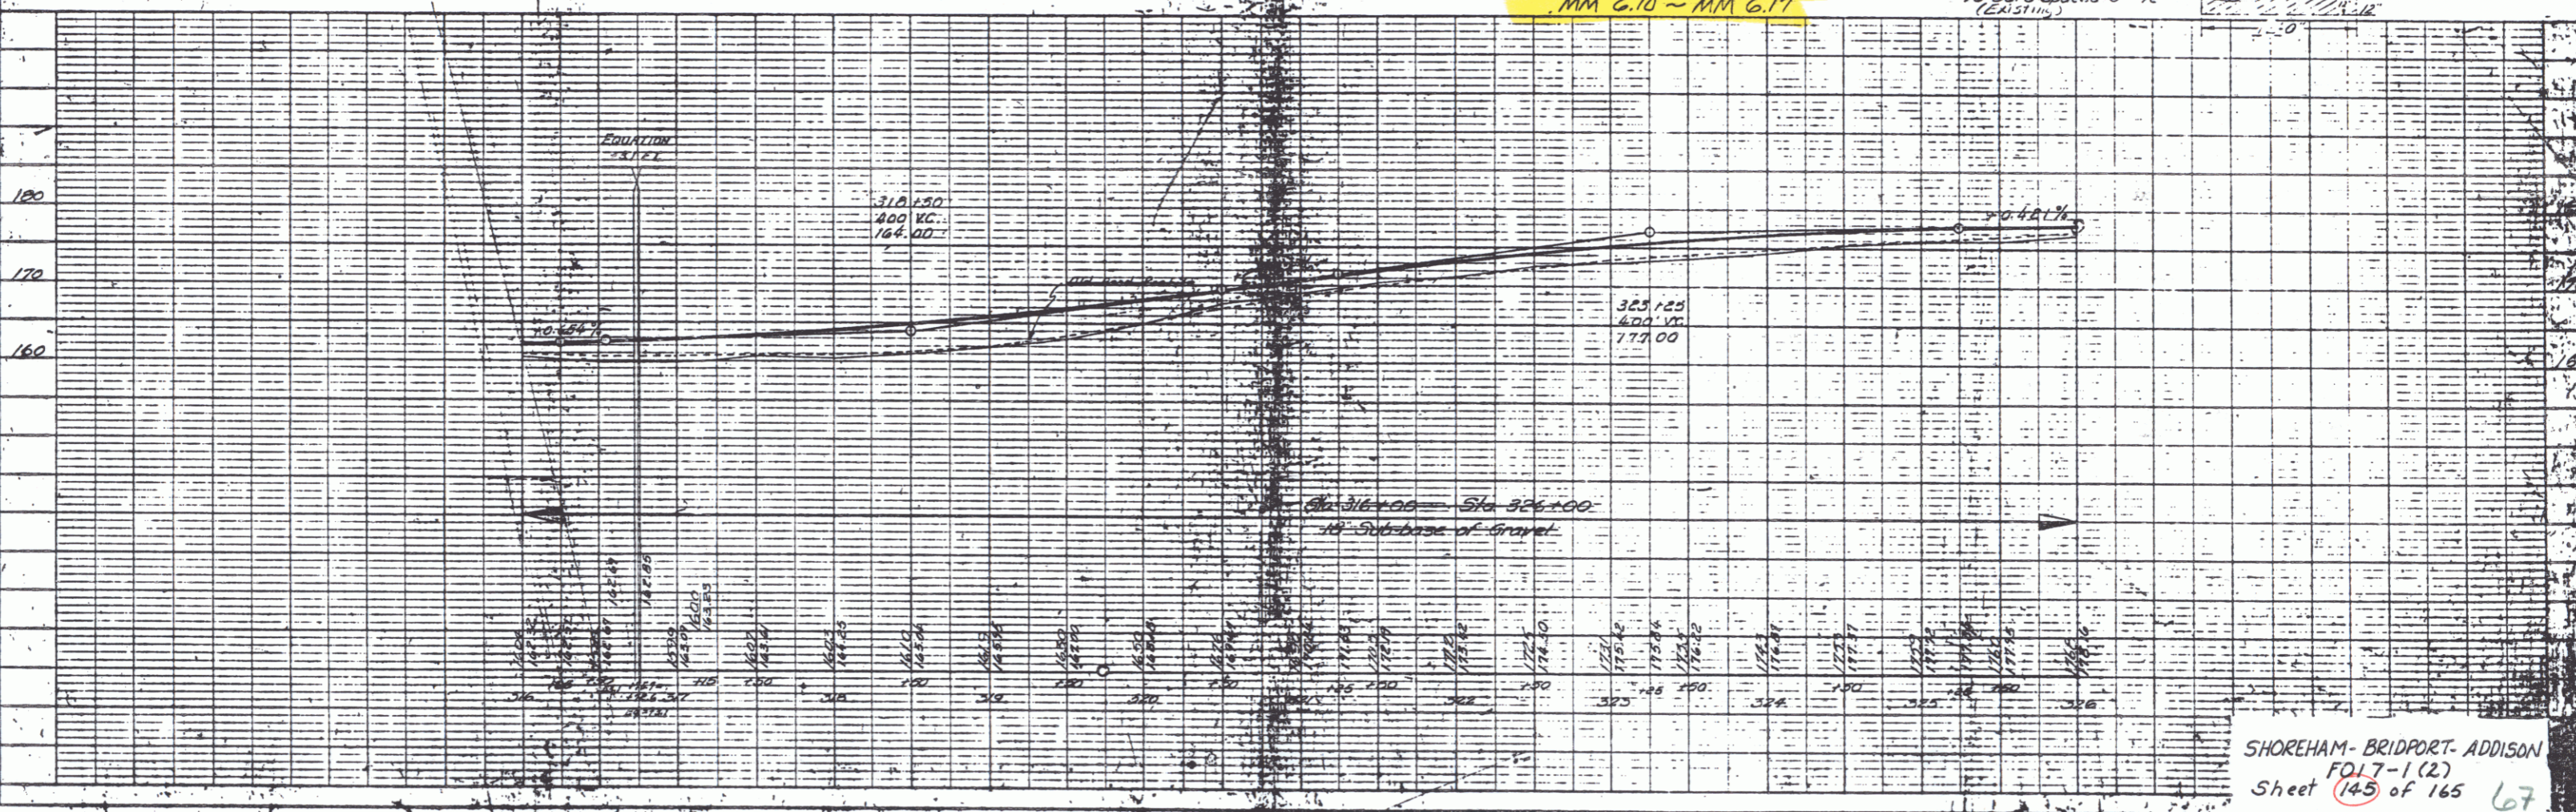

SHOREHAM-BRIDPORT-ADDISON
FDL7-1(2)
Sheet 145 of 165 67