
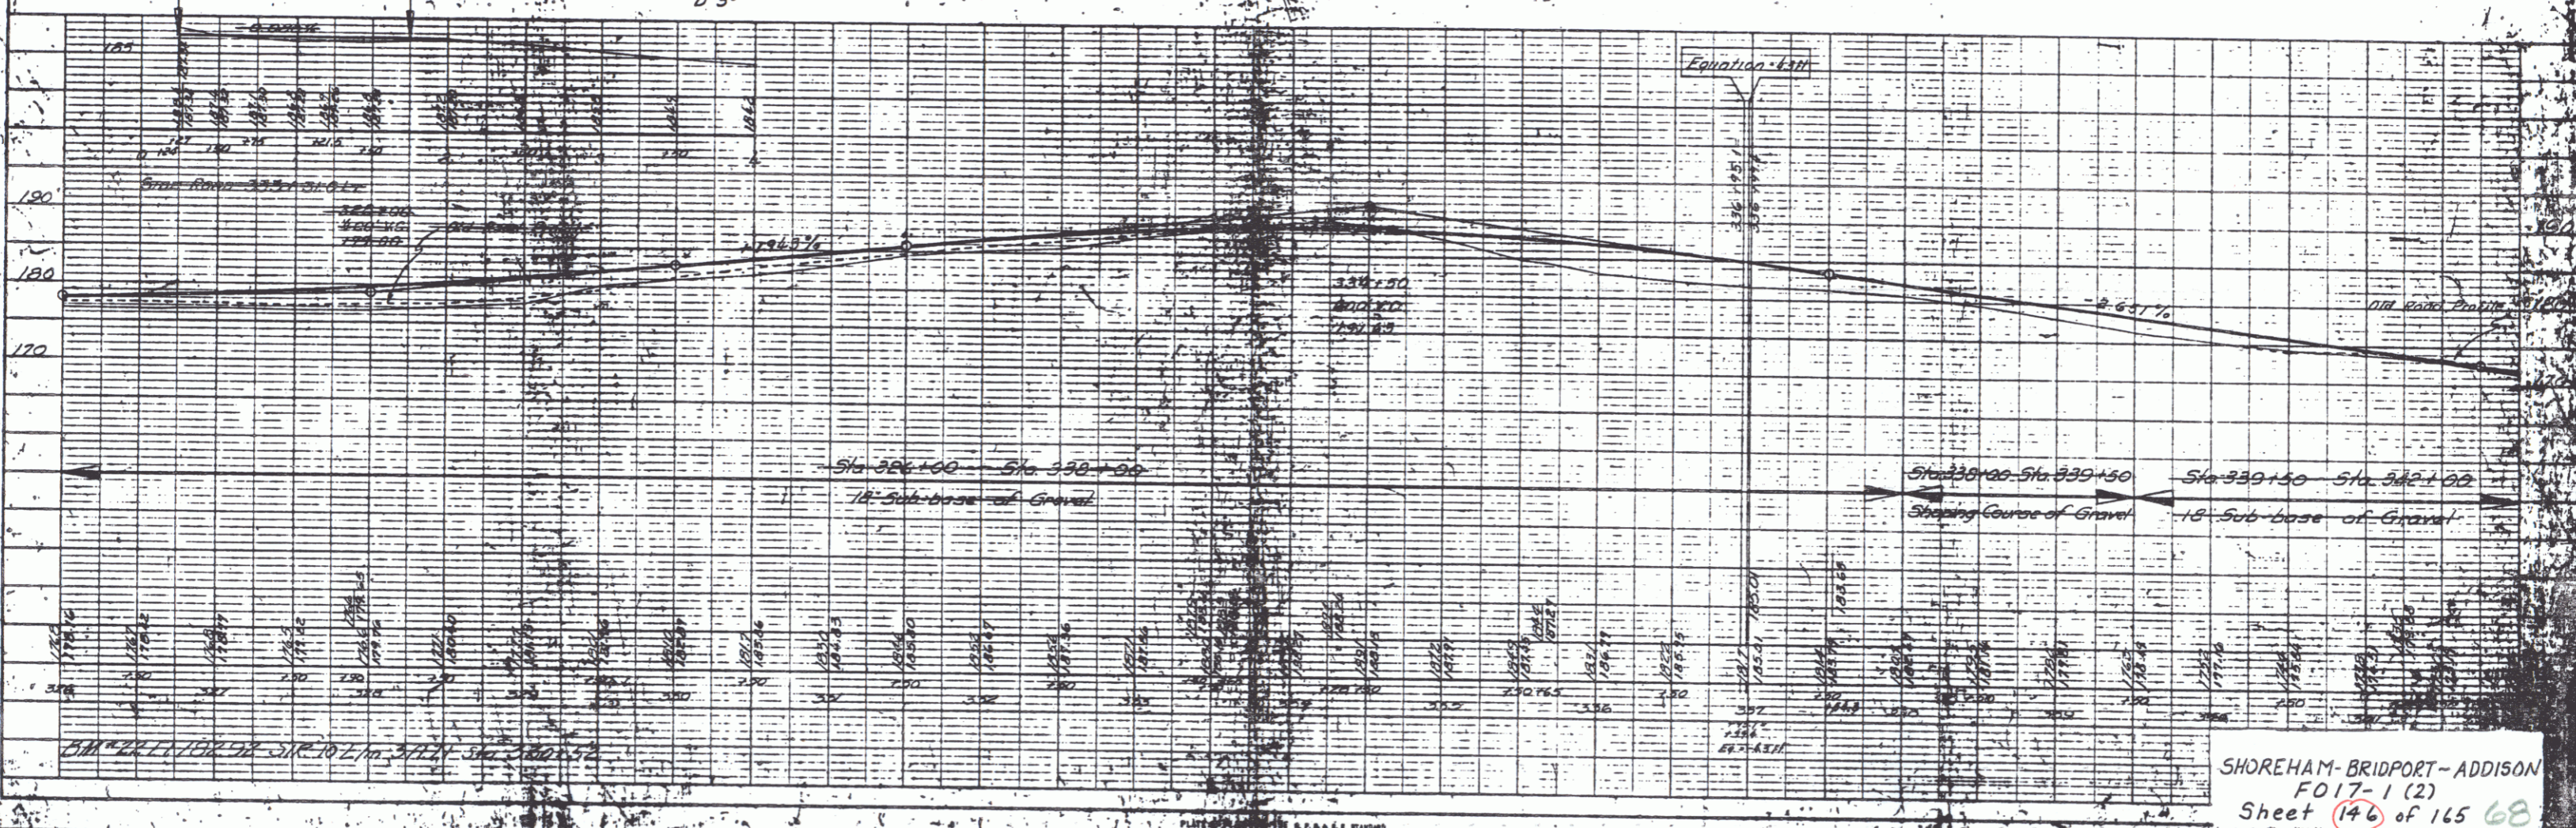


DATE	10/22/94
BY	W. J. [unclear]
PROJECT	SHOREHAM BRIDPORT-ADDISON
SCALE	AS SHOWN
DATE	10/22/94
BY	W. J. [unclear]
PROJECT	SHOREHAM BRIDPORT-ADDISON
SCALE	AS SHOWN

DATE	10/22/94
BY	W. J. [unclear]
PROJECT	SHOREHAM BRIDPORT-ADDISON
SCALE	AS SHOWN
DATE	10/22/94
BY	W. J. [unclear]
PROJECT	SHOREHAM BRIDPORT-ADDISON
SCALE	AS SHOWN

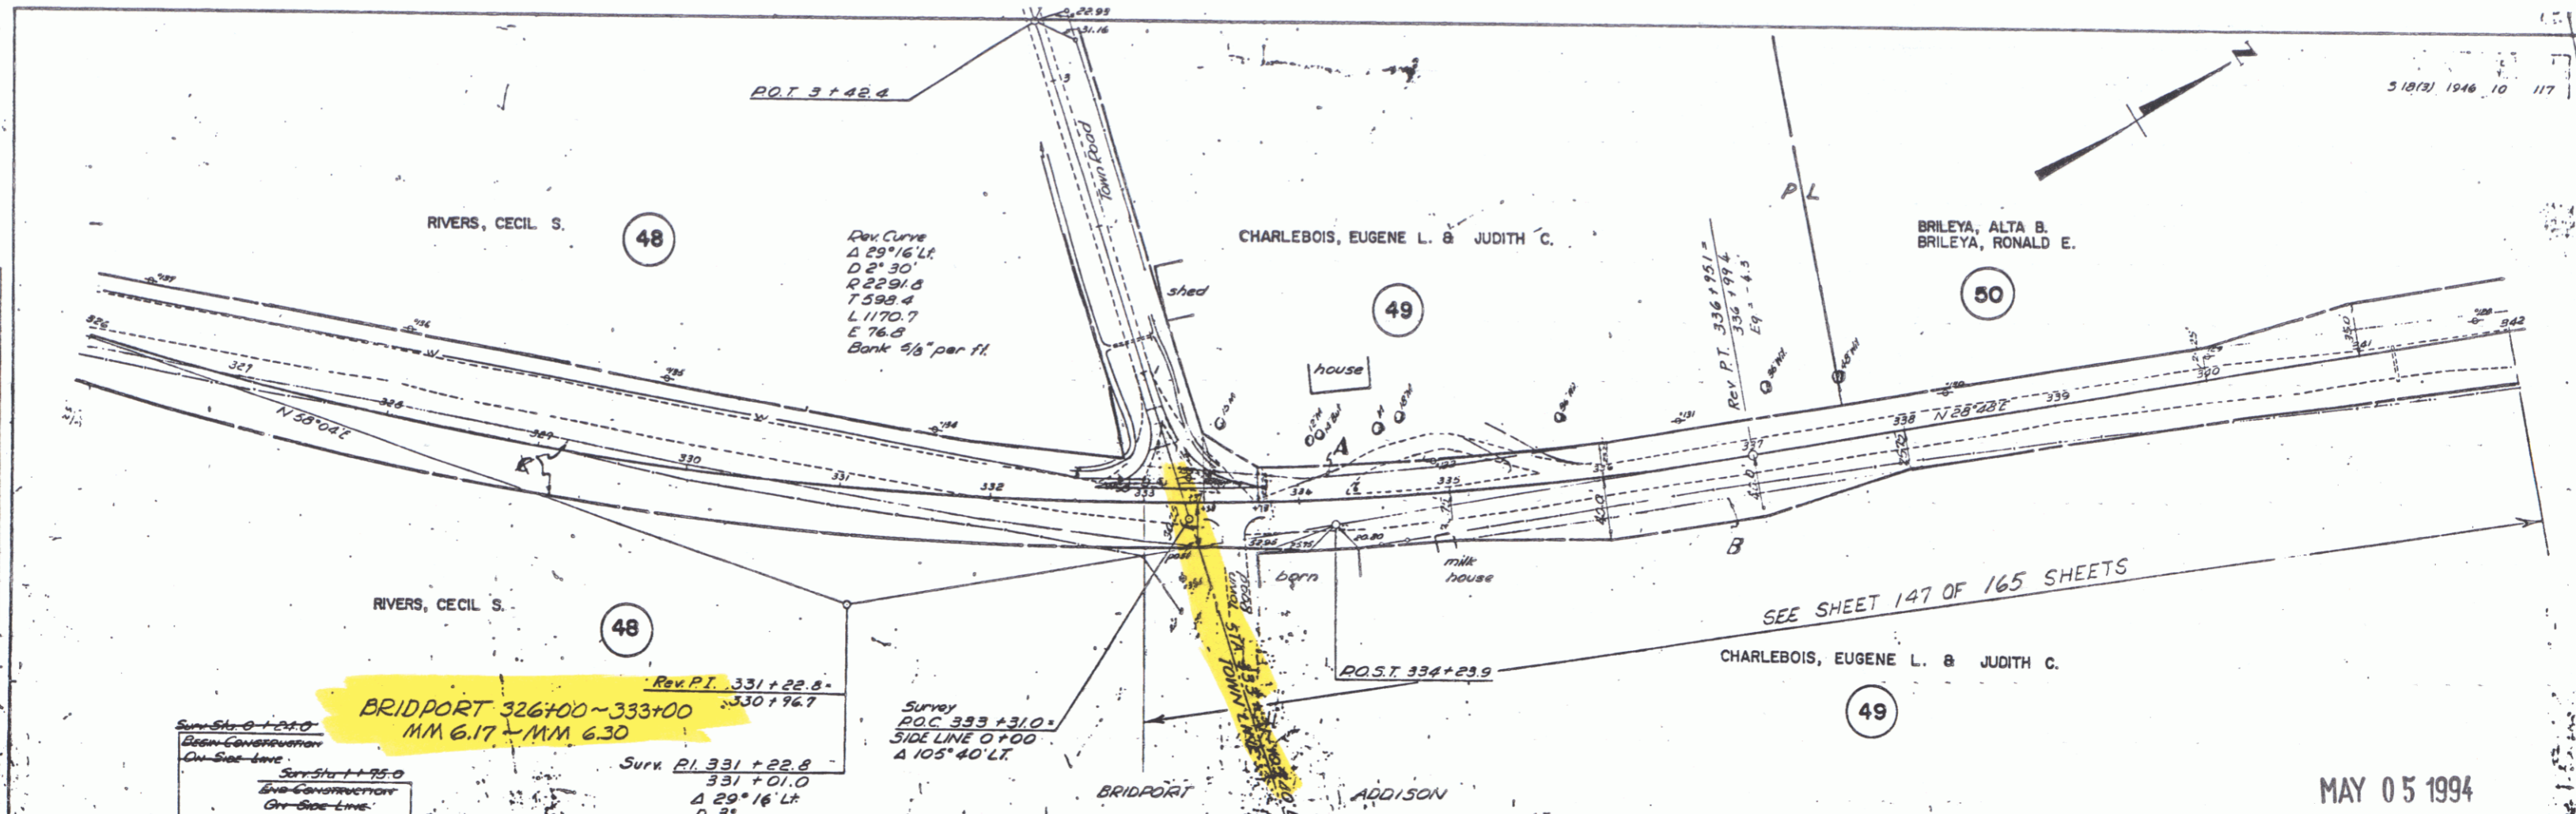

SHOREHAM-BRIDPORT-ADDISON
 FO17-1 (2)
 Sheet 146 of 165 68