
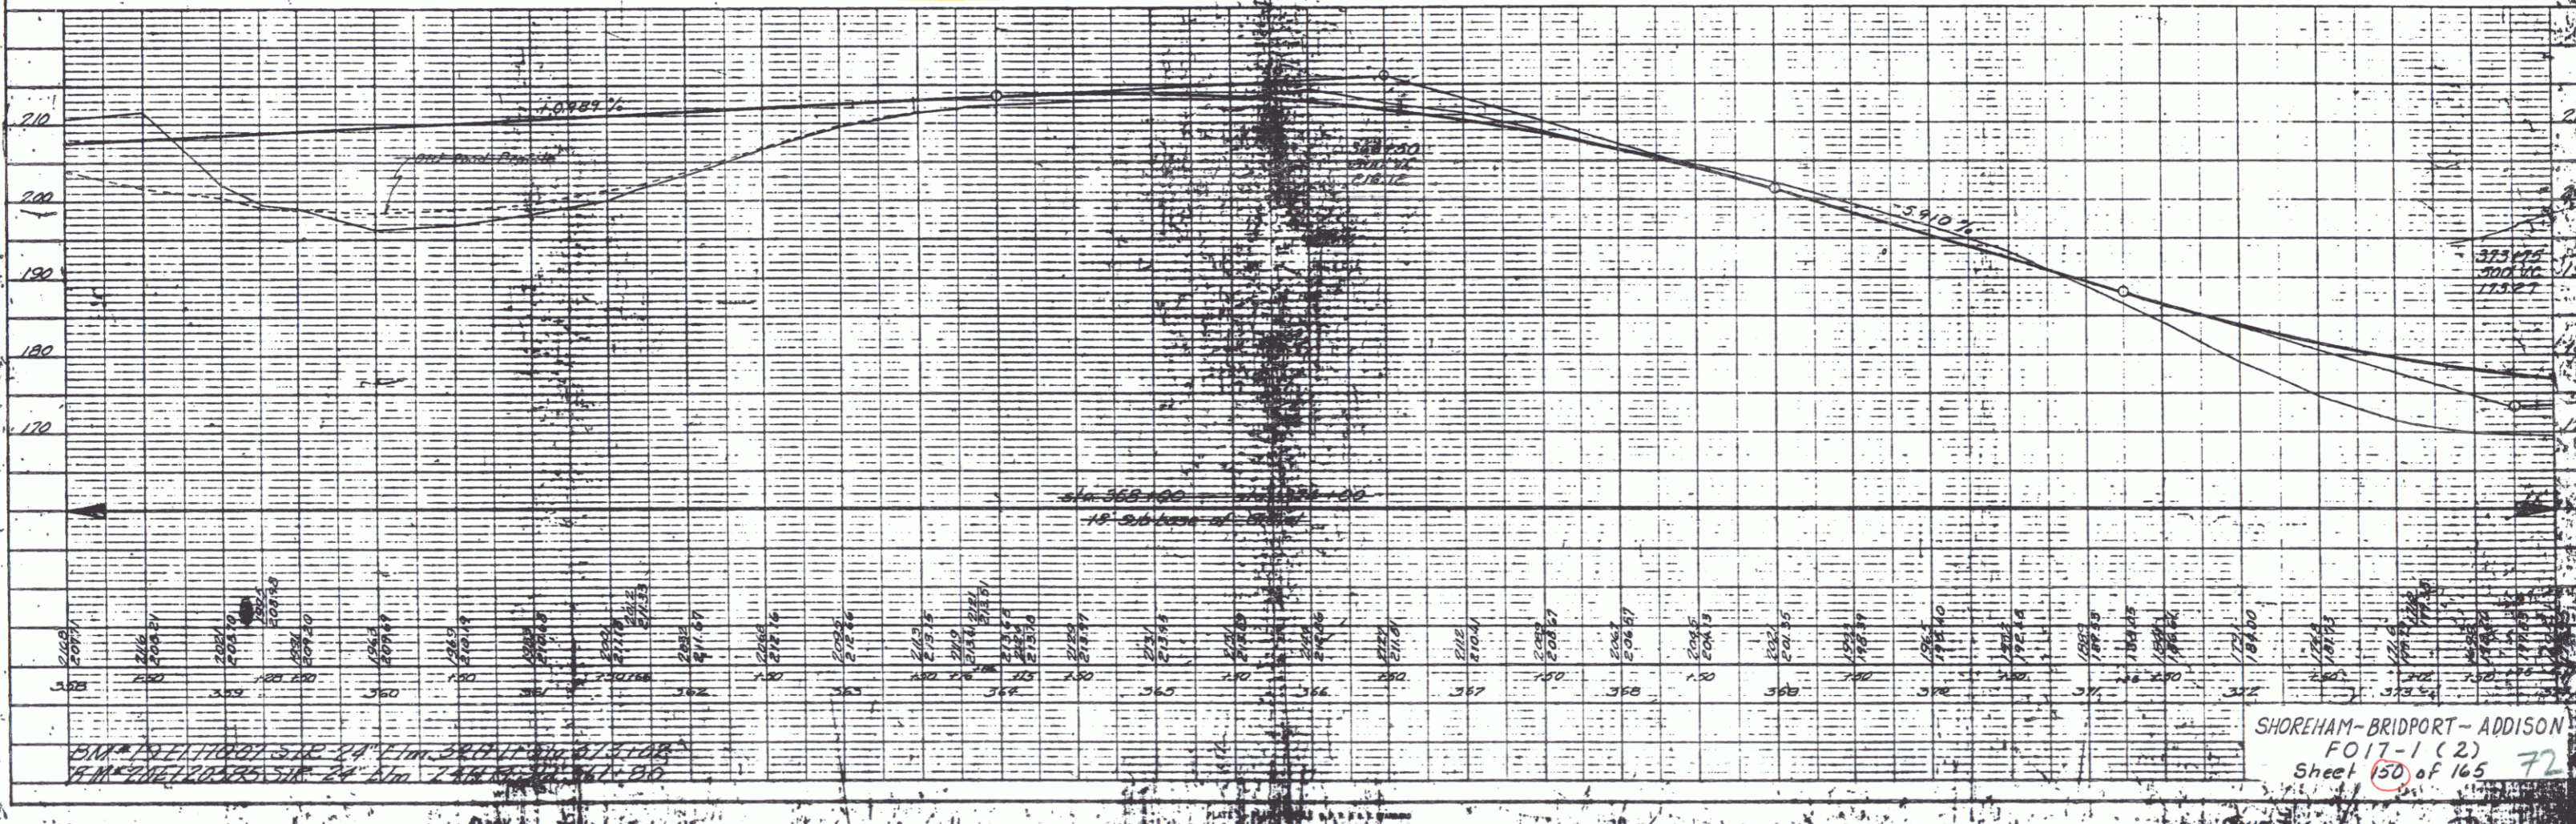


PLAN	DATE	BY
REVISED		
BY		
DATE		

SCALE	DATE	BY
REVISED		
BY		
DATE		

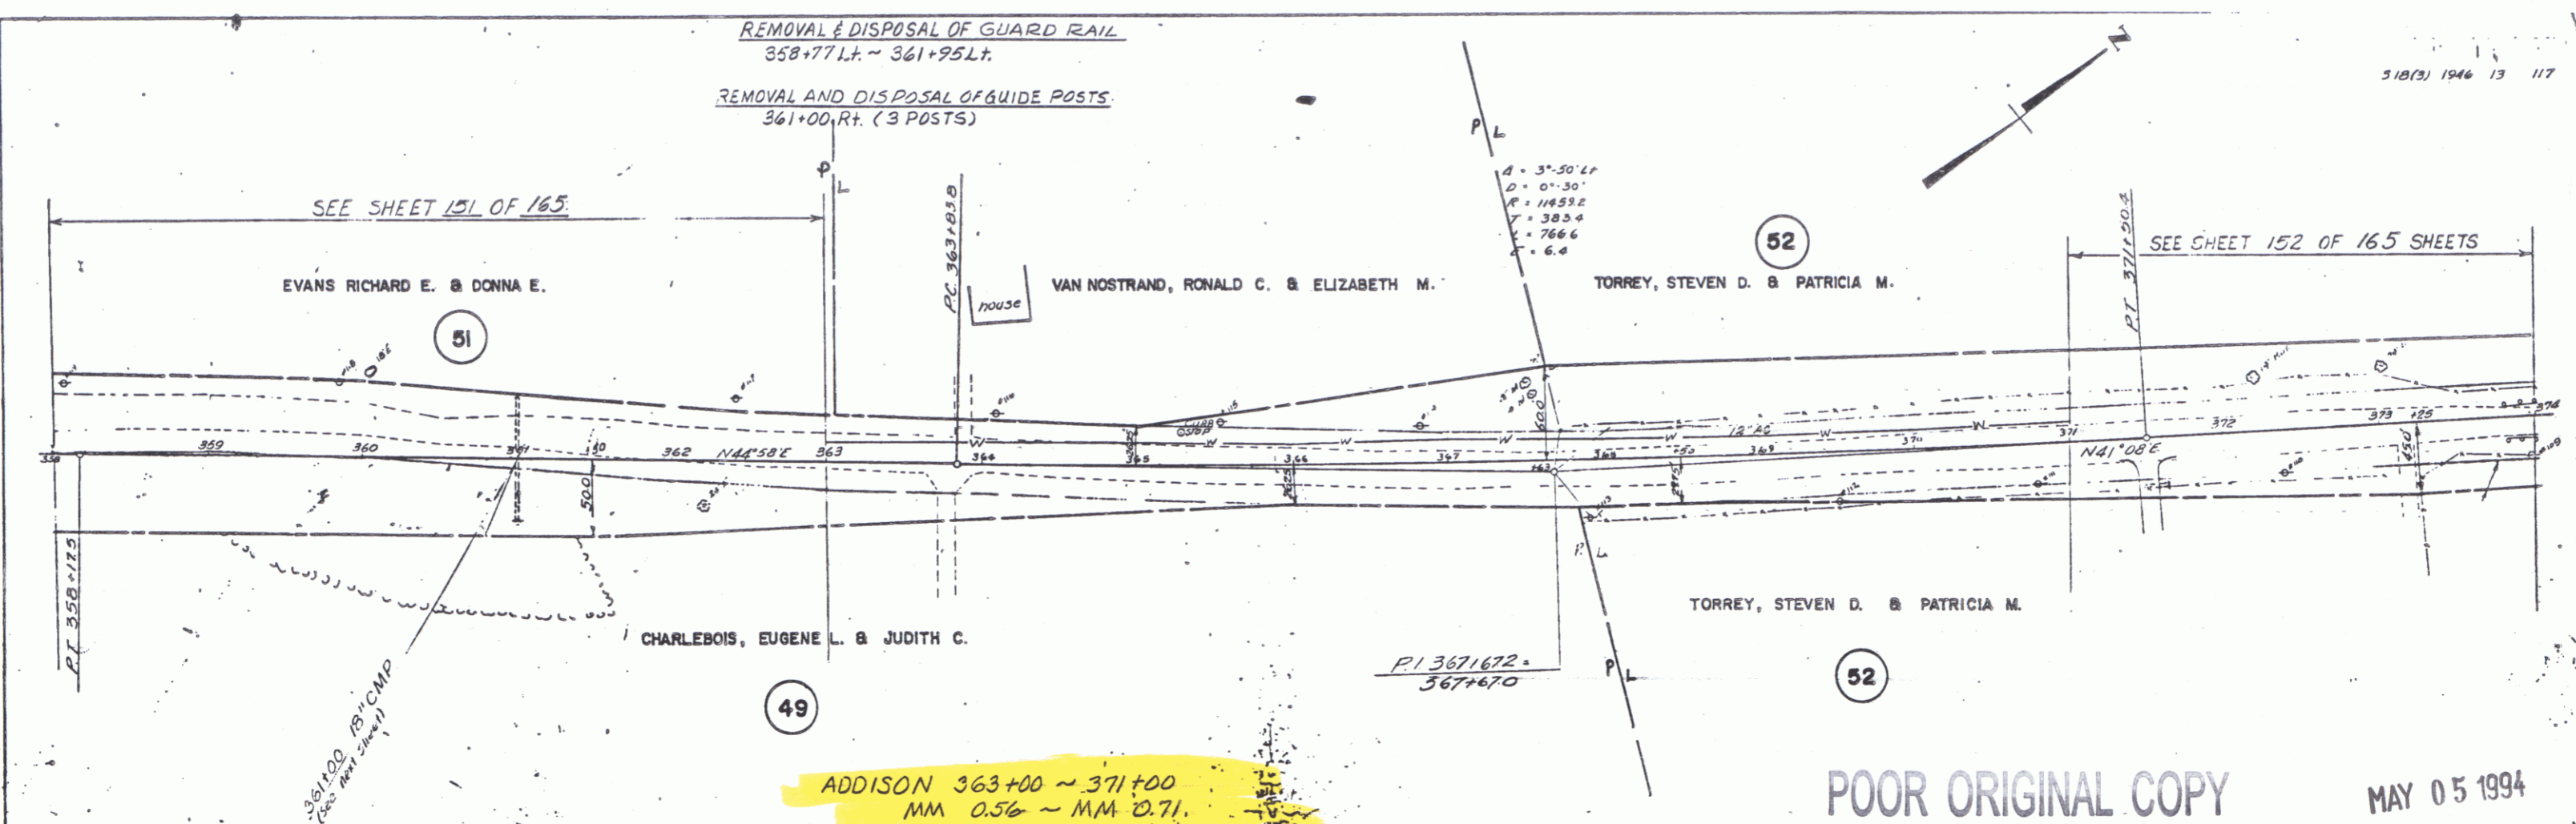

510(3) 1946 13 117

POOR ORIGINAL COPY

MAY 05 1994

SHOREHAM-BRIDPORT-ADDISON
FO17-1(2)
Sheet 150 of 165 72