


|          |          |
|----------|----------|
| DATE     | BY       |
| DESIGNED | ENGINEER |
| CHECKED  | CHECKED  |
| DATE     | DATE     |

|          |          |
|----------|----------|
| DATE     | BY       |
| DESIGNED | ENGINEER |
| CHECKED  | CHECKED  |
| DATE     | DATE     |

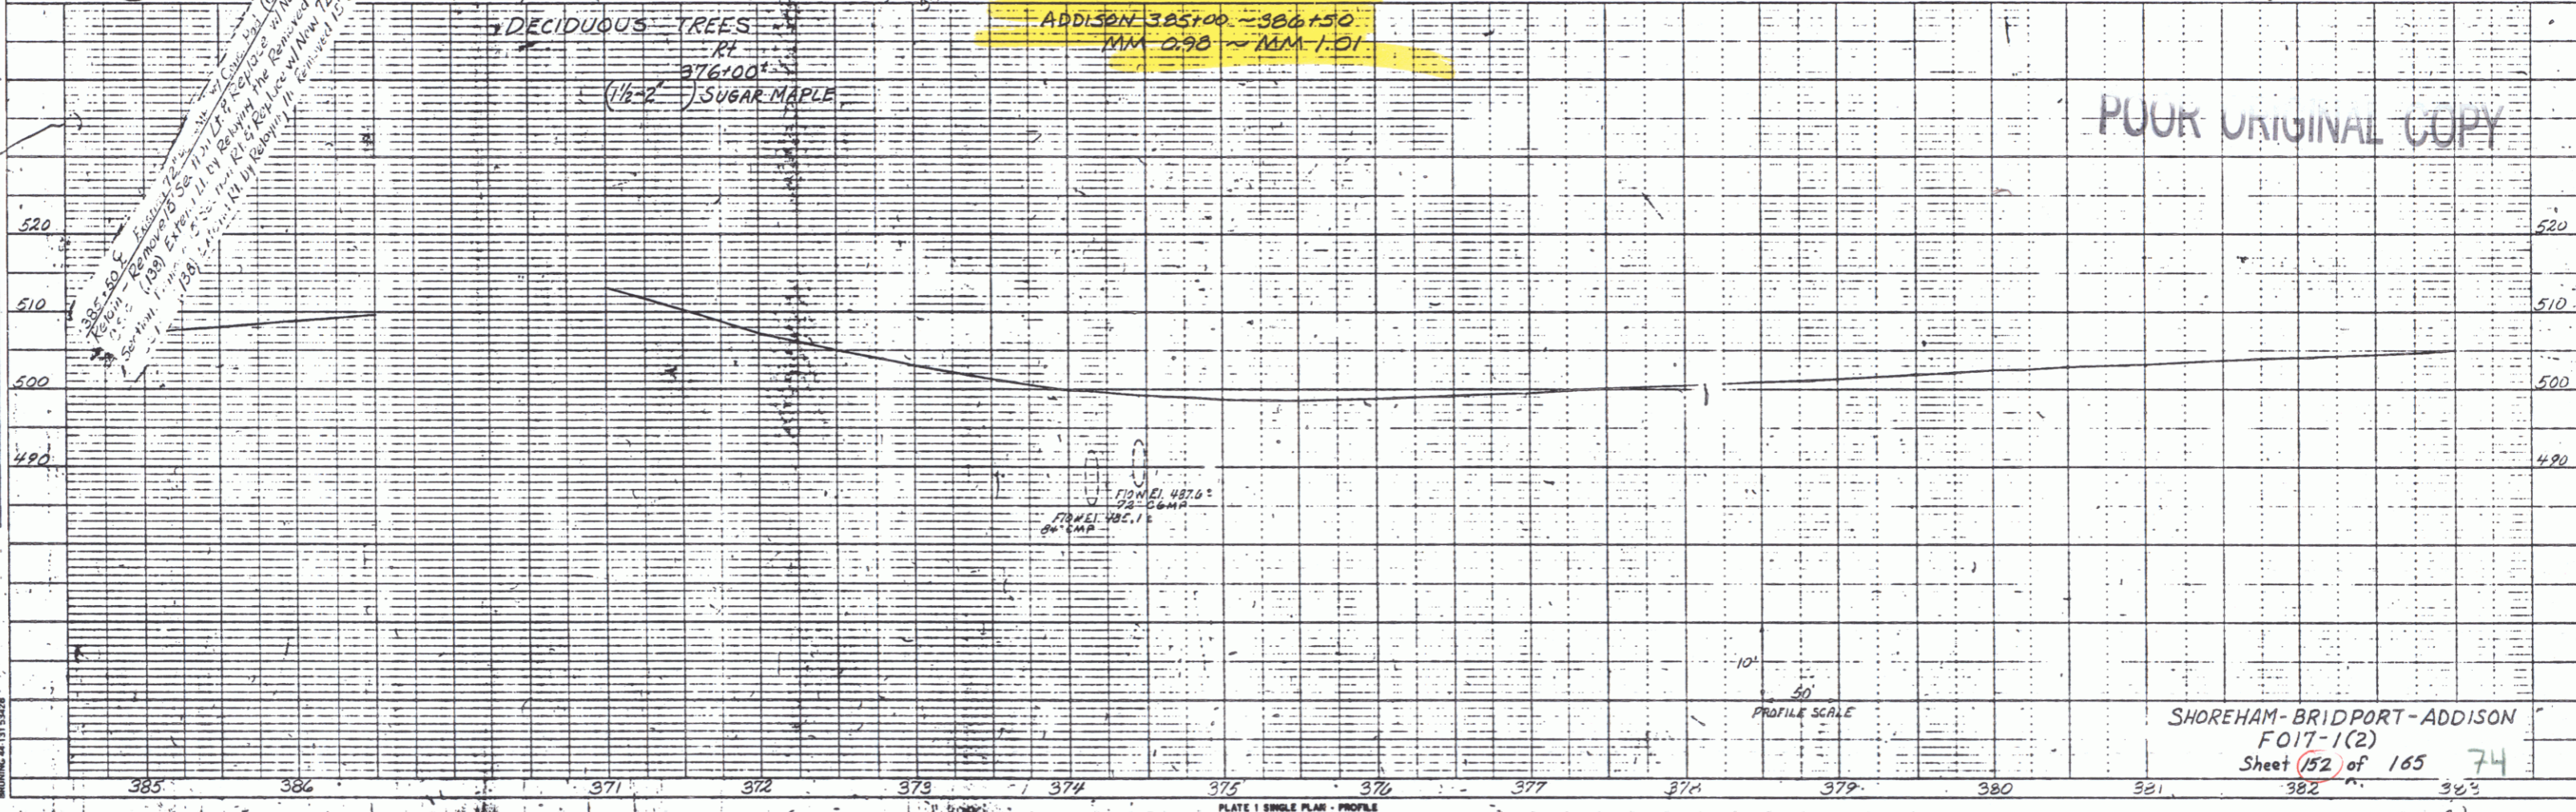

POOR ORIGINAL COPY

SHOREHAM-BRIDPORT-ADDISON  
FO17-1(2)  
Sheet 152 of 165 74