

5103 1946 16 117

JOHNSON, THOMAS M. & ELLA L.

PARKINSON, JAMES R. & LOUISE H.

GEVRY, RHEAL P. SR., & GAIL L.

VANIER, BERNARD J. & FLEUR ANGE L.

HEATH & WALDRON


POOR ORIGINAL COPY

ADDISON 406+00 ~ 416+00  
MM 1.38 ~ MM 1.57

MAY 05 1994

PLAN	DATE	BY
DESIGNED	1946	W. J. ...
CHECKED		
IN CHARGE		
NO. OF SHEETS		12
NO.		77

PROFILE	DATE	BY
DESIGNED	1946	W. J. ...
CHECKED		
IN CHARGE		
NO. OF SHEETS		12
NO.		77

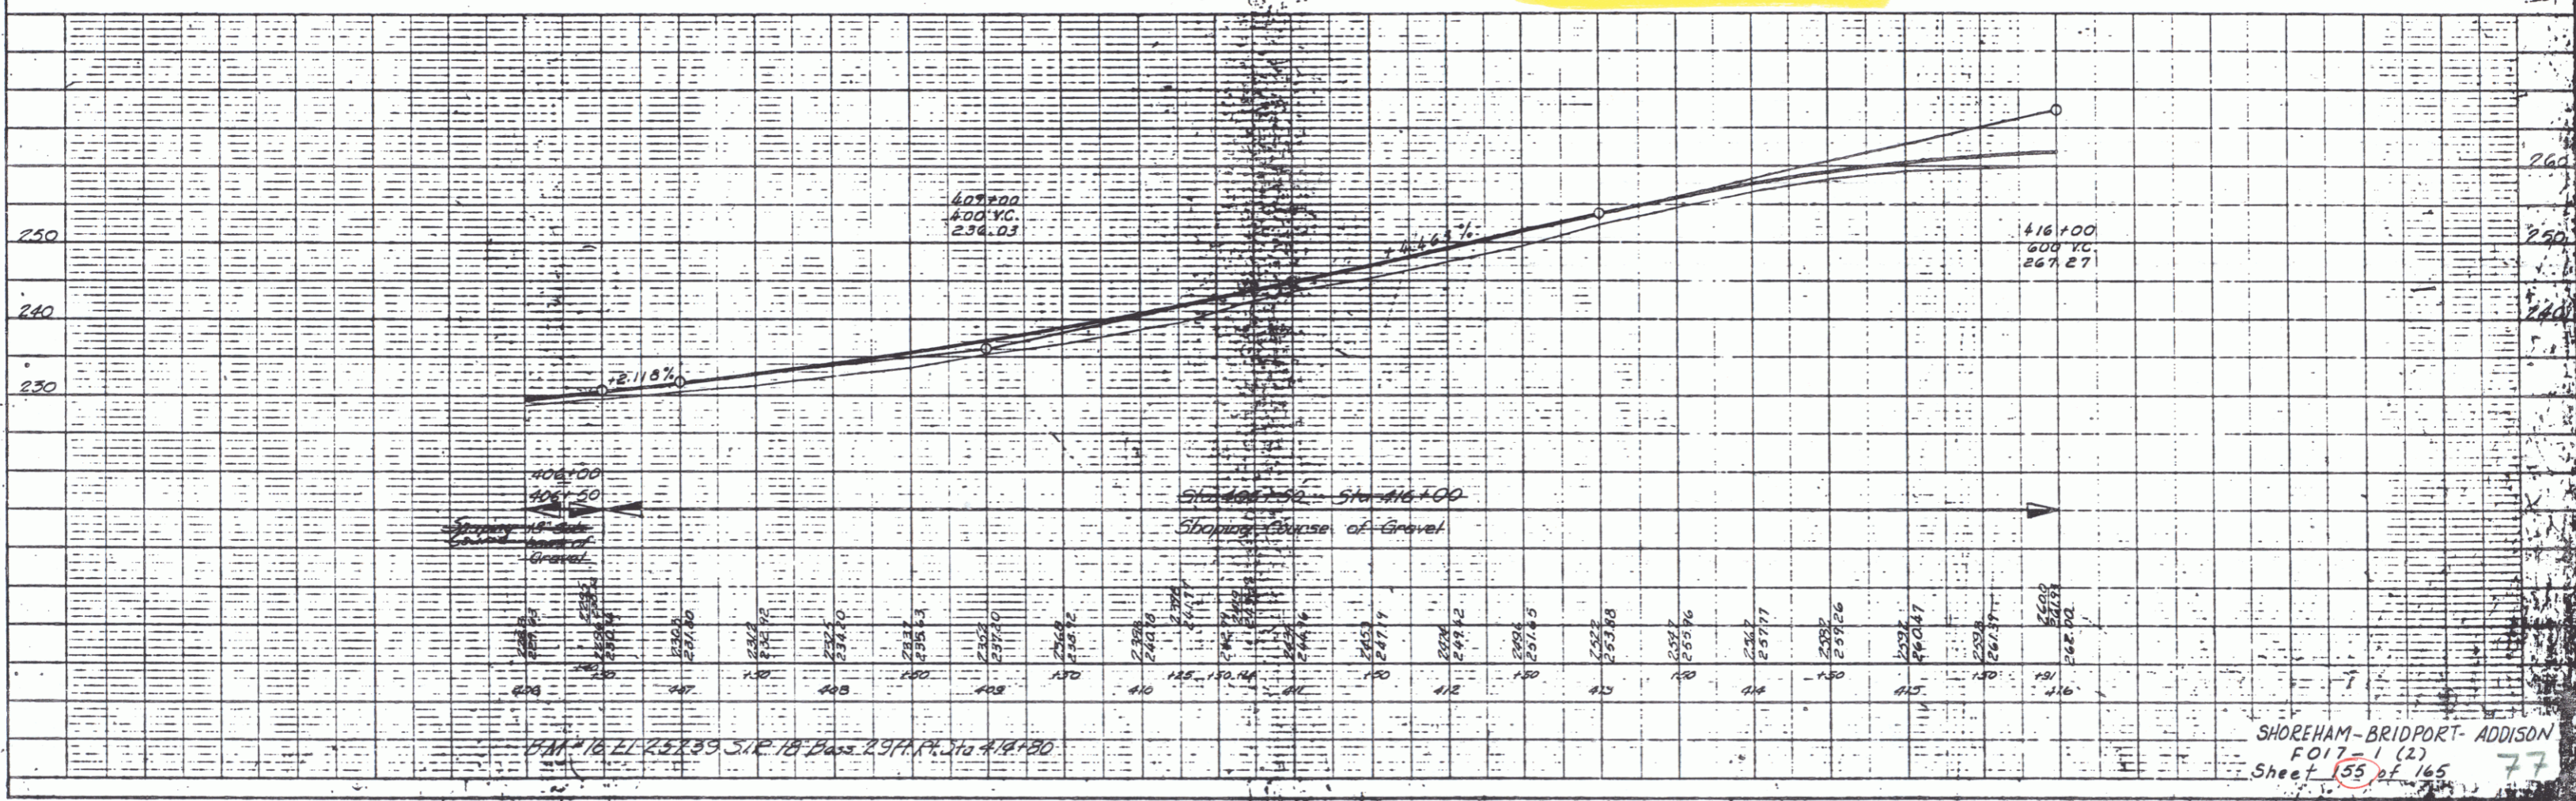

SHOREHAM-BRIDPORT-ADDISON  
FO 17 (2)  
Sheet 55 of 165  
77