
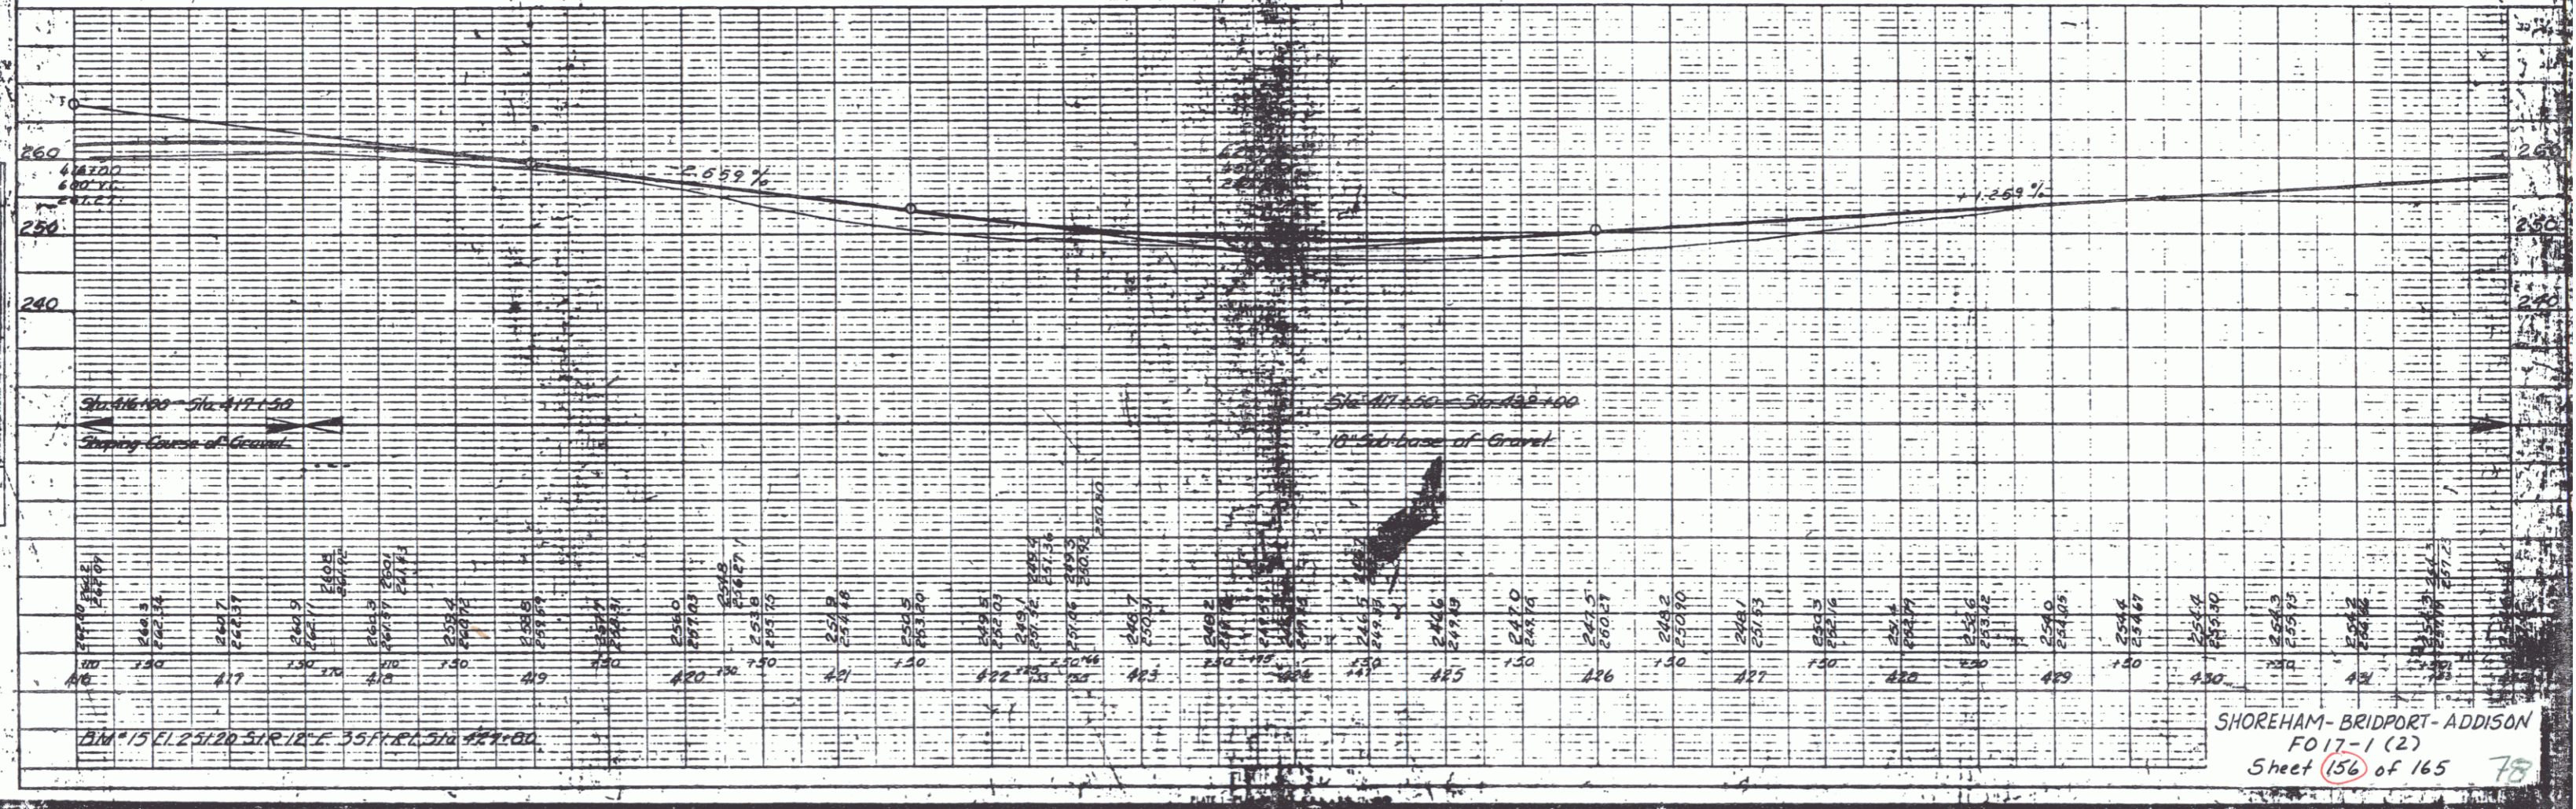


| | | | |
|-----------|-------------|------|-------|
| PLAN | DATE | BY | CHKD. |
| APPROVED | | | |
| REVISIONS | | | |
| NO. | DESCRIPTION | DATE | BY |

| | | | |
|-----------|-------------|------|-------|
| SCALE | DATE | BY | CHKD. |
| APPROVED | | | |
| REVISIONS | | | |
| NO. | DESCRIPTION | DATE | BY |

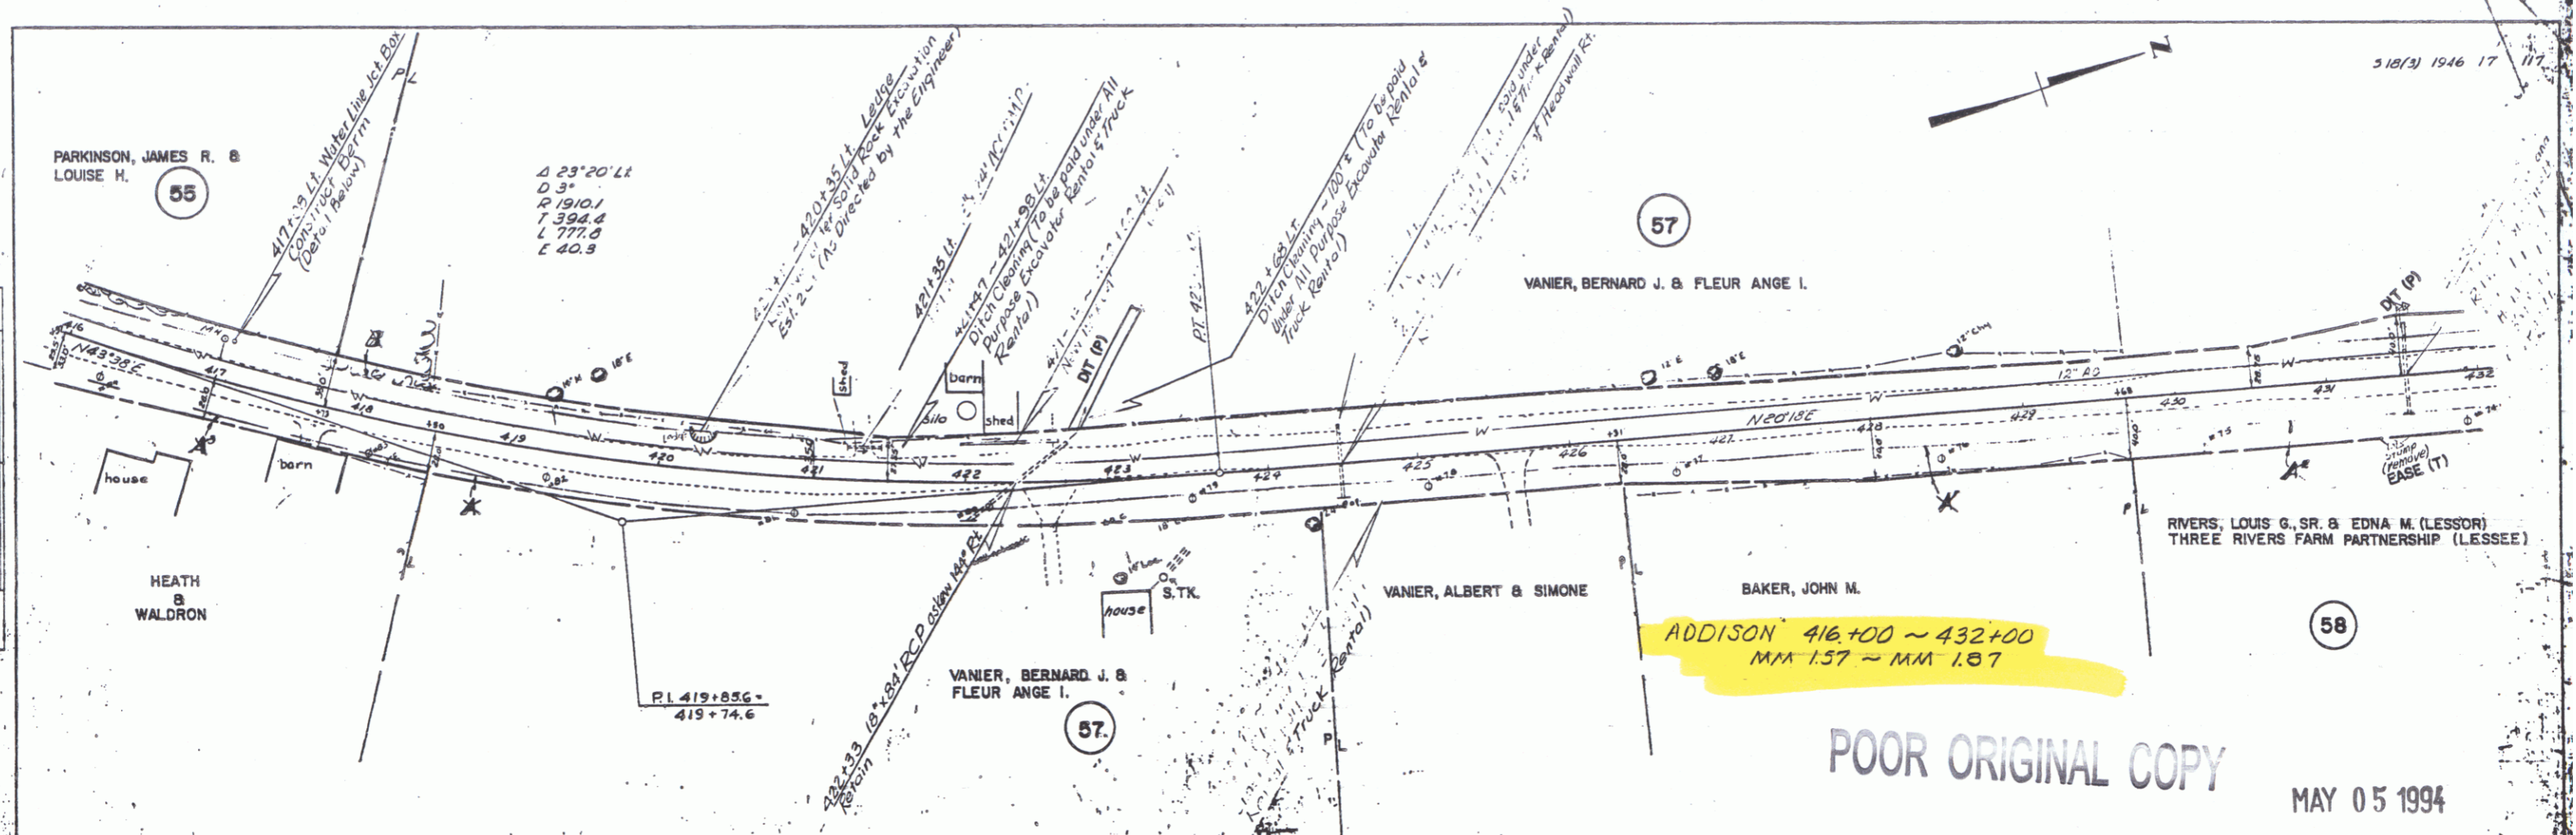

SHOREHAM-BRIDPORT-ADDISON
FO17-1 (2)
Sheet 156 of 165 78