



CONSTRUCT TURNOUT (Mailbox)
517+25 - 517+75 LT.
REMOVING AND RESETTING MAILBOXES
517+50 LT.

5/18/93 1946 23 117

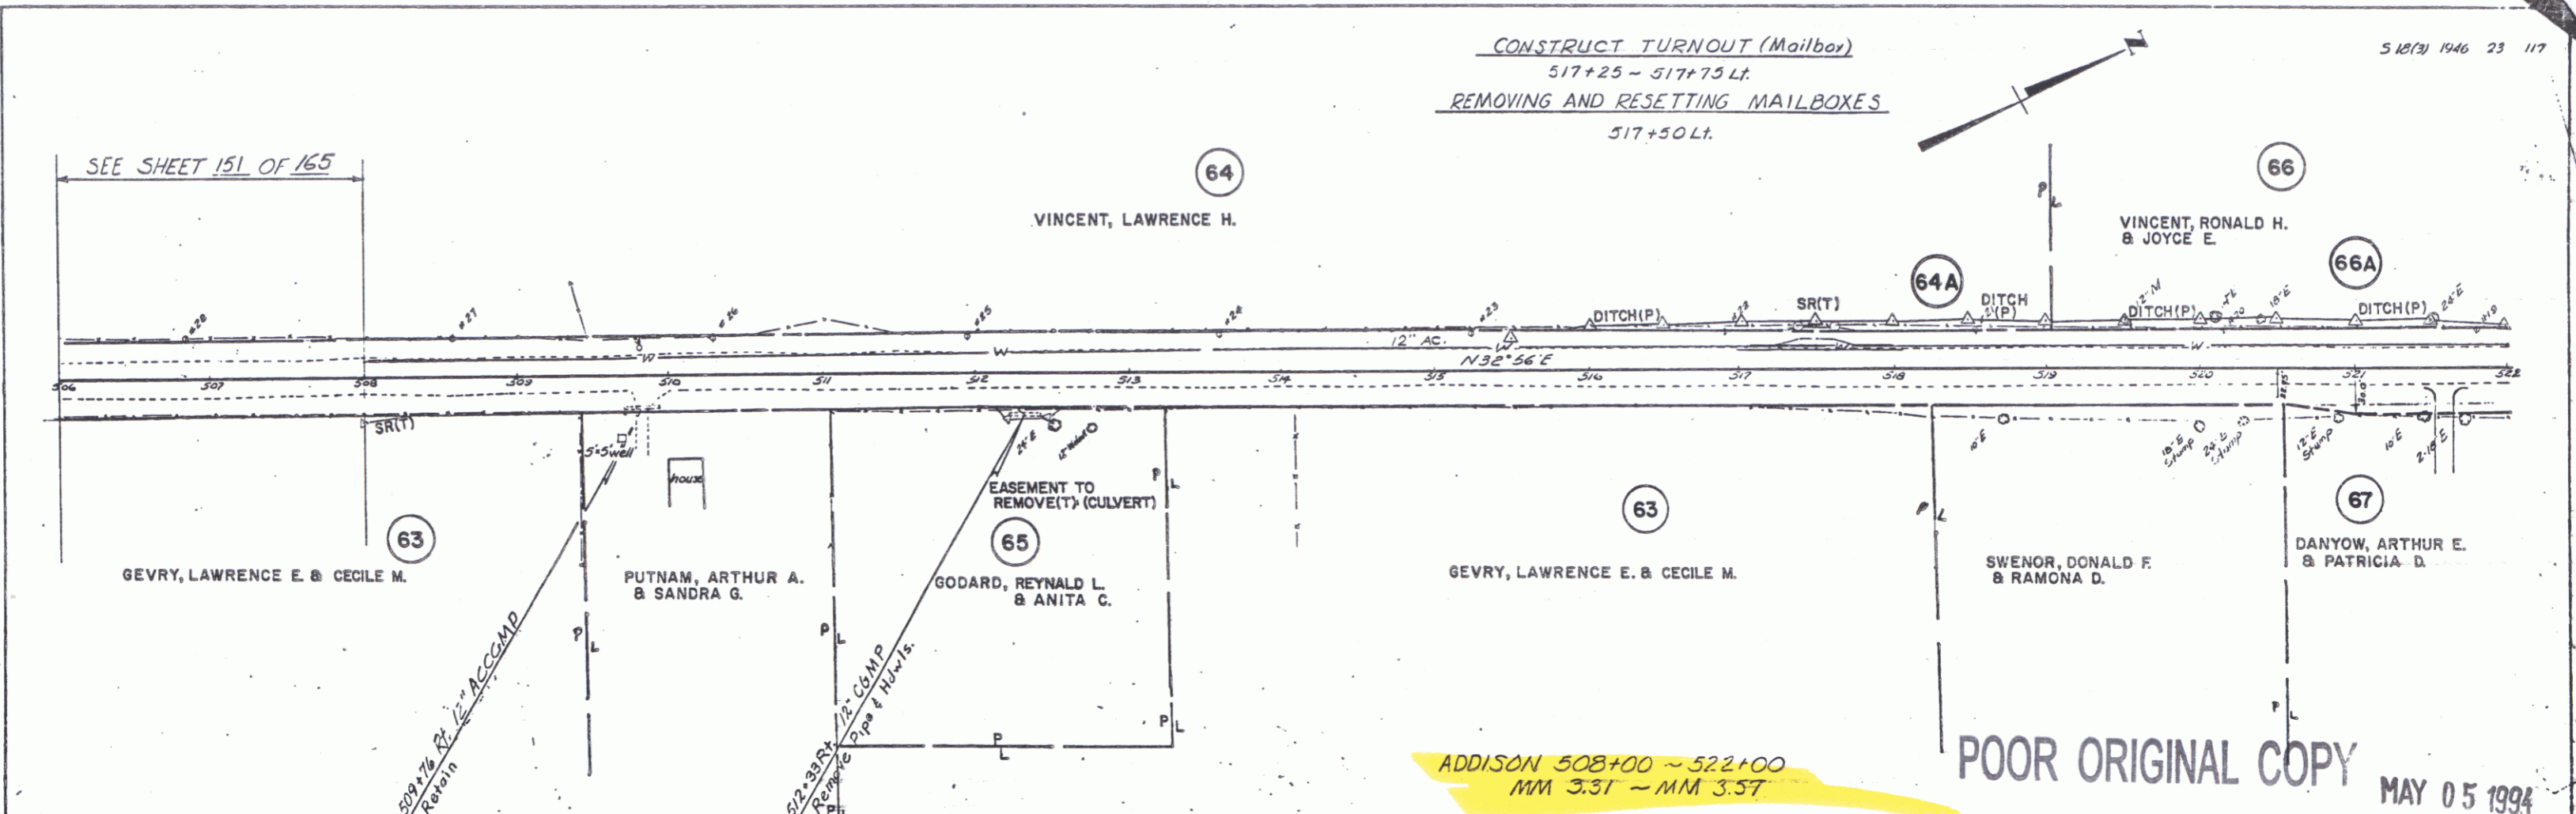

ADDISON 508+00 - 522+00
MM 3.31 - MM 3.57

POOR ORIGINAL COPY
MAY 05 1994

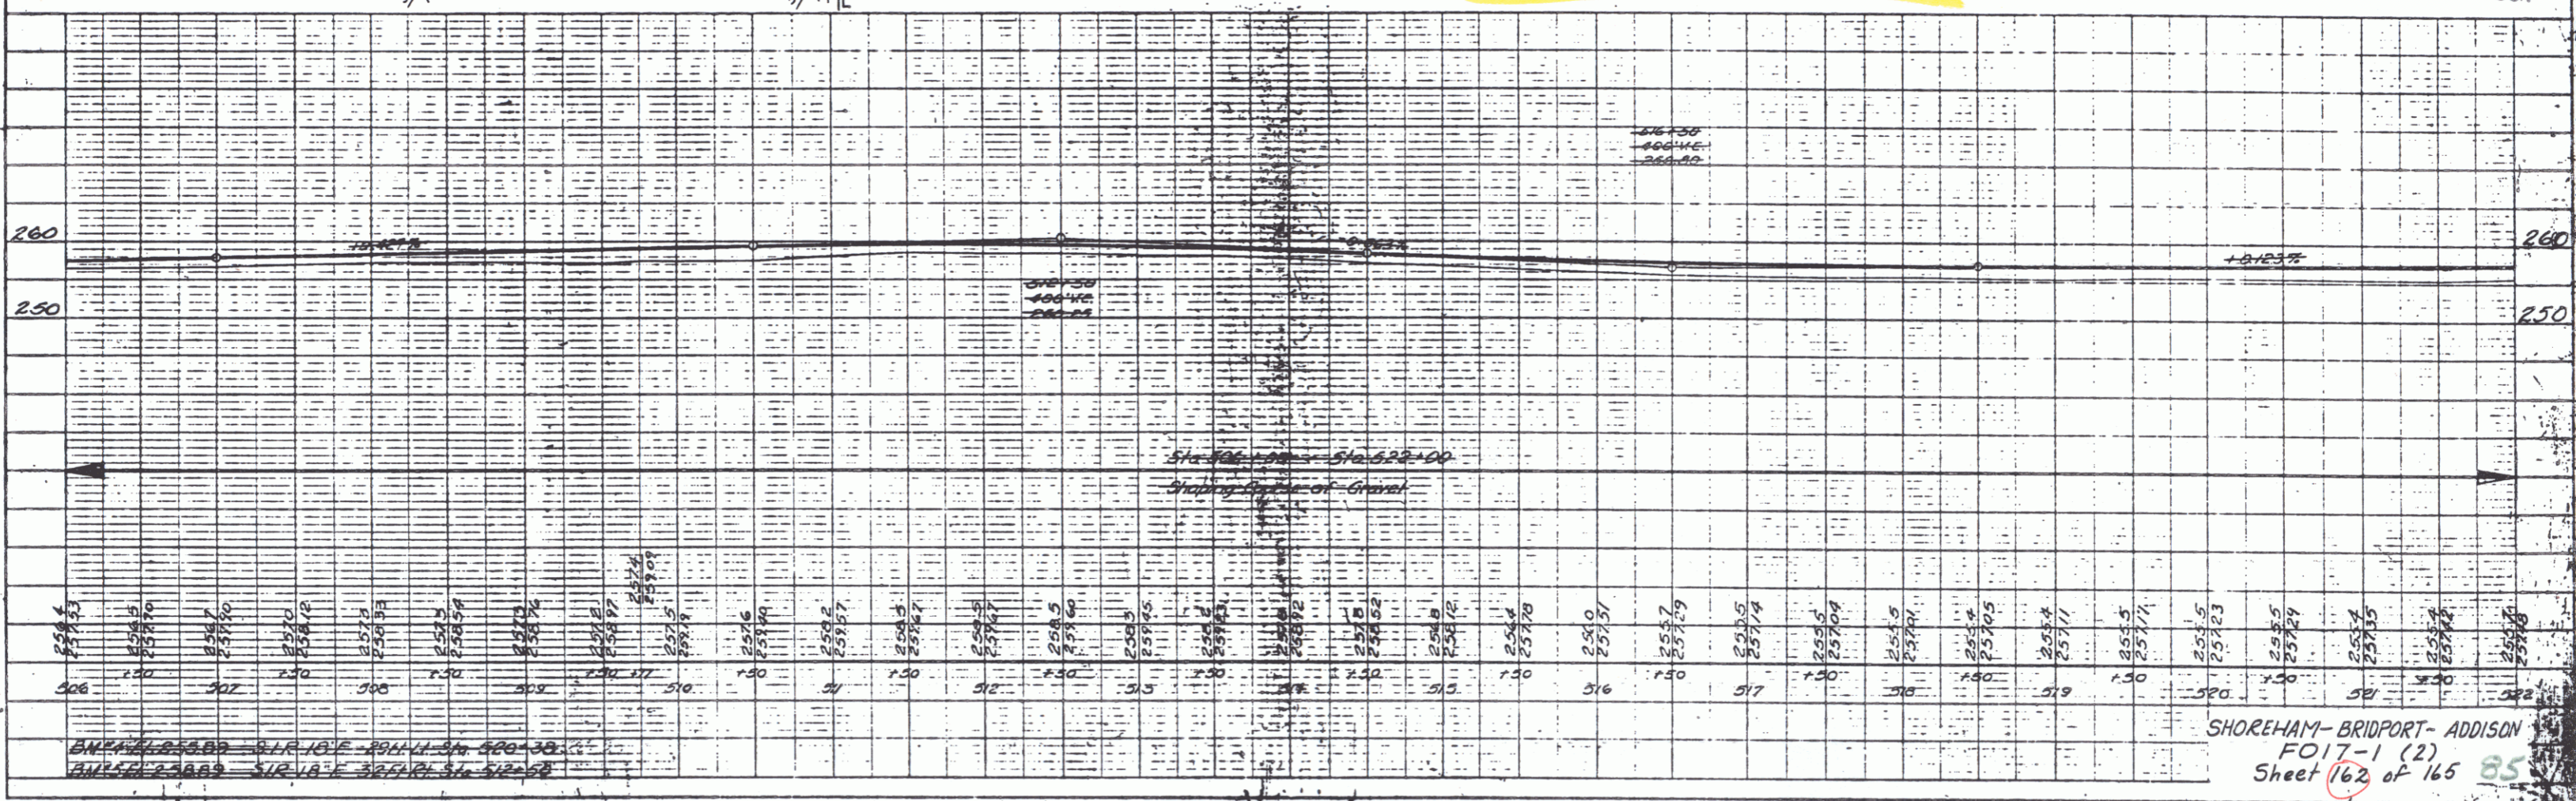

PLAN

DATE	5/18/93
BY	W. J. ...
CHECKED BY	...
SCALE	AS SHOWN

PROFILE

DATE	5/18/93
BY	W. J. ...
CHECKED BY	...
SCALE	AS SHOWN

SHOREHAM-BRIDPORT-ADDISON
FO17-1 (2)
Sheet 162 of 165 85