


PROPERTY OWNERS
PROPERTY ADDRESS
PROPERTY CHARGE
PROPERTY VALUE
PROPERTY TAX
PROPERTY DATE

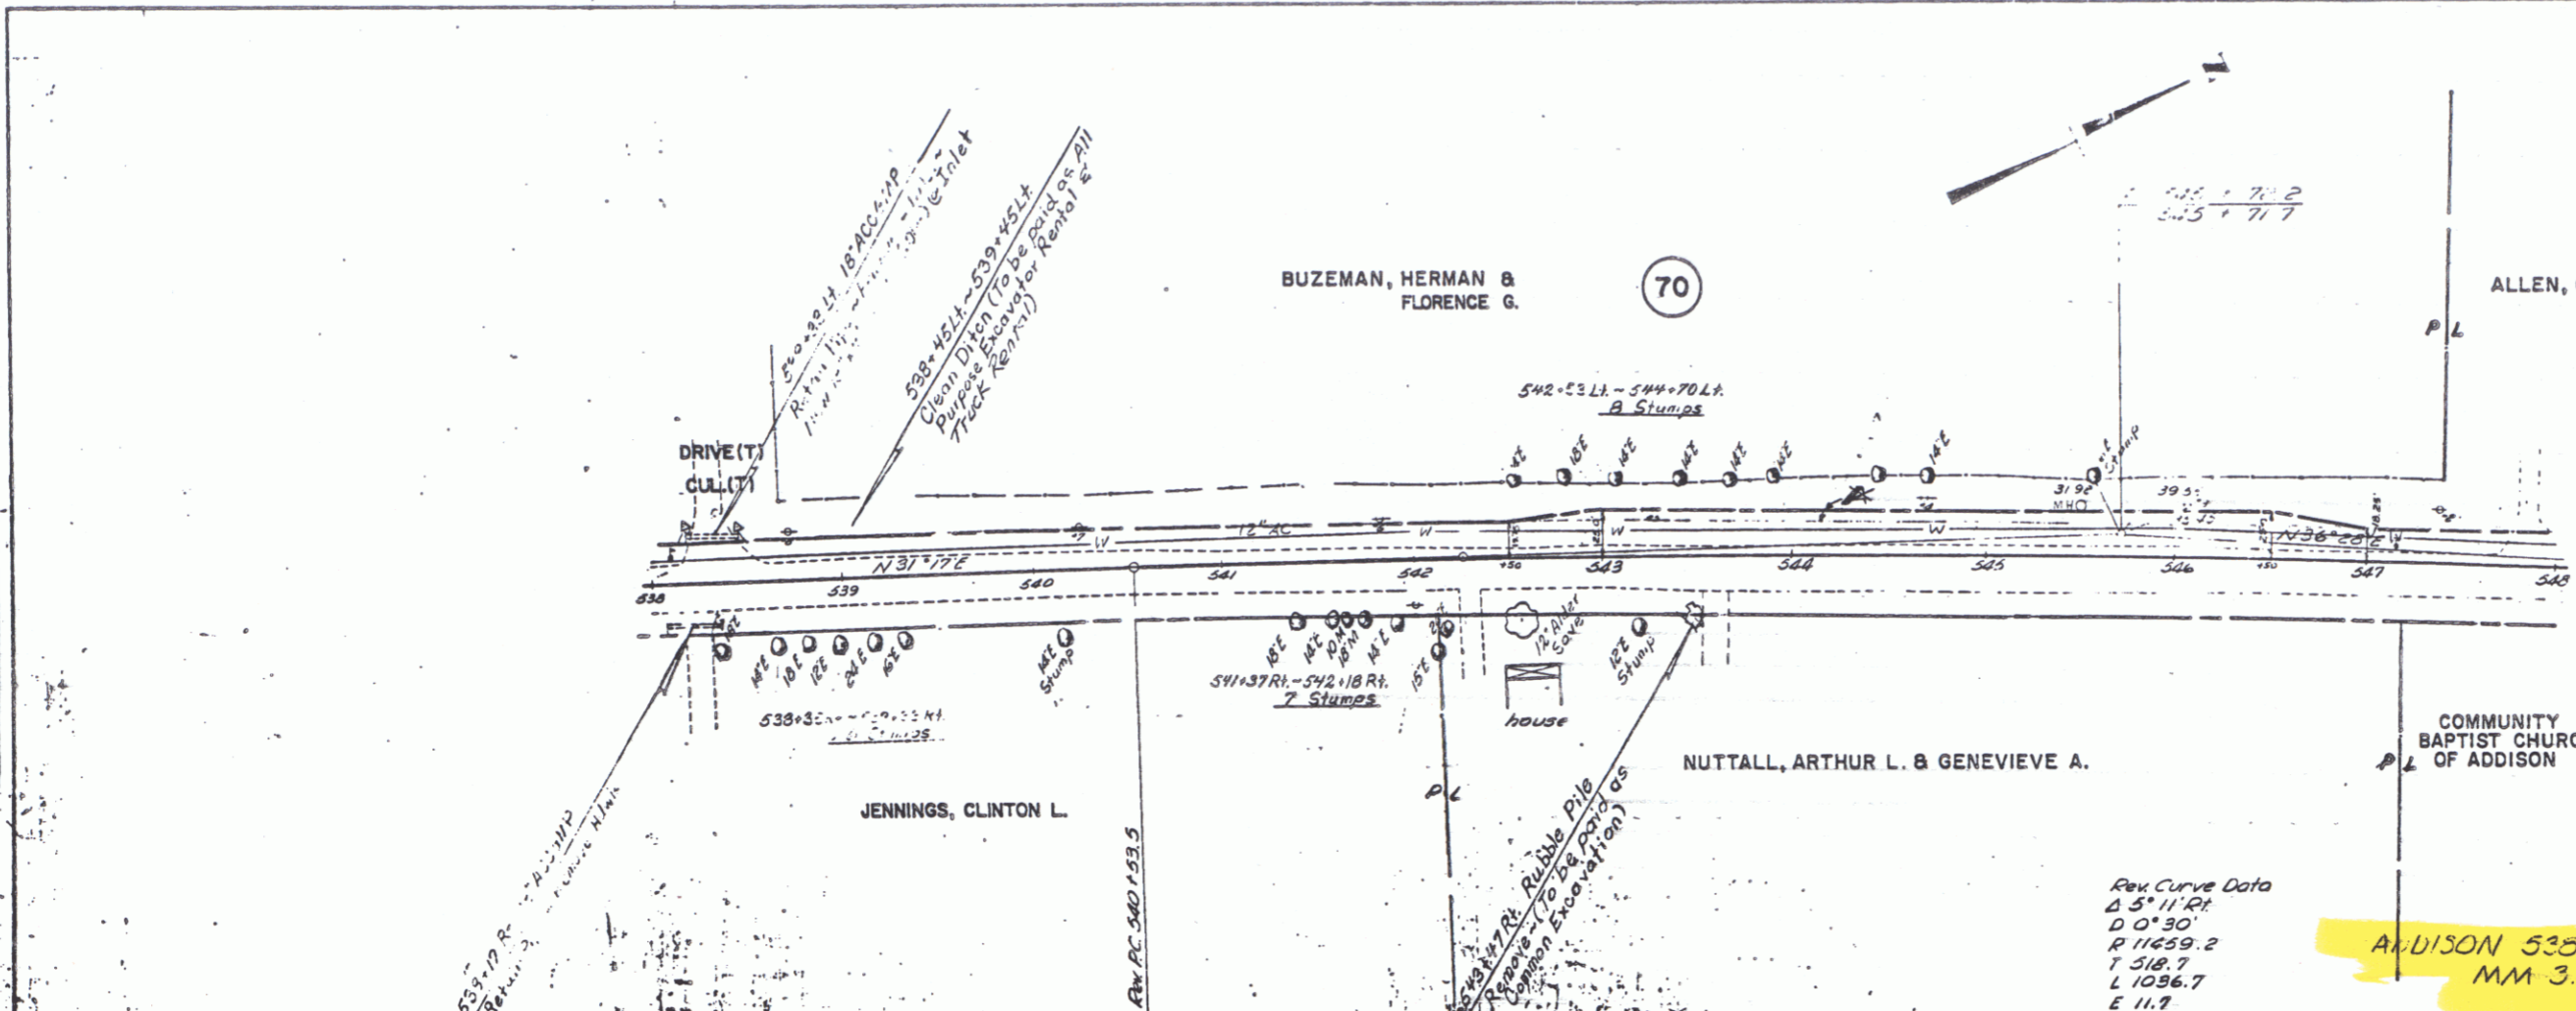


Rev Curve Data
 Δ 5° 11' 21"
 D 0° 30'
 R 11639.2
 T 518.7
 L 1036.7
 E 11.7

ADDISON 535+00 ~ 548+00
 MM 3.88 - MM 4.07

MAY 05 1994

POOR ORIGINAL COPY

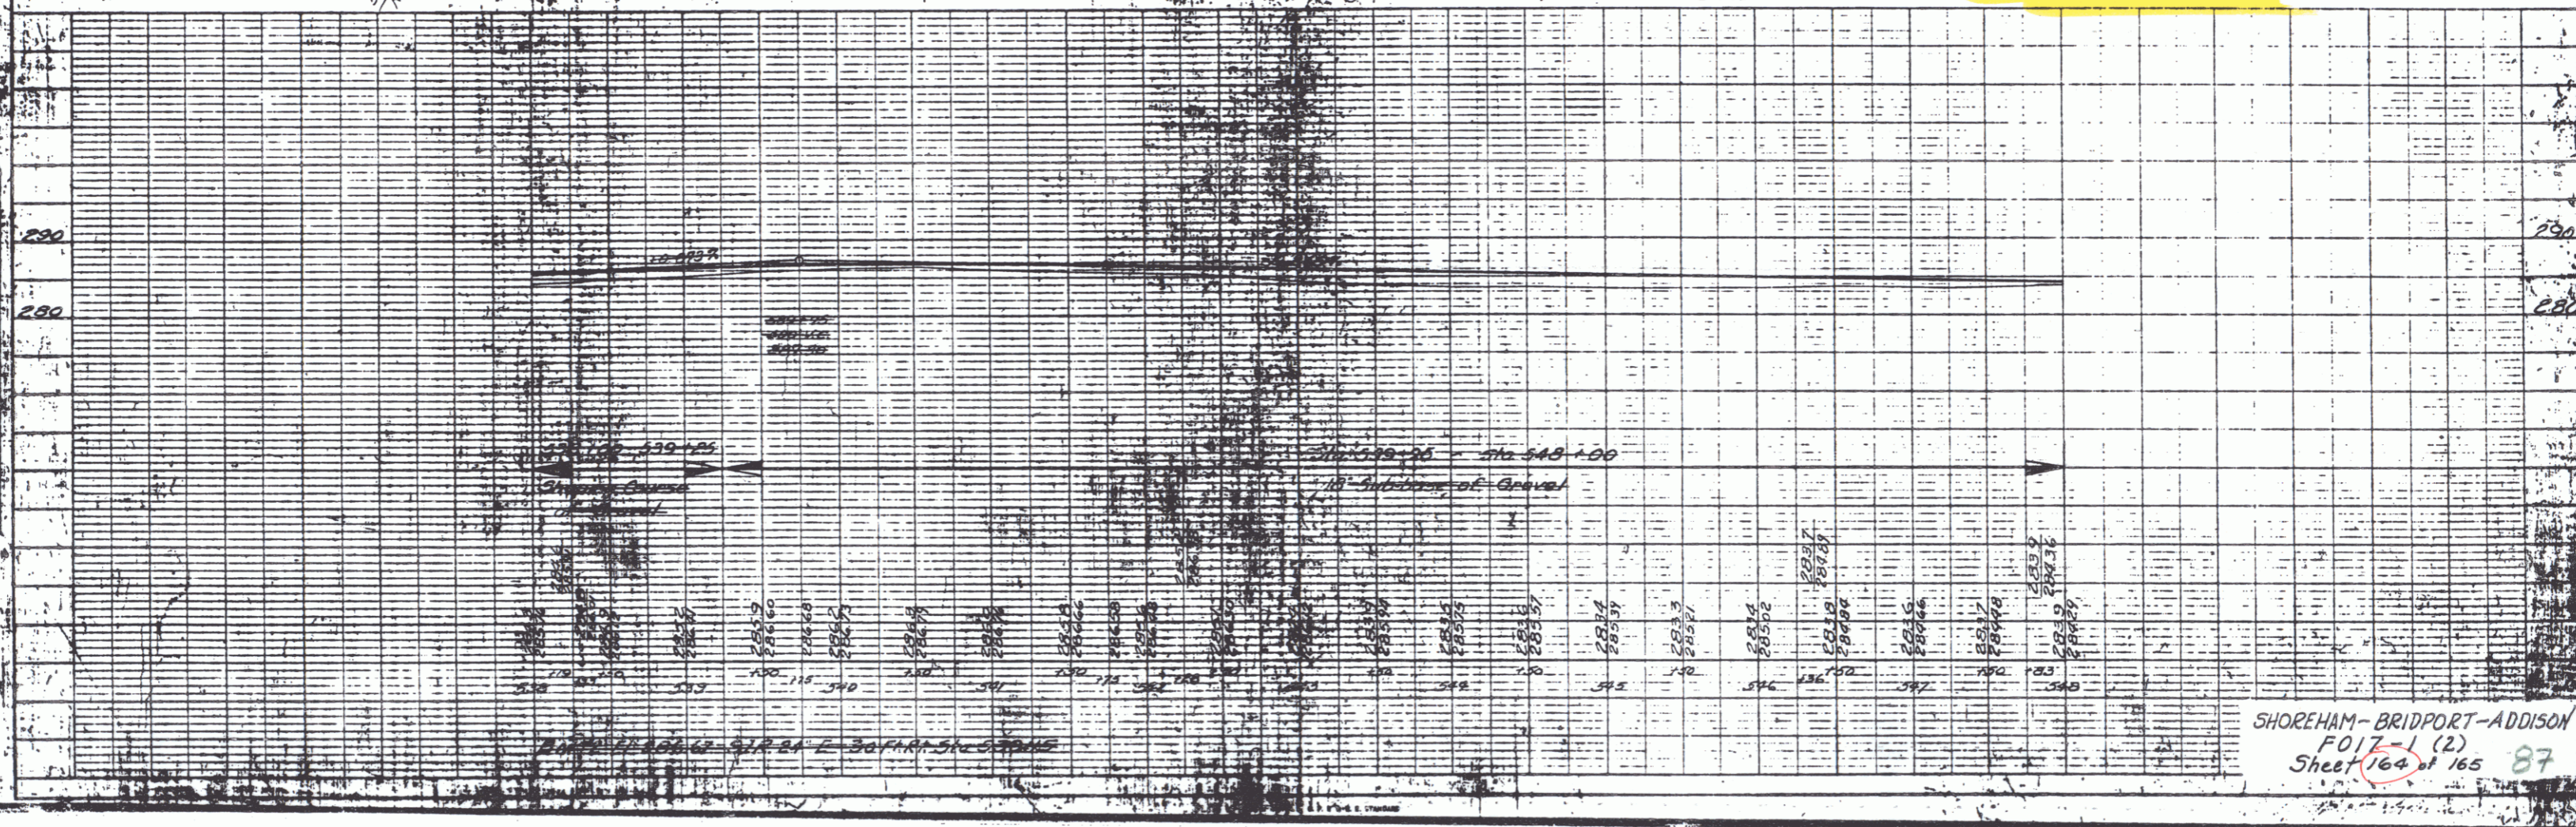

SHOREHAM - BRIDPORT - ADDISON
 F017-1 (2)
 Sheet 164 of 165 87