


PLAN  
 DRAWN BY: [Signature]  
 CHECKED BY: [Signature]  
 DATE: 12/14/15  
 PROJECT: [Project Name]

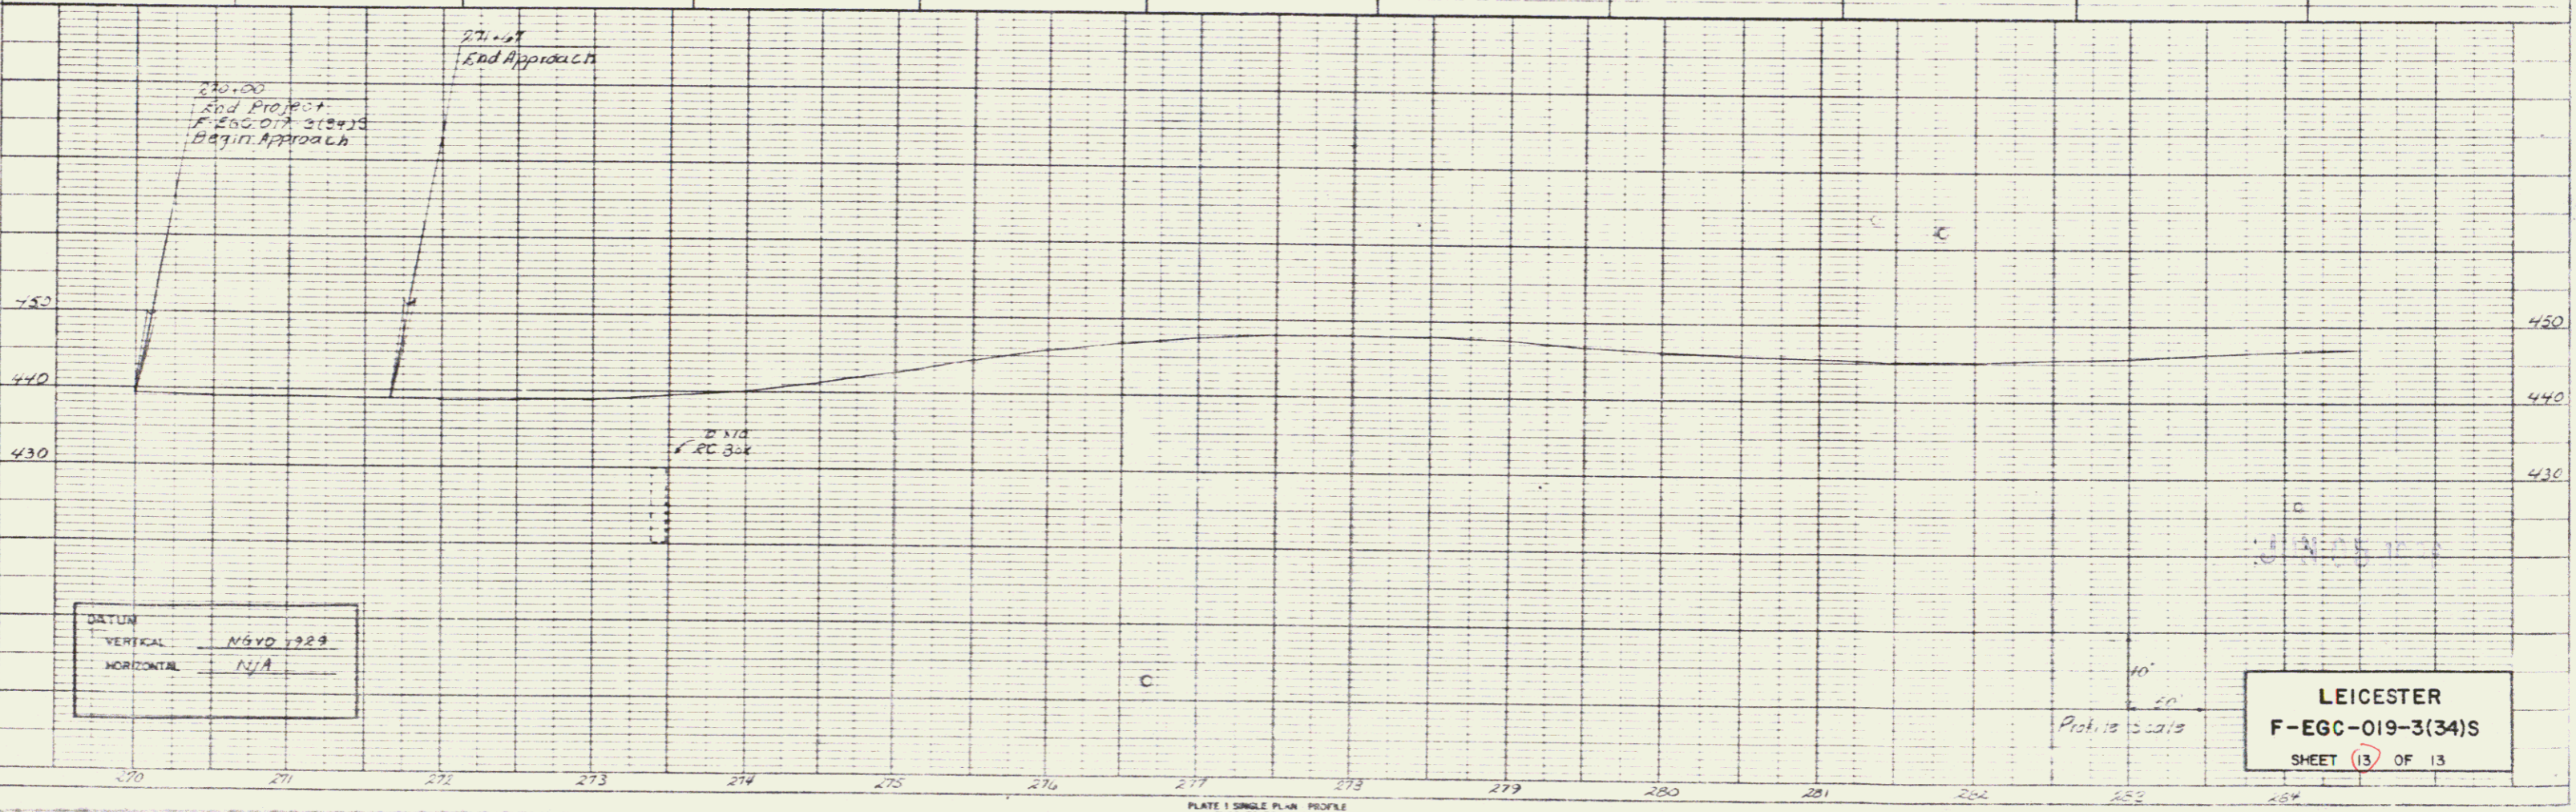

PROFILE  
 DRAWN BY: [Signature]  
 CHECKED BY: [Signature]  
 DATE: 12/14/15  
 PROJECT: [Project Name]