
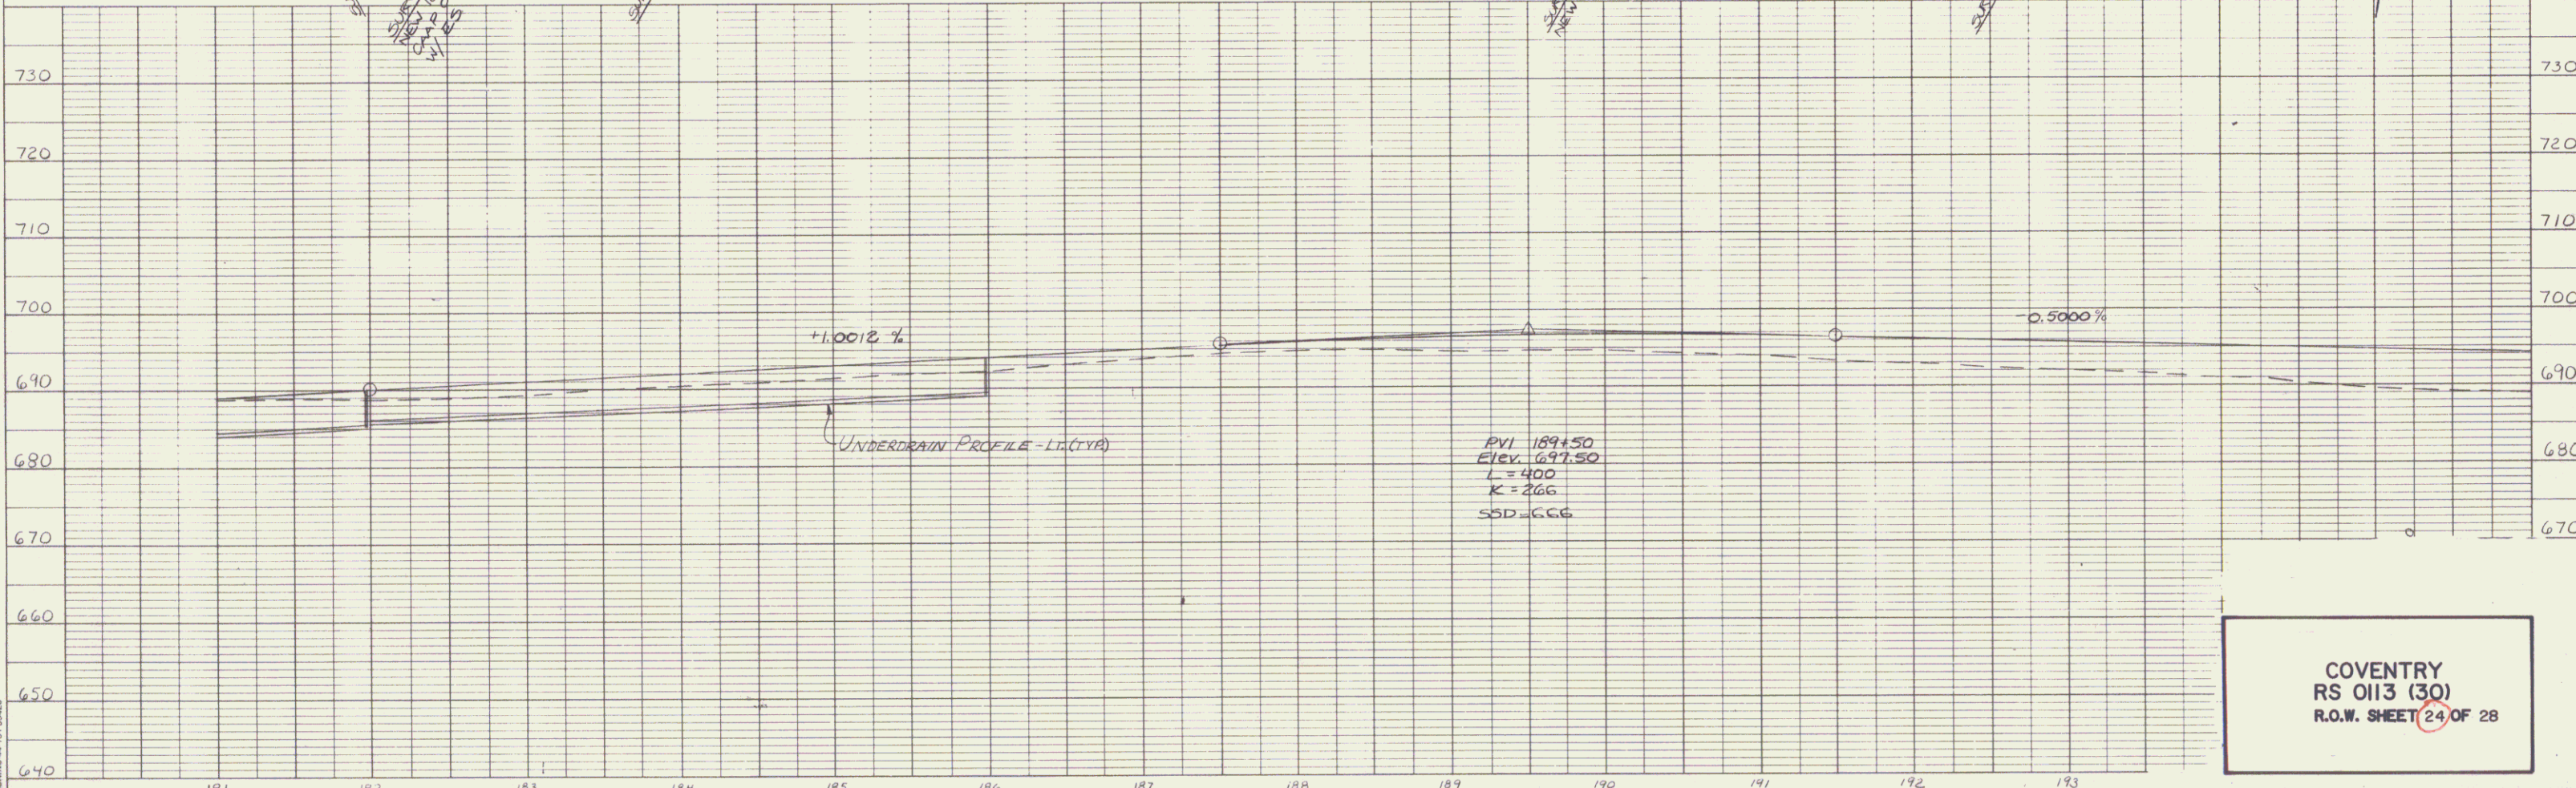


NOTE: NO CLEARING & GRADING ALLOWANCE WILL BE PERMITTED OUTSIDE THE CONSTRUCTION LIMITS FROM STA 182+00 RT - 192+50 RT.

DATE	BY
02/22/20	CS/ALM
REVISIONS	
1. PLANNING	CS/ALM
2. DESIGN	CS/ALM
3. CHECKED	CS/ALM
4. APPROVED	CS/ALM
5. AS BUILT	CS/ALM

DATE	BY
REVISIONS	
1. PROFILE	CS/ALM
2. CHECKED	CS/ALM
3. APPROVED	CS/ALM
4. AS BUILT	CS/ALM

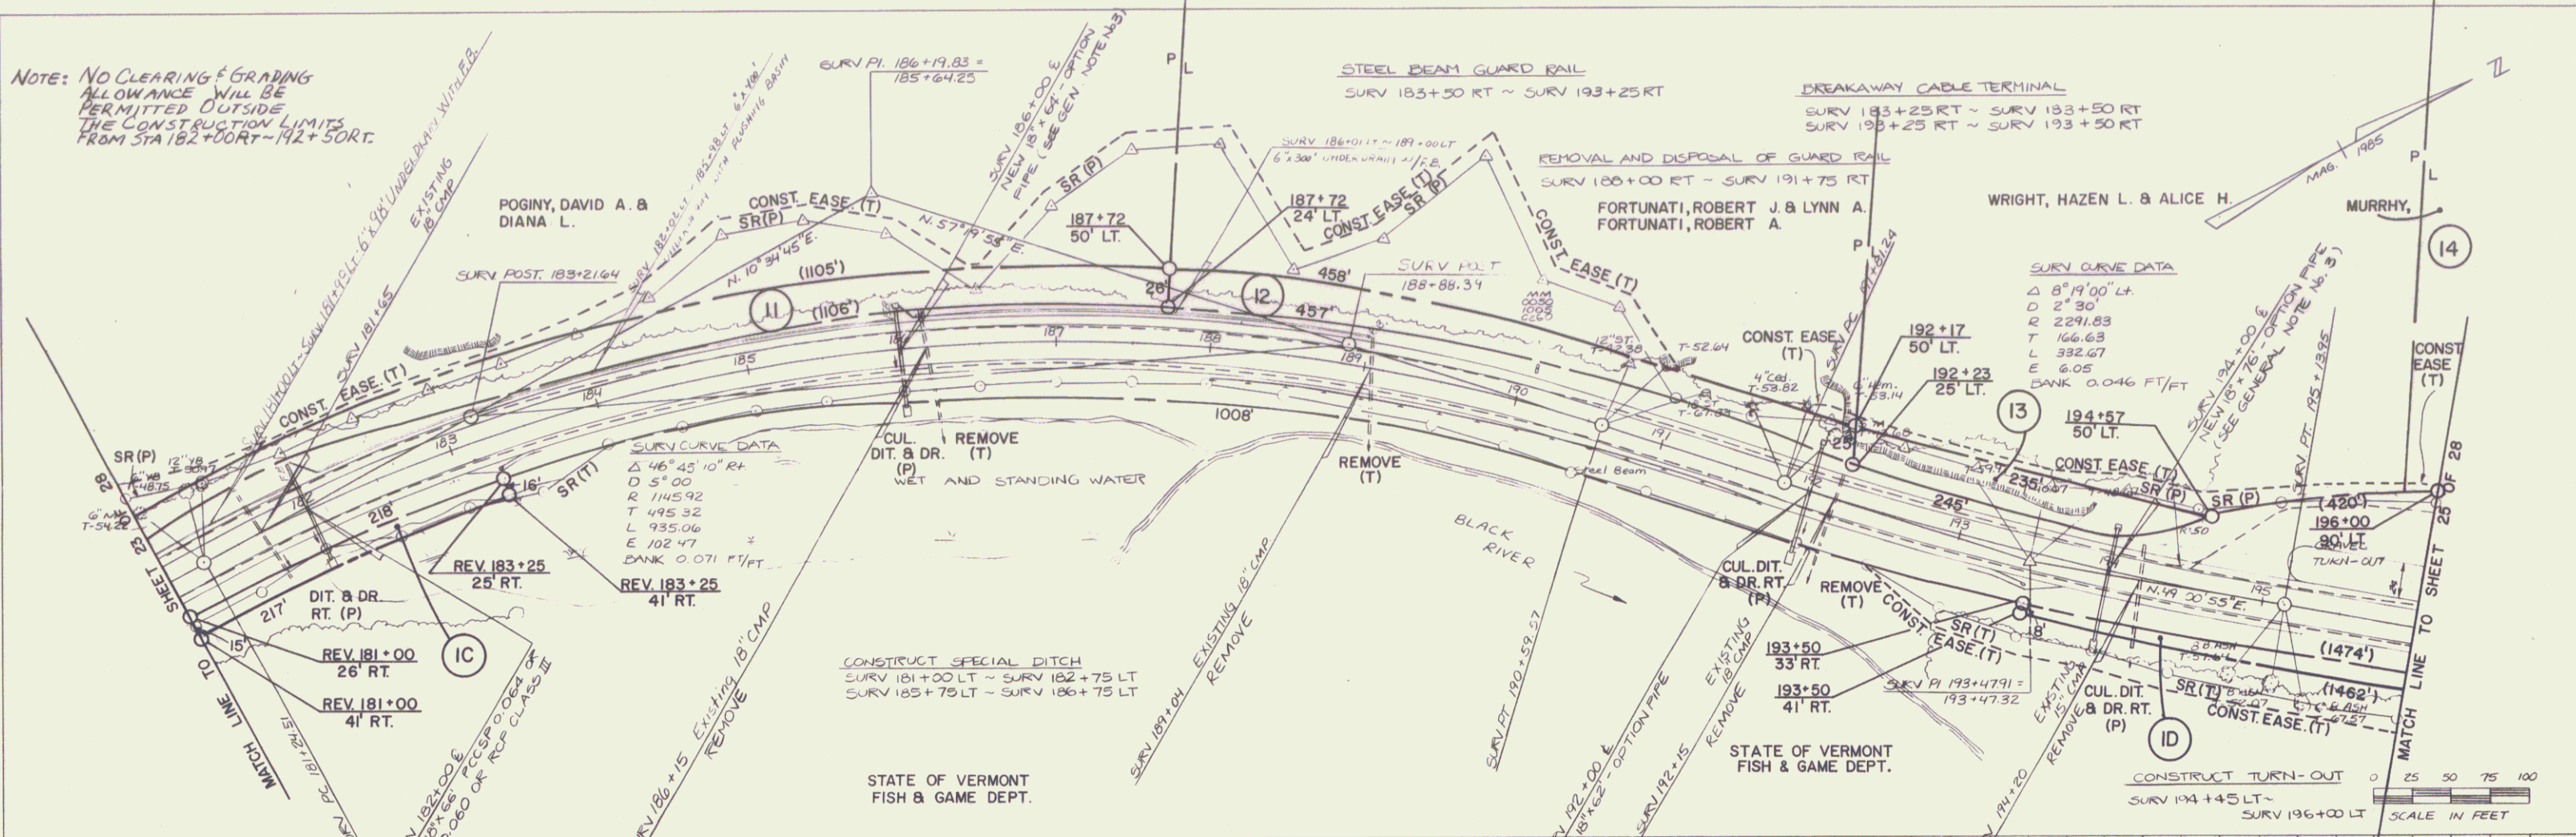

COVENTRY
RS 0113 (30)
R.O.W. SHEET 24 OF 28