


DATE	
PROJECT	
LOCATION	
CONTRACT NO.	
SHEET NO.	

DATE	
PROJECT	
LOCATION	
CONTRACT NO.	
SHEET NO.	

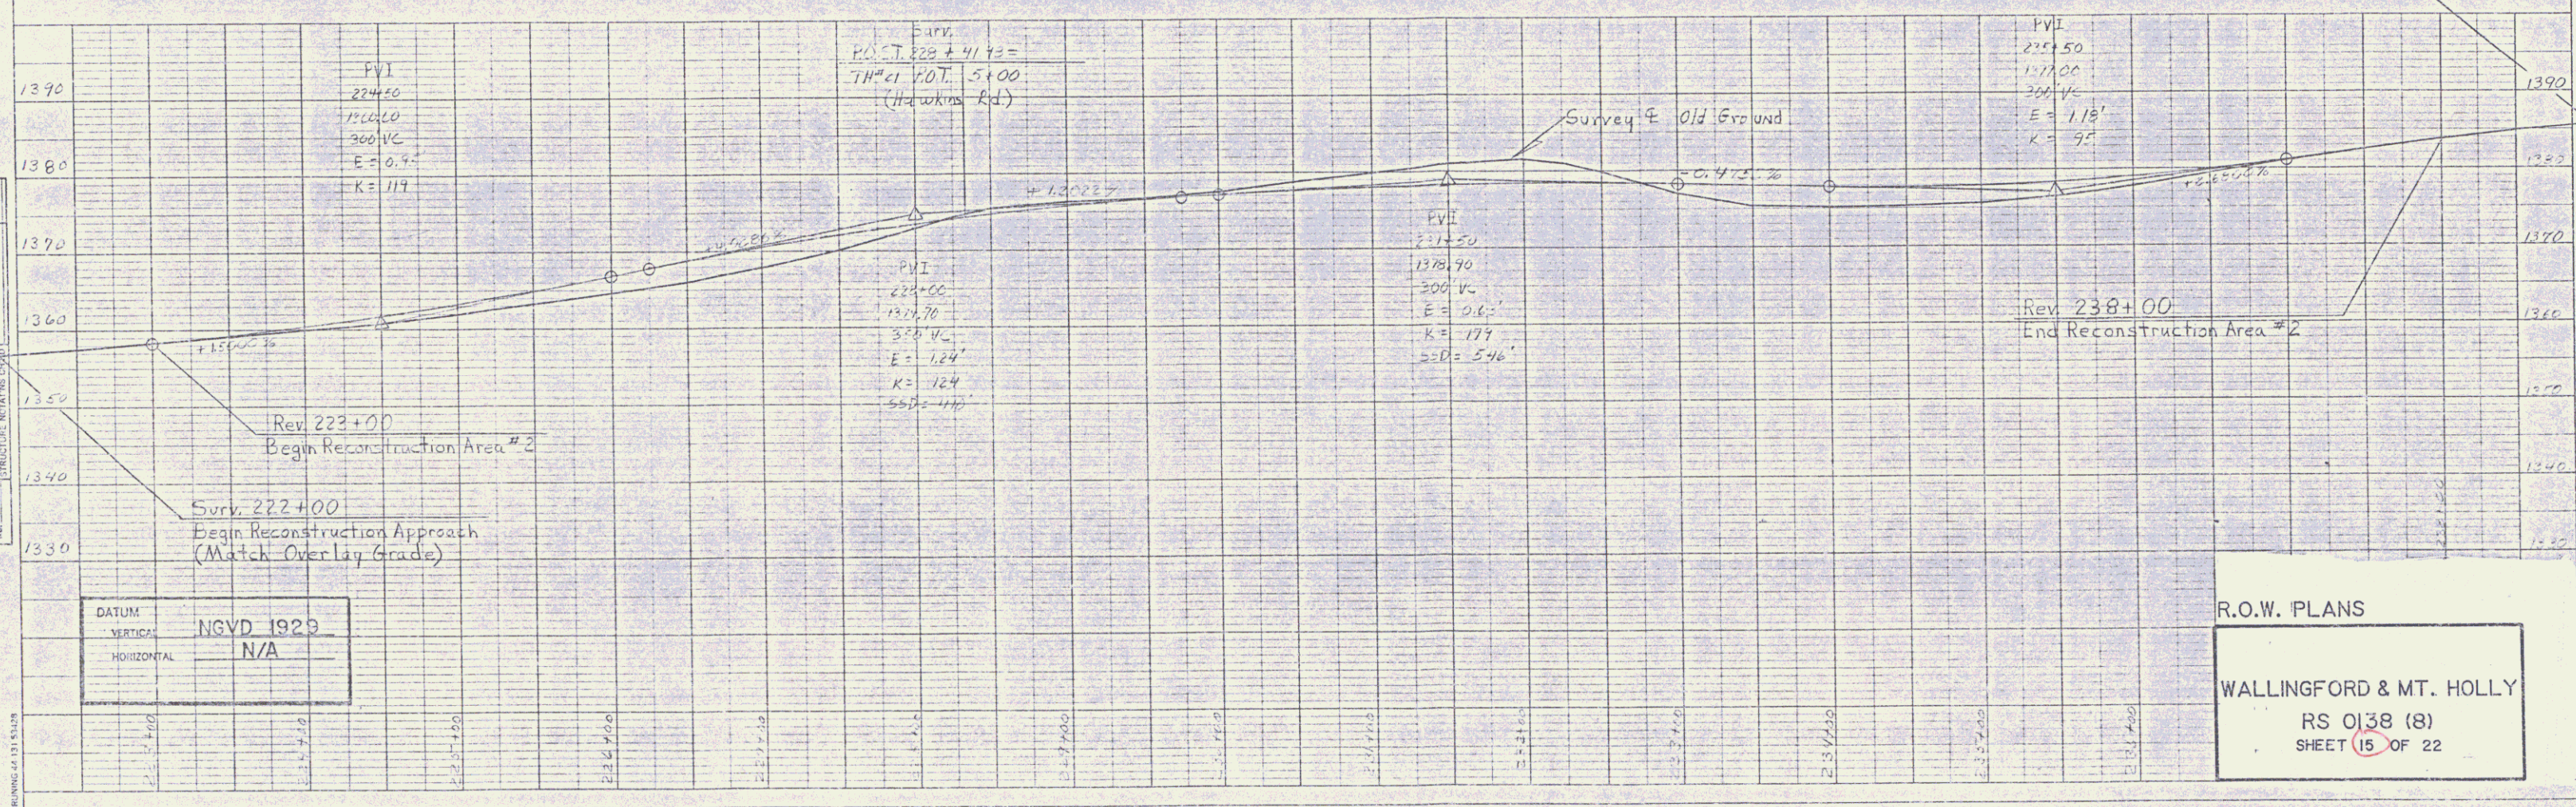

DATUM	NGVD 1929
VERTICAL	
HORIZONTAL	N/A

R.O.W. PLANS
 WALLINGFORD & MT. HOLLY
 RS 0138 (8)
 SHEET 15 OF 22

PLATE 1 SINGLE PLAN - PROFILE
 CHARLES BRUNING, ED.

MAR 19 1993

15