


SPECIAL DITCH (CONV. E & CAV)  
LT  
REV 282+25-283+20  
RT  
REV 284+50-285+00

CONSTRUCT DRIVE  
LT  
REV 283+38 (12' W. OF)

EROSION MATTINGS  
RT  
REV 279+00-280+00  
291+00-294+00

SCARIFYING PAVEMENT  
REV 280+50-281+50  
REV 284+50-SURV 287+50

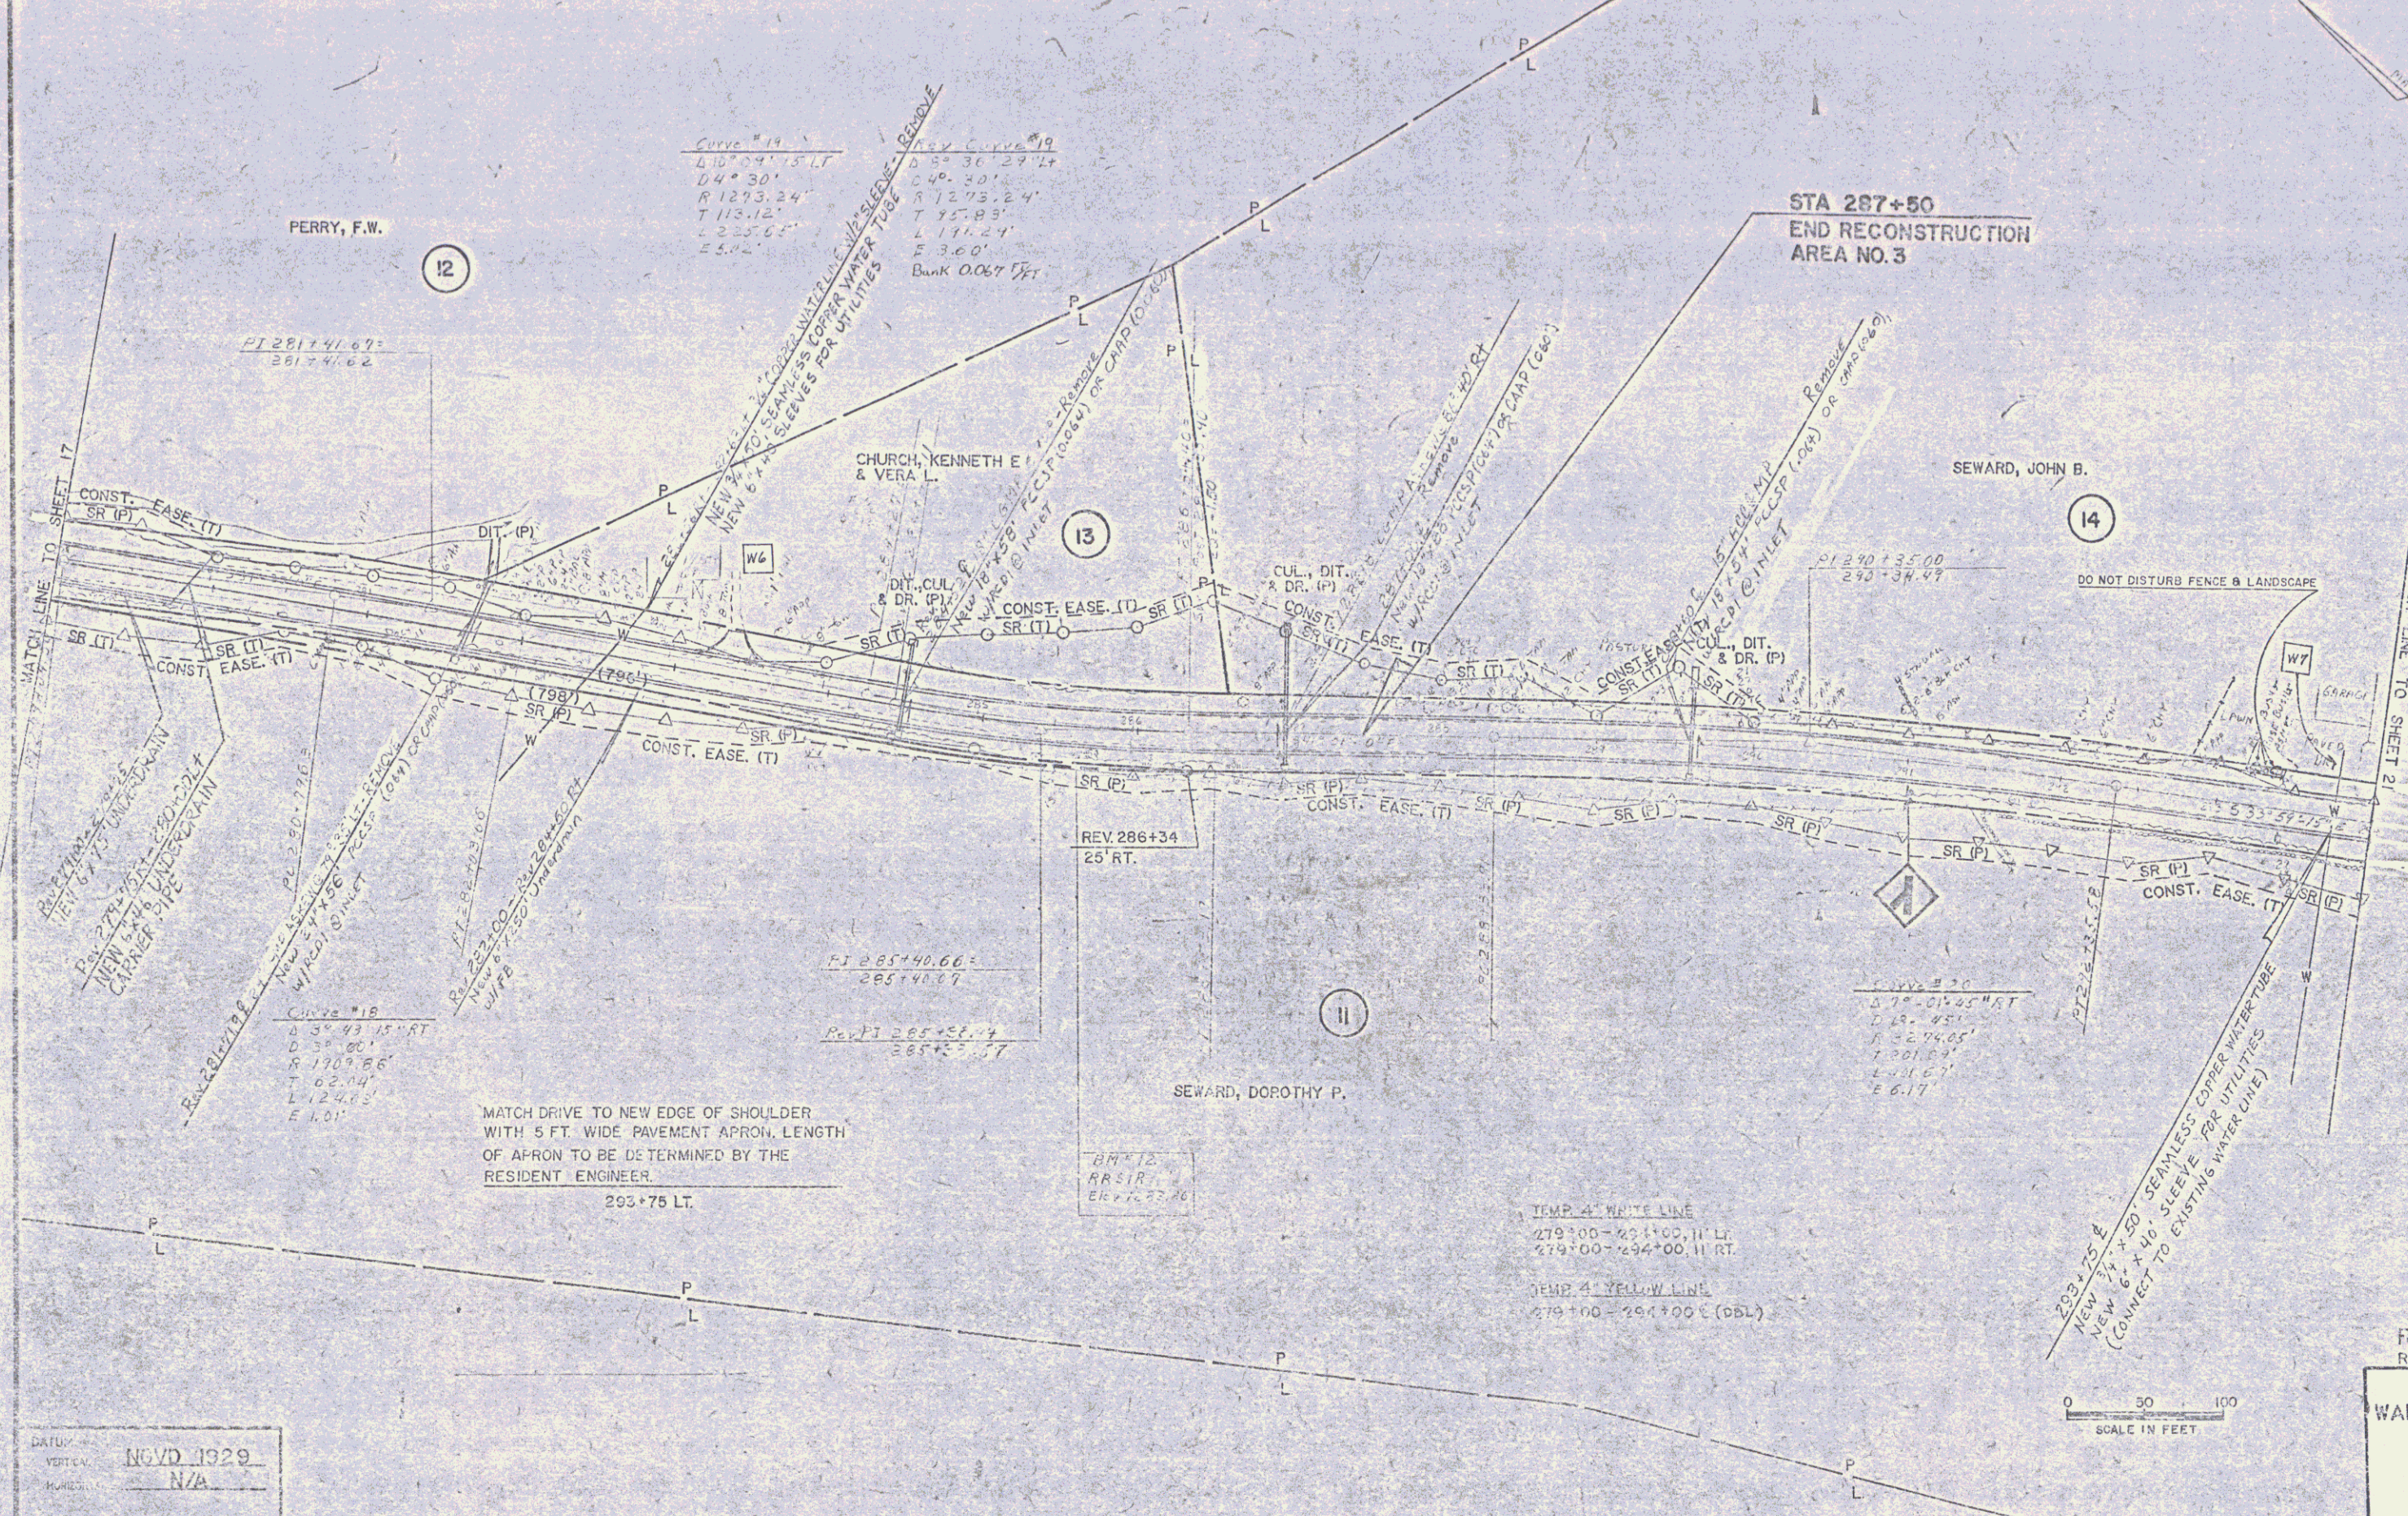

DATE: NOV 1929  
VERTIC: N/A  
NUMBER: N/A

0 50 100  
SCALE IN FEET

R.O.W. PLANS  
REV 278+00 - SURV 294+00  
WALLINGFORD- MT. HOLLY  
RS 0138 (8)  
SHEET 18 OF 22

MAR 19 1993