


PLAN  
 DATE: \_\_\_\_\_  
 DRAWN BY: \_\_\_\_\_  
 CHECKED BY: \_\_\_\_\_  
 DATE: \_\_\_\_\_

DATUM  
 VERTICAL: NGVD 1929  
 HORIZONTAL: N/A

PROFILE  
 DATE: \_\_\_\_\_  
 DRAWN BY: \_\_\_\_\_  
 CHECKED BY: \_\_\_\_\_  
 DATE: \_\_\_\_\_

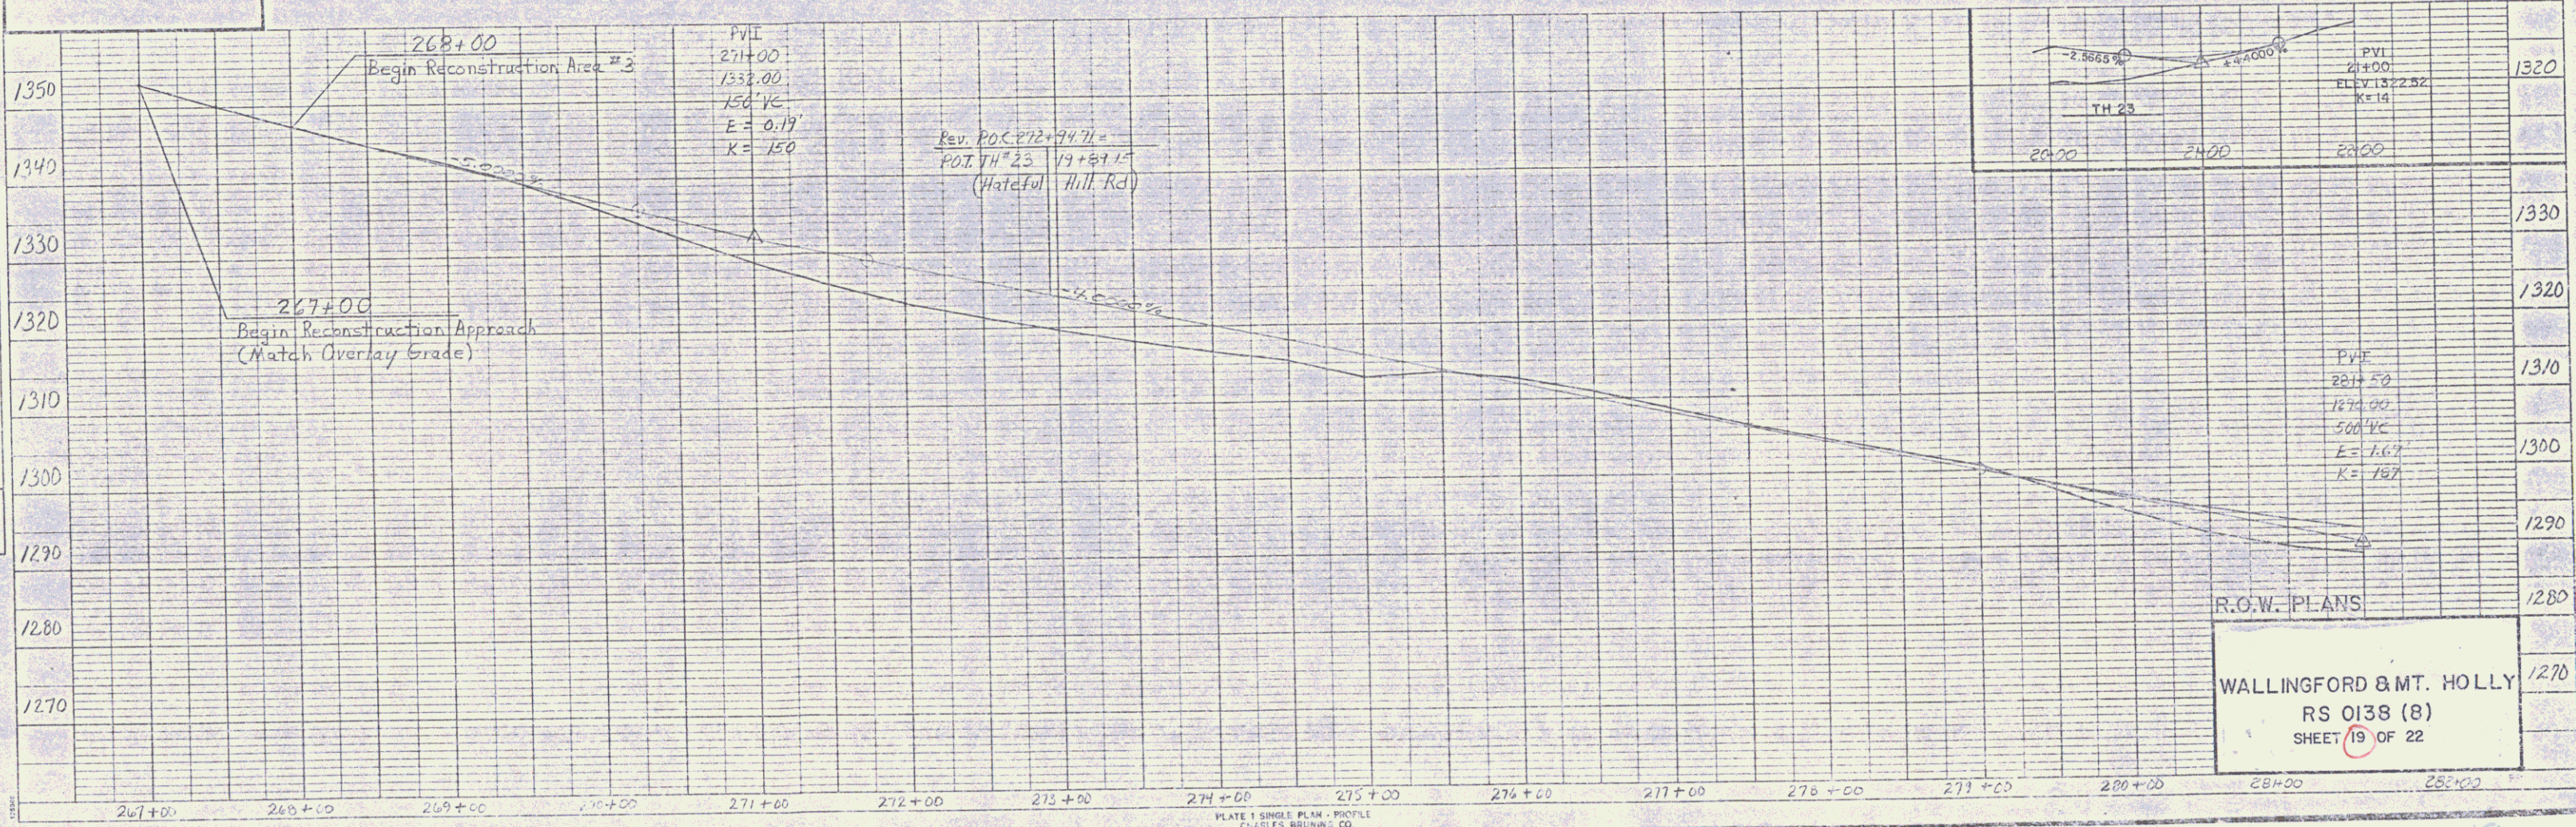

WALLINGFORD & MT. HOLLY  
 RS 0138 (B)  
 SHEET 19 OF 22

MAR 19 1993