


Curve No. 1
 Δ 18° 25' 00" Lt
D 4° 00' 00"
R 1432.40'
T 232.21'
L 460.42'
E 18.70'
Bnk 0.063 FT/FT.

TOWN OF BARTON LESSOR
LYON, MELVIN E. & SHIRLEY E. LESSEE

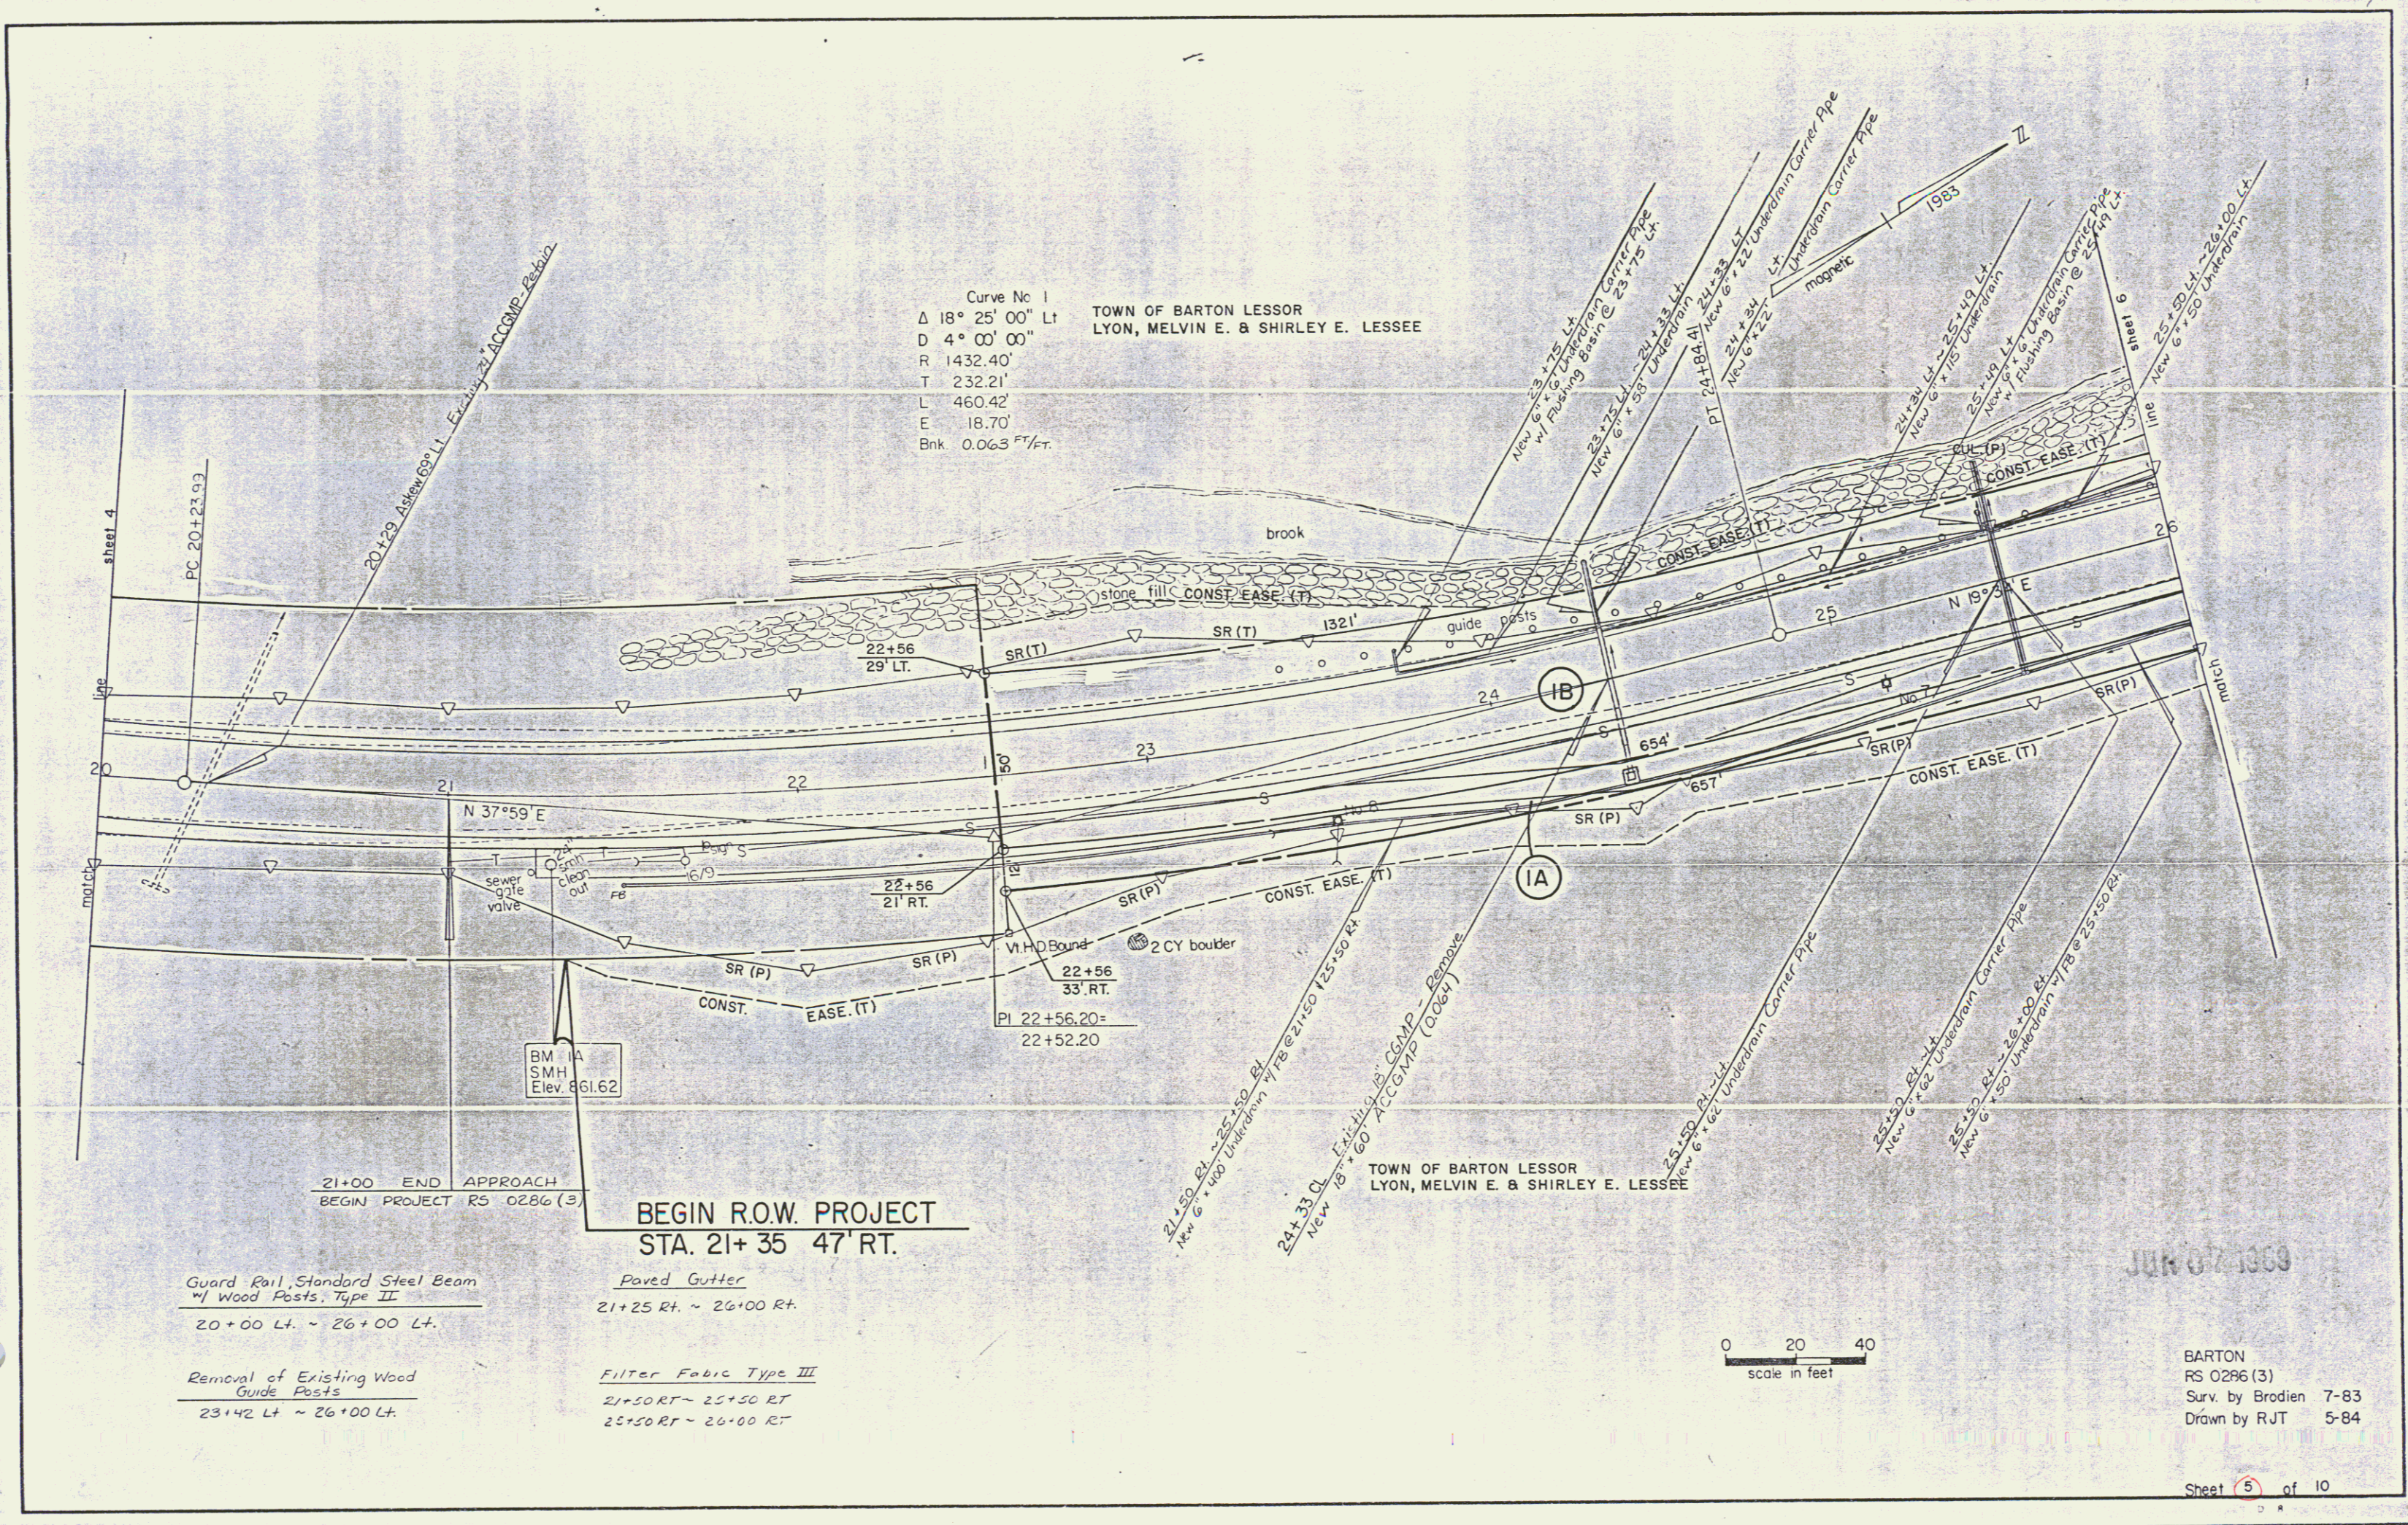


Guard Rail, Standard Steel Beam
w/ Wood Posts, Type II
20+00 Lt. ~ 26+00 Lt.

Removal of Existing Wood
Guide Posts
23+42 Lt ~ 26+00 Lt.

**BEGIN R.O.W. PROJECT
STA. 21+ 35 47' RT.**

Paved Gutter
21+25 Rt. ~ 26+00 Rt.

Filter Fabric Type III
21+50 RT ~ 25+50 RT
25+50 RT ~ 26+00 RT

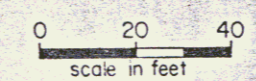

JUN 07 1983

BARTON
RS 0286 (3)
Surv. by Brodien 7-83
Drawn by RJT 5-84