


JUN 07 1989

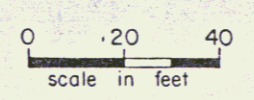

BARTON  
 RS 0286(3)  
 Surv. by Brodien 7-83  
 Drawn by RJT 5-84