

# TYPICAL SECTIONS

COLD PLANING - BITUMINOUS PAVEMENT  
EMULSIFIED ASPHALT, ITEM 404.65

ITEM 210.10 (AS SHOWN ON THE PLANS OR AS DIRECTED BY THE ENGINEER)


1 1/4" BITUMINOUS CONCRETE PAVEMENT, ITEM 406.25 (± 1/4") TYPE III SURFACE COURSE OVER VARIABLE DEPTH SHIM AND LEVELING COURSES (TYPE II OR III)

SHOULDERS: 3" BITUMINOUS CONCRETE PAVEMENT, ITEM 406.25 (± 1/4") (1 1/4" TYPE III OVER 1 3/4" TYPE II)  
24" SUBBASE OF GRAVEL, ITEM 301.15 (± 1")  
0-24" SAND BORROW (IN CUT), ITEM 203.31 (± 1")  
0-12" GRANULAR BORROW (IN FILL), ITEM 203.32 (± 1")


To be placed as noted on the plans or as directed by the Engineer in the field

Permissible tolerances in parenthesis applies to thickness only.


Q. No.	Lbs./A.	Name	Per. I	Spec. I
3.33	2	Croon Vetch	97	75
10.00	30	Creeping Red Fescue	98	85
8.33	5	Timothy	99	85
16.67	10	Perennial Ryegrass (Var. Pennine)	95	85
8.34	5	Alfalfa (Var. Saranac)	99	85
8.33	5	Birdsfoot Trefoil (Var. Empire)	98	85
5.00	3	Highland Banc Grass	92	85
100.00	60			

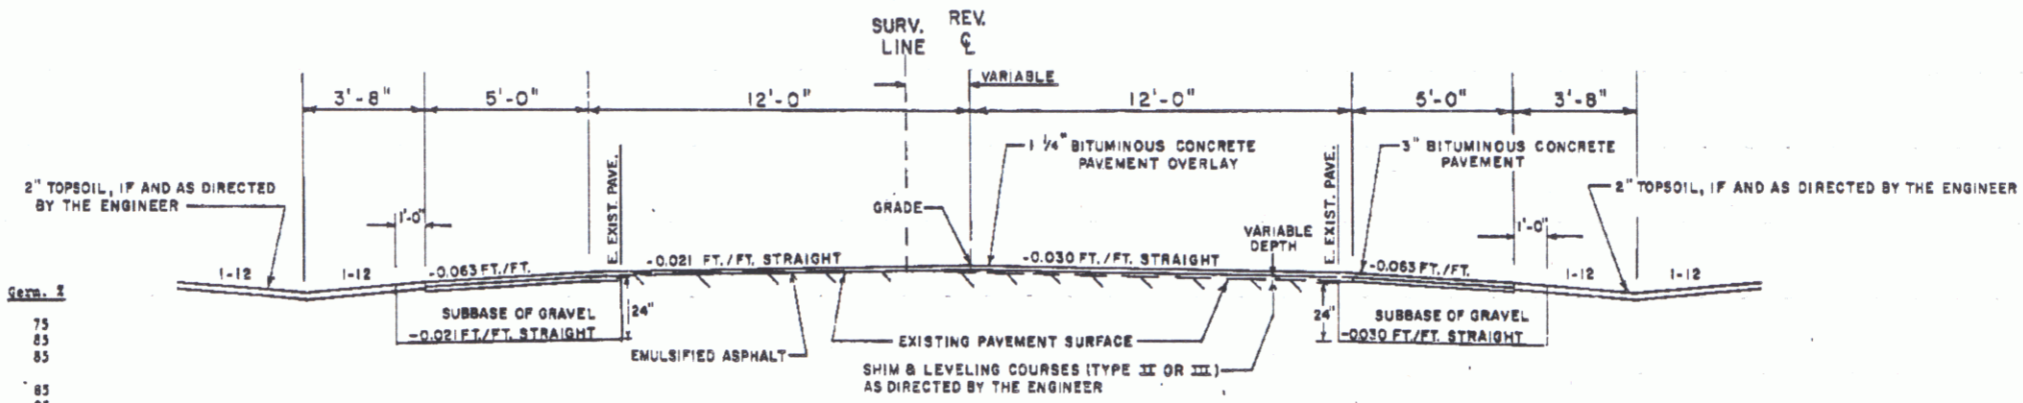

NORMAL SECTION

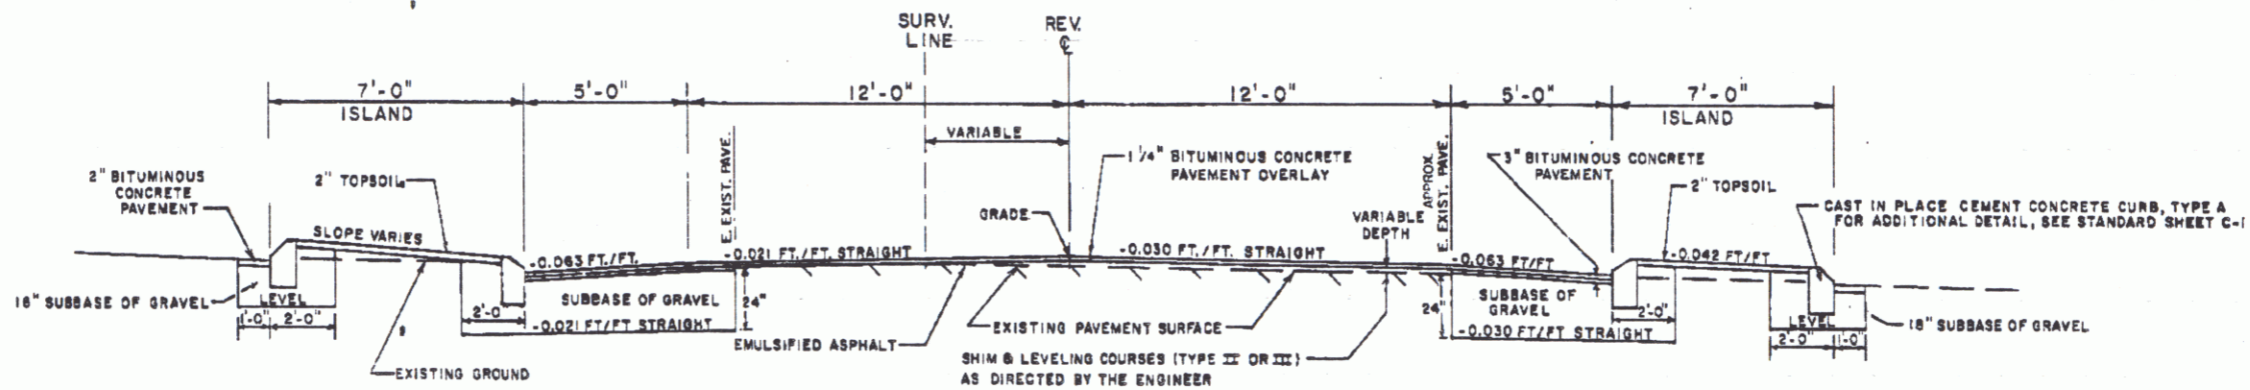


NORMAL SECTION WITH CURBED ISLANDS

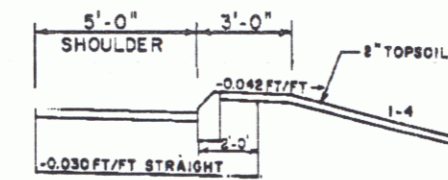

SHOULDER WITH CURB - NO ISLAND

- General Notes**
- SEED - To be applied per Seeding Formula as directed by the Engineer.
  - FERTILIZER - Formula 10-20-0 to be used with Seed, applied at the rate of 500 Lbs./Acre.
  - AGRICULTURAL LIMESTONE - To be applied at the rate of 2 Tons/Acre or as directed by the Engineer.
  - HAY MULCH - To be placed on earth slopes at the rate of 2 Tons/Acre.
  - TOPSOIL - To be used with Seed as indicated on the plans or as directed by the Engineer.
  - MARKER POSTS (Wood or Steel, as specified) - To be placed as directed by the Engineer.
  - SLOPE ROUNDING - All cut slopes to be rounded in accordance with Standard Sheet B-5.
  - PAY LIMITS OF SAND BORROW WHEN USED IN CONJUNCTION WITH UNDERDRAIN - See Standard Sheet D-2.

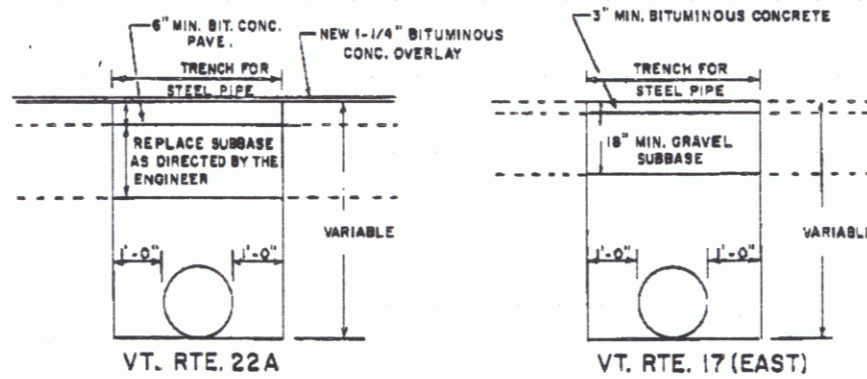

TRENCH REPAIR FOR ROADWAY PIPE CROSSINGS

SURVEYED BY: FANTONI DATE: \_\_\_\_\_  
DRAWN BY: HARDIE DATE: 12-84  
TRACED BY: HARDIE DATE: 12-84  
ADDISON  
PROJ. HES NO 017-1(4)S  
SHEET 2 of 7

AUG 9 1994