


BEGIN R. O. W. PROJECT
BRF 022-1(13) STA. 1+23 CL

DATUM
VERTICAL _____
HORIZONTAL _____

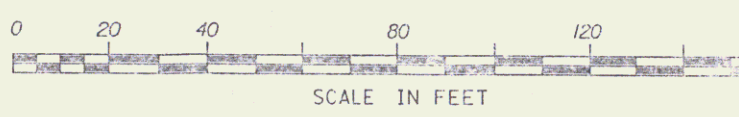

07-01-92	REVISION 1
03-8229 1805 RIH	
SURVEYED BY	NYE DATE 2-86
DRAWN BY	SQUAD A DATE 6-86
SQUAD LEADER	BOHL
DESIGN	FILE NO. /usr/z101/070070.dir/83e132z.dgn
PAPR	FILE 83e131r.i DATE PLOTTED 13-AUG-1992
STOCKBRIDGE	
BRF 022-1(13)	
R. O. W. SHEET 10 OF 12 SHEETS	

MAR 19 1993

10