



NOTE:
 OLD STONE FROM DR. STARK'S
 WALLS TO BE STOCKPILED BY THE
 TRACTOR AT AN ACCEPTABLE LOCATION.

Drilling & Blasting
 Solid Rock Subgrade
 98125 ~ 99175
 103125 ~ 104175

CONSTRUCT DRIVE
 LT
 101+80 (16' wide)
 Rev 103+50 (12' wide)
 Rev 104+40 (14' wide)
 Rev 106+12 (14' wide)
 Rev 107+90 (14' wide)
 Rev 108+67 (14' wide)
 Rev 113+35 (14' wide)

CONSTRUCT SPECIAL DITCH
 W/STONE FILL, TYPE I
 (EXCAVATION UNDER ITEM 203.15)
 LT
 98100-98125
 98100-98125
 Rev 108+11 ~ 108+50
 Rev 108+82 ~ 110+00
 Rev 112+83 ~ 113+15

CONSTRUCT SPECIAL DITCH
 W/STONE FILL, TYPE II
 (EXCAVATION UNDER ITEM 203.25)
 LT
 Rev 110+00 ~ 112+83

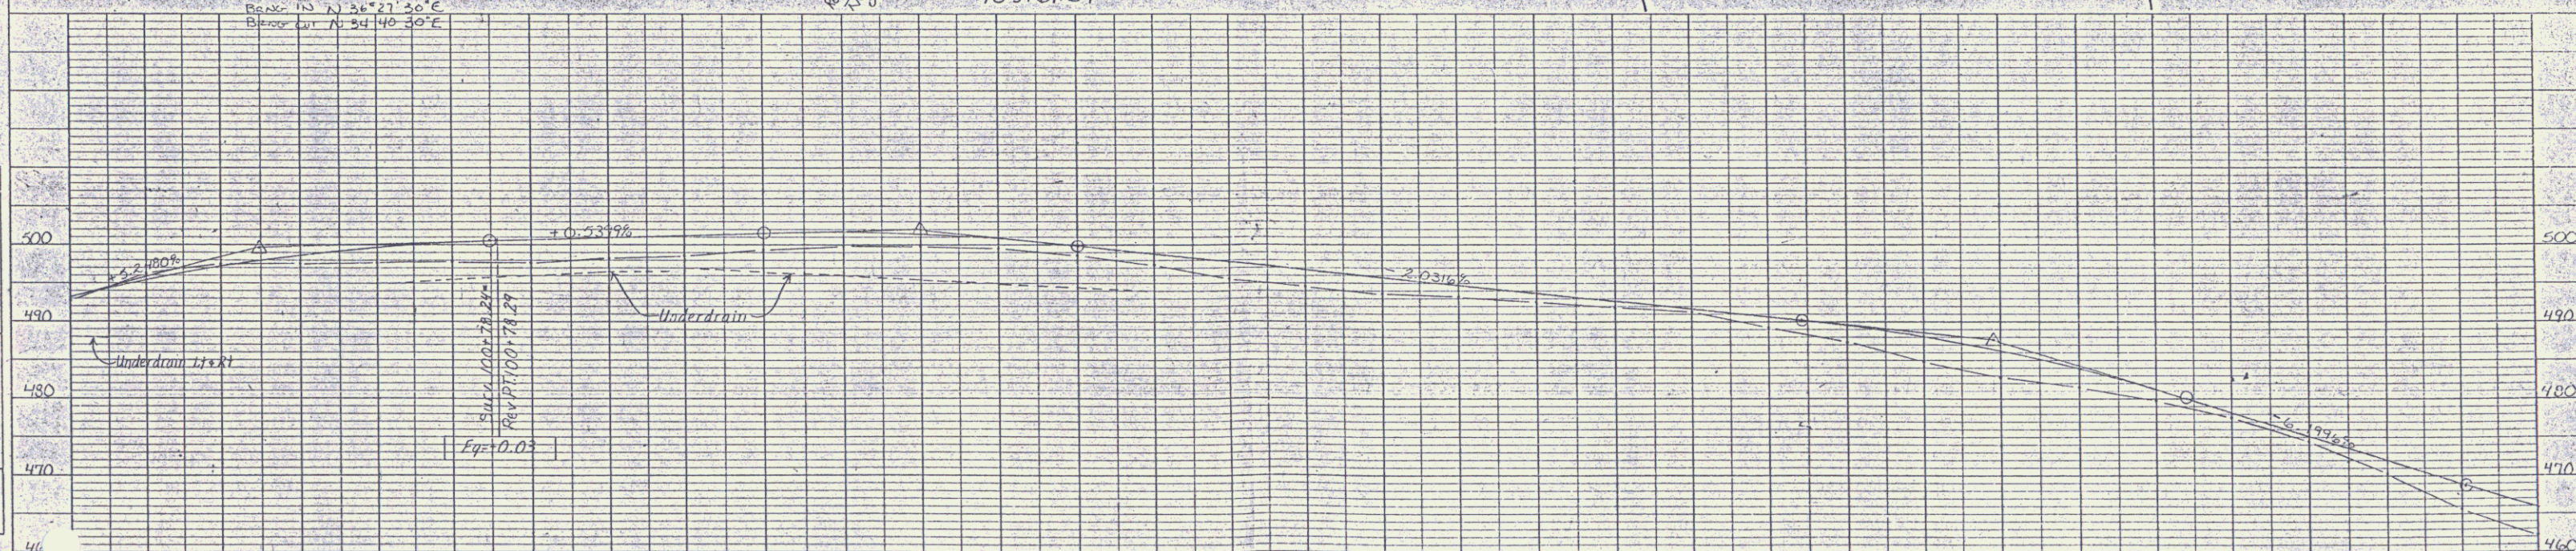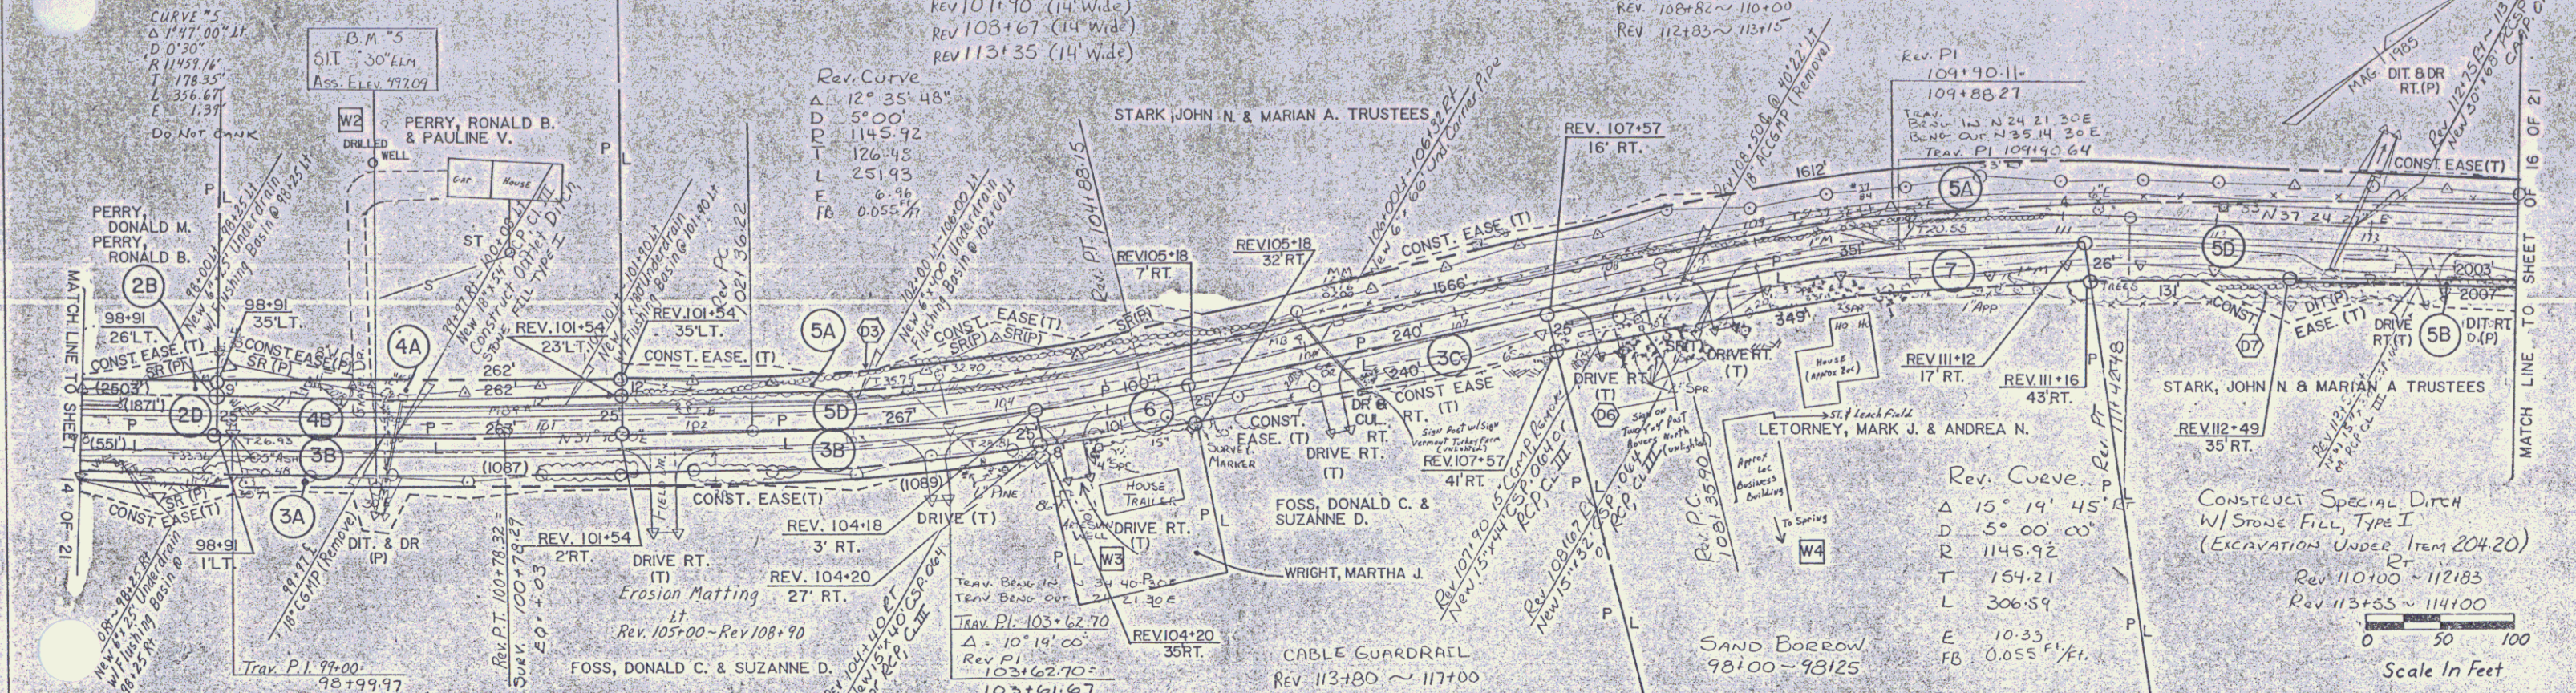

R.O.W. PLANS
 WESTFORD
 RS 0229(5)
 SHEET 15 OF 21
 14