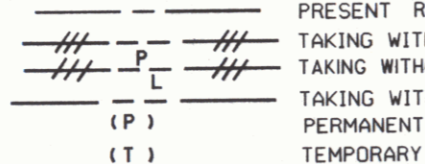


**STATE OF VERMONT
AGENCY OF TRANSPORTATION
RIGHT OF WAY PLANS
DETAIL SHEET**

TABLE OF PROJECT PROPERTY ACQUISITION

PARCEL NO.	GRANTOR	SHEET NO.	BEGINNING STATION	ENDING STATION	TAKING	REM.	RIGHTS	TITLE TAKEN	DATE	TOWN OR CITY RECORDED	BK.	PG.	REMARKS	REVISION NO.	SHEET	DESCRIPTION OF REVISION	DATE	MADE BY	APPROVED BY
9A	DECKER, C. DWIGHT & LINDA A.	12	REV. 488+95 LT. REV. 488+95 LT. REV. 490+00 LT.	REV. 490+70 LT. REV. 490+50 LT. REV. 490+70 LT.	0.10A±	0.52A±	INSTALL (T) SLOPE (P) 0.01A±	WD		NEWFANE			MODIFIED FENCE 680 S.F.±	25	10.12	PARCEL NO. 9 DECKER. SEPERATE INTO TWO PARCELS. CREATE PARCEL 19. PER C.O. 8301.	12-14-92	M. J. R.	L. W. B.
9B		12	REV. 488+95 LT.	REV. 490+71 LT.	0.10A±		ALL R.T. & I. 0.10A±						VT. RTE. 30	26	12	PARCEL NO. 13 GARDNER. REVISE SIDE SLOPE ON DRIVE AT 24+00 RT TO 1-2. CREATE SWALE DITCH. PER C.O. 8317.	02-05-93	M. J. R.	L. W. B.
10A	ROCCISANO, MARY G.	12	REV. 491+20 LT. TH. 75 60+60 RT. TH. 75 60+50 RT. REV. 491+20 LT. REV. 491+88 LT.	REV. 492+22 LT. REV. 491+25 LT. REV. 492+22 LT.	0.04A±	0.31A±	INSTALL (T) DRIVE (T) CULVERT (P) SLOPE (P) 0.01A±	WD		NEWFANE			1700 S.F.± DRIVE CURB 16' GRAVEL 175 S.F.	28	6.11	PARCEL NO. 4 SHUTAN. ADD NEW PARCEL 4G. PER C.O. 8322.	02-08-93	M. J. R.	L. W. B.
10B		12	REV. 491+20 LT.	REV. 492+22 CL.	0.06A±		ALL R.T. & I.						VT. RTE. 30 2500 S.F.±	30	8	PARCEL NO. 11 WAY. COMBINE DITCH (P) WITH CULVERT & DRAINAGE RIGHT. PER C.O. 8325.	02-16-93	M. J. R.	L. W. B.
11A	WAY, WILLIAM L. & ELIZABETH C.	12	REV. 491+30 RT. REV. 491+30 RT. REV. 491+23 RT. REV. 491+28 RT. REV. 492+06 RT. REV. 492+20 RT. REV. 492+36 RT. REV. 492+38 RT. REV. 492+40 RT. REV. 491+63 RT. REV. 494+43 RT.	REV. 494+72 RT. REV. 494+69 RT. REV. 491+59 RT. REV. 491+43 RT. REV. 494+43 RT. REV. 492+12 RT. REV. 494+69 RT.	0.05A±	1.26A±	CONST. (T) SLOPE (P) 0.01A± INSTALL & MAINTAIN (P) DRIVE (T) SLOPE (P) 0.03A± INSTALL & MAINTAIN (P) SLOPE (P) 0.01A± CUL., DIT. & DR. (P) 0.01A±	WD		NEWFANE			2190 S.F.± 300 S.F.± 20 S.F.± GUARD RAIL 24' GRAVEL MP 0037 1350 S.F.± GUARD RAIL SIGN- PERSONAL 300 S.F.± 420 S.F.±	31	9.12	PARCEL NO. 13 GARDNER. CHANGE RUNNING DISTANCE ALONG CENTERLINE FROM 195' TO 199'. CHANGE RUNNING DISTANCE ALONG ROW FROM 199' TO 198'. CHANGE ENDING STA. OF TAKE ON DETAIL SHEET FROM 25+70 RT. TO 25+76 RT. CHANGE ENDING STA. OF REMAINDER ON DETAIL SHEET FROM 25+76 RT. TO 25+70 RT. PER C.O. 8328.	02-22-93	M. J. R.	L. W. B.
11B		12	REV. 491+32 RT.	REV. 494+72 RT.	0.19A±		ALL R.T. & I.						VT. RTE. 30	12	12	PARCEL NO. 14 KAHL. CHANGE RUNNING DISTANCE ALONG TAKE LINE & ROW LINE FROM 304' TO 309'. PER C.O. 8328.	02-22-93	M. J. R.	L. W. B.
														32	7.12	PARCEL NO. 7 WESTCOTT. REMOVE *ALL R. T. & I.* FROM SATELLITE DISH AND REPLACE WITH *REMOVE & RESET (T)*. PER C.O. 8356.	04-12-93	C. C. P.	L. W. B.
														33	6.11	PARCEL NO. 4 SHUTAN. CHANGE TAKING ON 4C FROM 0.68A± TO 0.71A±. ON 4G, CHANGE BEGINNING STA. OF TAKING FROM REV. 480+07 LT. TO REV. 480+65 LT. CHANGE TAKING AREA ON 4G FROM 0.13A± TO 0.10A±. PER C.O. 8371.	05-10-93	C. C. P.	L. W. B.
														34	10.11	PARCEL NO. 16 TOWN OF NEWFANE. DELETE PARCEL 16C. PER C.O. 8372.	05-10-93	C. C. P.	L. W. B.
														35	7.12	PARCEL NO. 8 MACPHAIL. CHANGE PLANS TO MAKE THIS PARCEL A TOTAL TAKE. PER C.O. 8390.	06-08-93	M. J. R.	L. W. B.
														36	5.12	PARCEL NO. 5 DAVIDSON. MOVE NORTHERLY PROPERTY LINE SOUTH. REDUCE TAKE, SLOPE, CONST. (T) & ALL R. T. & I. ACCORDINGLY. PER C.O. 8411.	07-12-93	C. C. P.	L. W. B.

03-31 83-848022	DR. (P)- DRAINAGE RIGHT DIT. (P)- DITCHING RIGHT CH. (P)- CHANNEL RT. DRIVE (T)- DRIVE RIGHT CUL. (P)- CULVERT RIGHT [W]- WATER SOURCES	 <p>PRESENT R.O.W. TAKING WITHOUT ACCESS TAKING WITHOUT ACCESS ALONG PROPERTY LINE TAKING WITH ACCESS PERMANENT EASEMENT TEMPORARY EASEMENT</p>	<p>LEGEND . . . CZ (P) CLEAR ZONE CONST. (T) CONSTRUCTION EASEMENT SR SLOPE RIGHTS P PROPERTY LINE L TOP OF CUT O TOE OF SLOPE</p>	<p>APPROVED: LAWRENCE BLISS, L.S. DATE: 8-1-89 AGENT D. PLANS & TITLES</p>	<p>REVISED 07-12-93 R. O. W. PLANS NEWFANE F 015-1(16) SHEET 8 OF 12</p>
-----------------	--	---	--	--	--