

CONSTRUCT DRIVE  
 102+17 LT - 30' PAVED  
 103+21 RT - 40' PAVED  
 104+00 LT - 35' GRAVEL


SPECIAL DITCH W/STONE FILL, TYPE I  
 102+50 RT - 102+75 RT

EROSION MATTING  
 101+50 RT - 102+50 RT

BEGIN CURBED ISLAND  
 100+36 LT -  
 101+24 LT -


END CURBED ISLAND (GRANITE SLOPE EDGING)  
 100+93 LT  
 102+01 LT.

SURVEY CURVE DATA  
 Δ = 8°00'00" LT  
 D = 8°00'00"  
 R = 716.20  
 L = 50.08  
 E = 100.00  
 F = 1.75  
 BANK 0.031 FT/FT

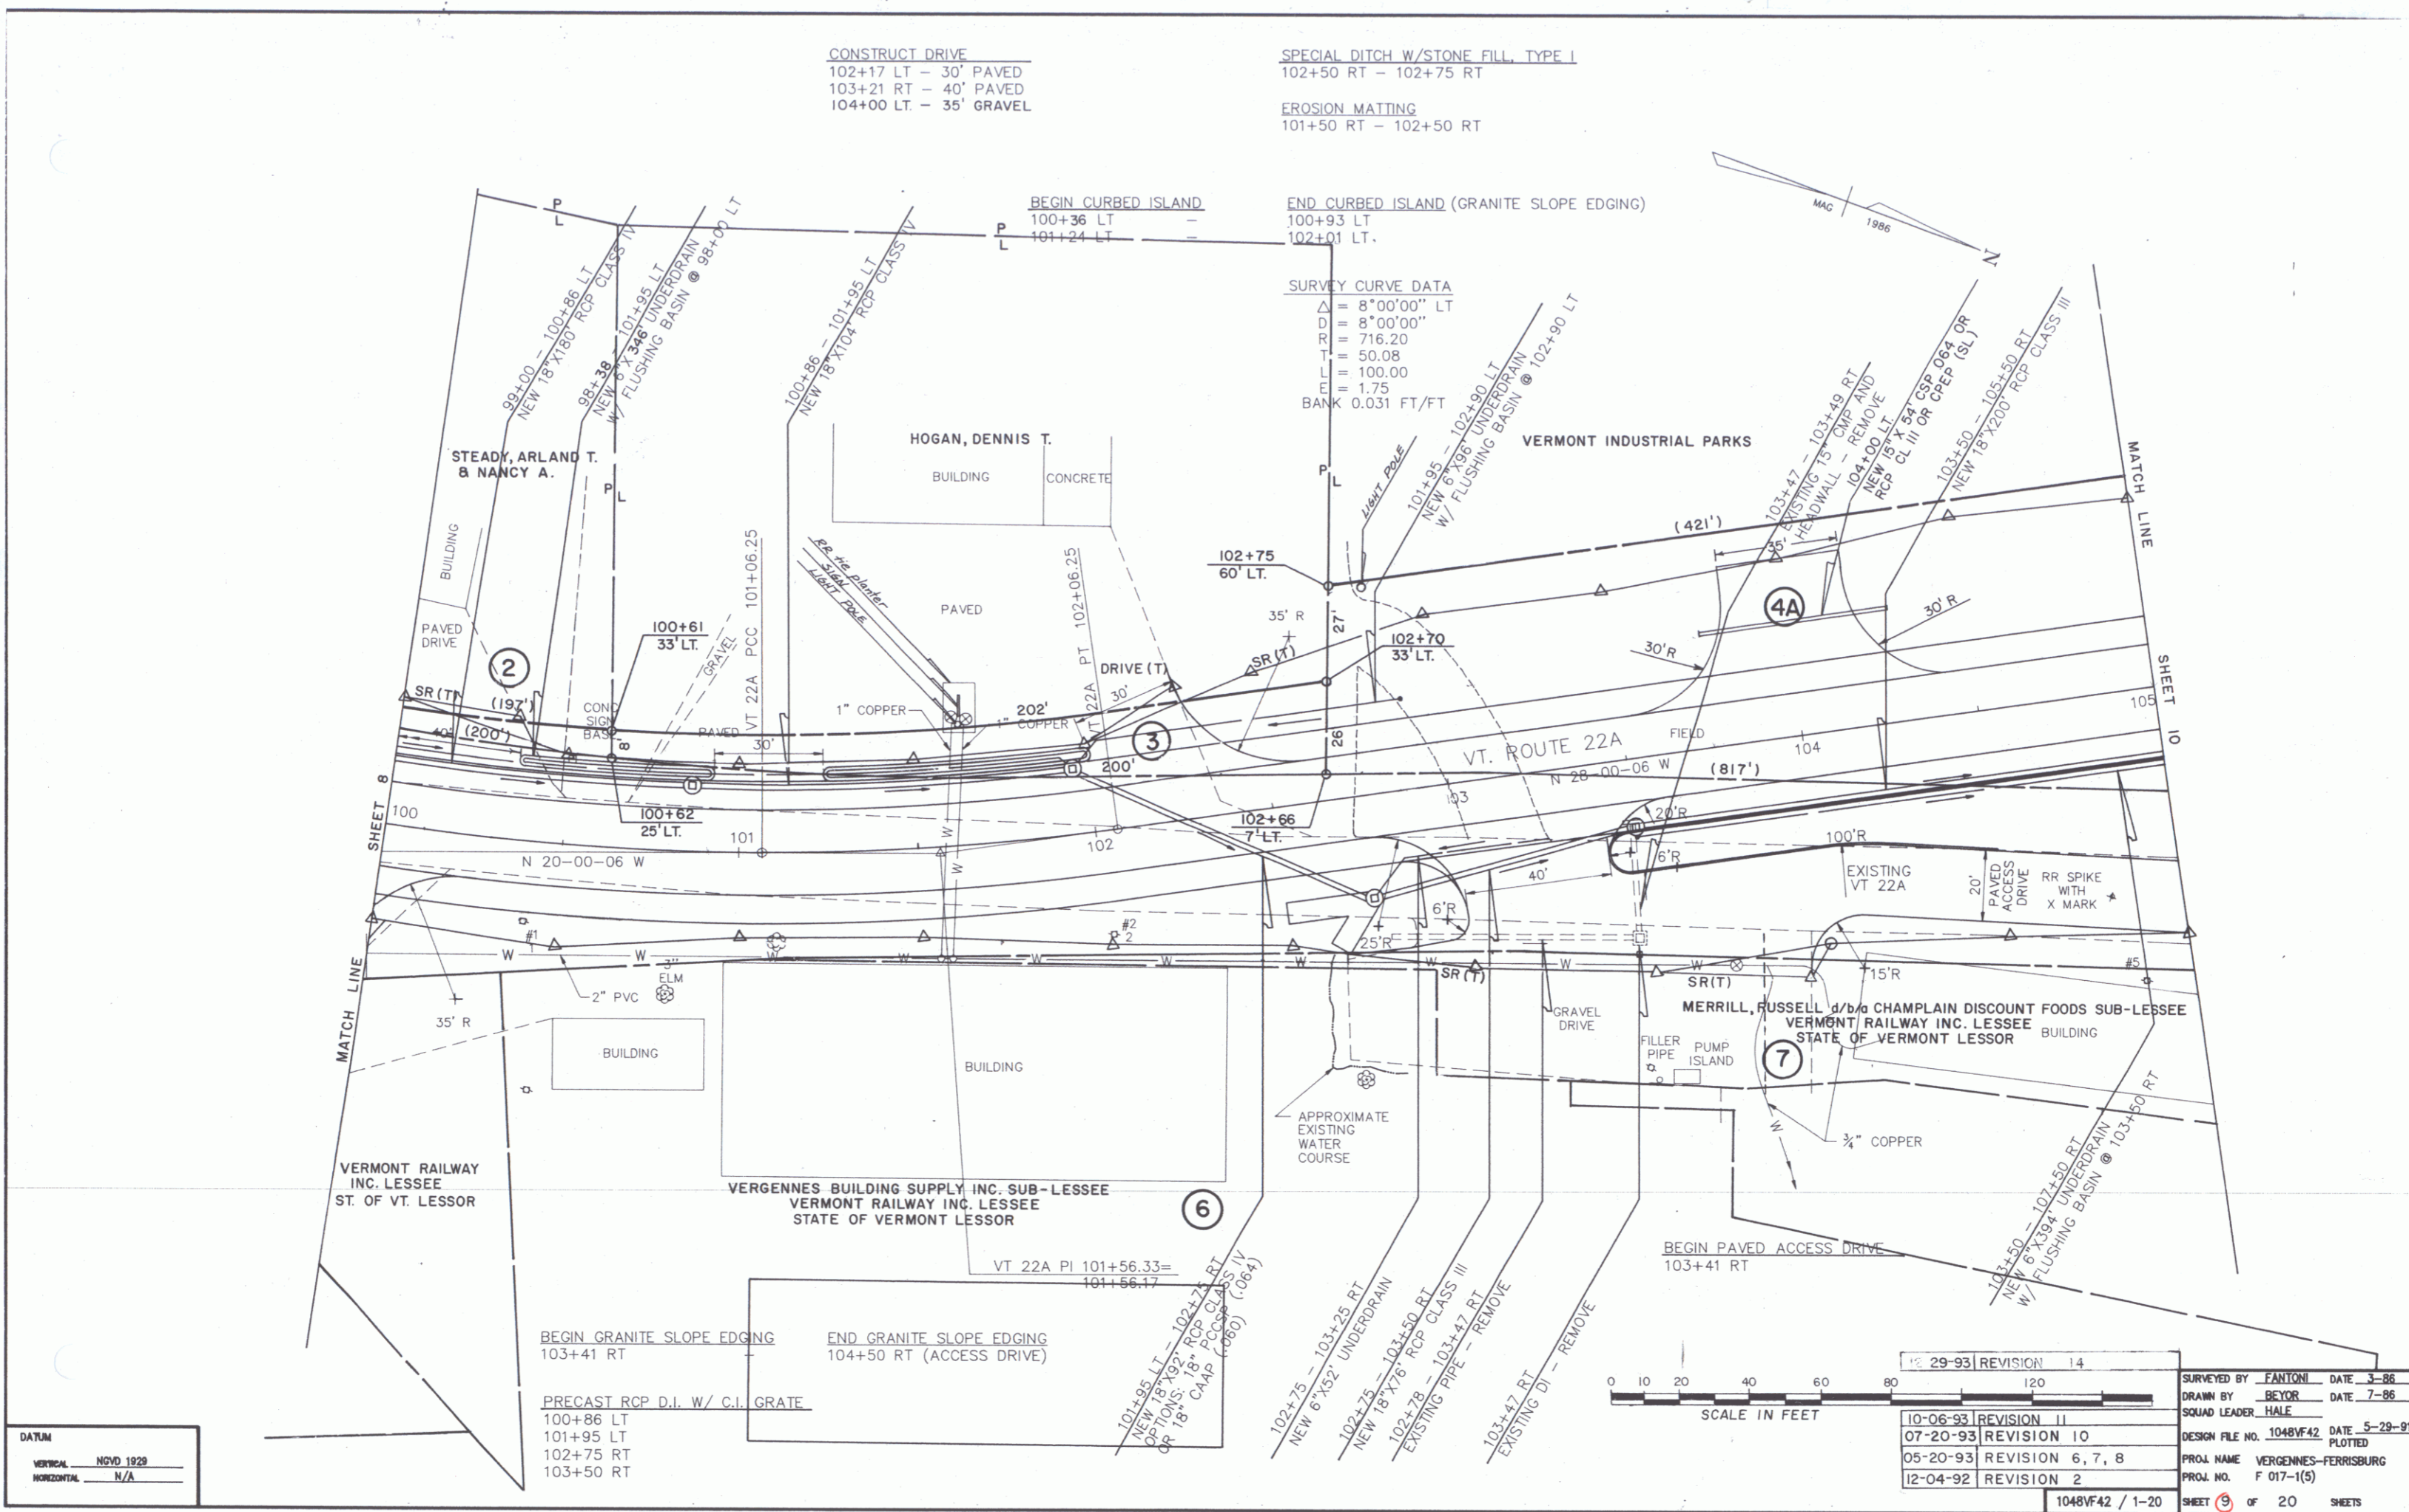

DATUM

VERTICAL	NOVD 1929
HORIZONTAL	N/A

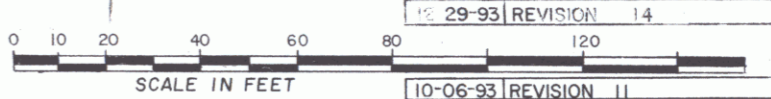

10-29-93	REVISION 14
10-06-93	REVISION 11
07-20-93	REVISION 10
05-20-93	REVISION 6, 7, 8
12-04-92	REVISION 2

SURVEYED BY	FANION	DATE	3-86
DRAWN BY	BEYOR	DATE	7-86
SQUAD LEADER	HALE		
DESIGN FILE NO.	1048VF42	DATE PLOTTED	5-29-91
PROJ. NAME	VERGENNES-FERRISBURG		
PROJ. NO.	F 017-(15)		
1048VF42 / 1-20		SHEET 9 of 20 SHEETS	