


DATUM
 VERTICAL NGVD 1929
 HORIZONTAL NAD 1927

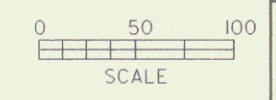

FEB 19 2003

EROSION CONTROL SHEET

PROJECT: LUNENBURG	PROJECT NO.: HES 028-4(19)S
DESIGN FILE NAME: /sqda/84e069/de069ero	PLOT DATE: 17-MAY-1999
IPARM FILE NAME: de069ecl	SURVEY DATE:
SURVEYED BY:	DRAWN BY: jfg
SQUAD LEADER: bombardier	
R. O. W. SHEET 4 OF 11 SHEETS	