


MAR 20 1996

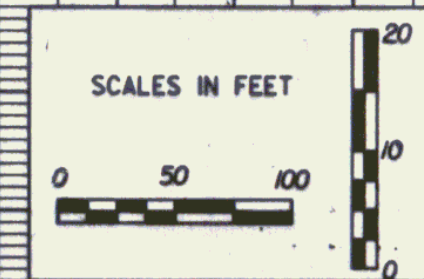

SURVEYED BY _____ DATE _____
 DRAWN BY GUY MELNER DATE 2-7-90
 DESIGN SUPERVISOR M. L. JUNGVALL
 DESIGN FILE NO. 100(50.67)B4E070.DCIN2
 PRF FILE 84E070P1 DATE PLOTTED 10-SEP-1990
BRATTLEBORO
HES 010-1(30)
 R.O.W. SHEET 4 OF 11 SHEETS