

PLAN  
 CHECKED  
 DATE  
 DESIGNED  
 DATE  
 DRAWN  
 DATE  
 SURVEYED  
 DATE

PROFILE  
 CHECKED  
 DATE  
 DESIGNED  
 DATE  
 DRAWN  
 DATE  
 SURVEYED  
 DATE

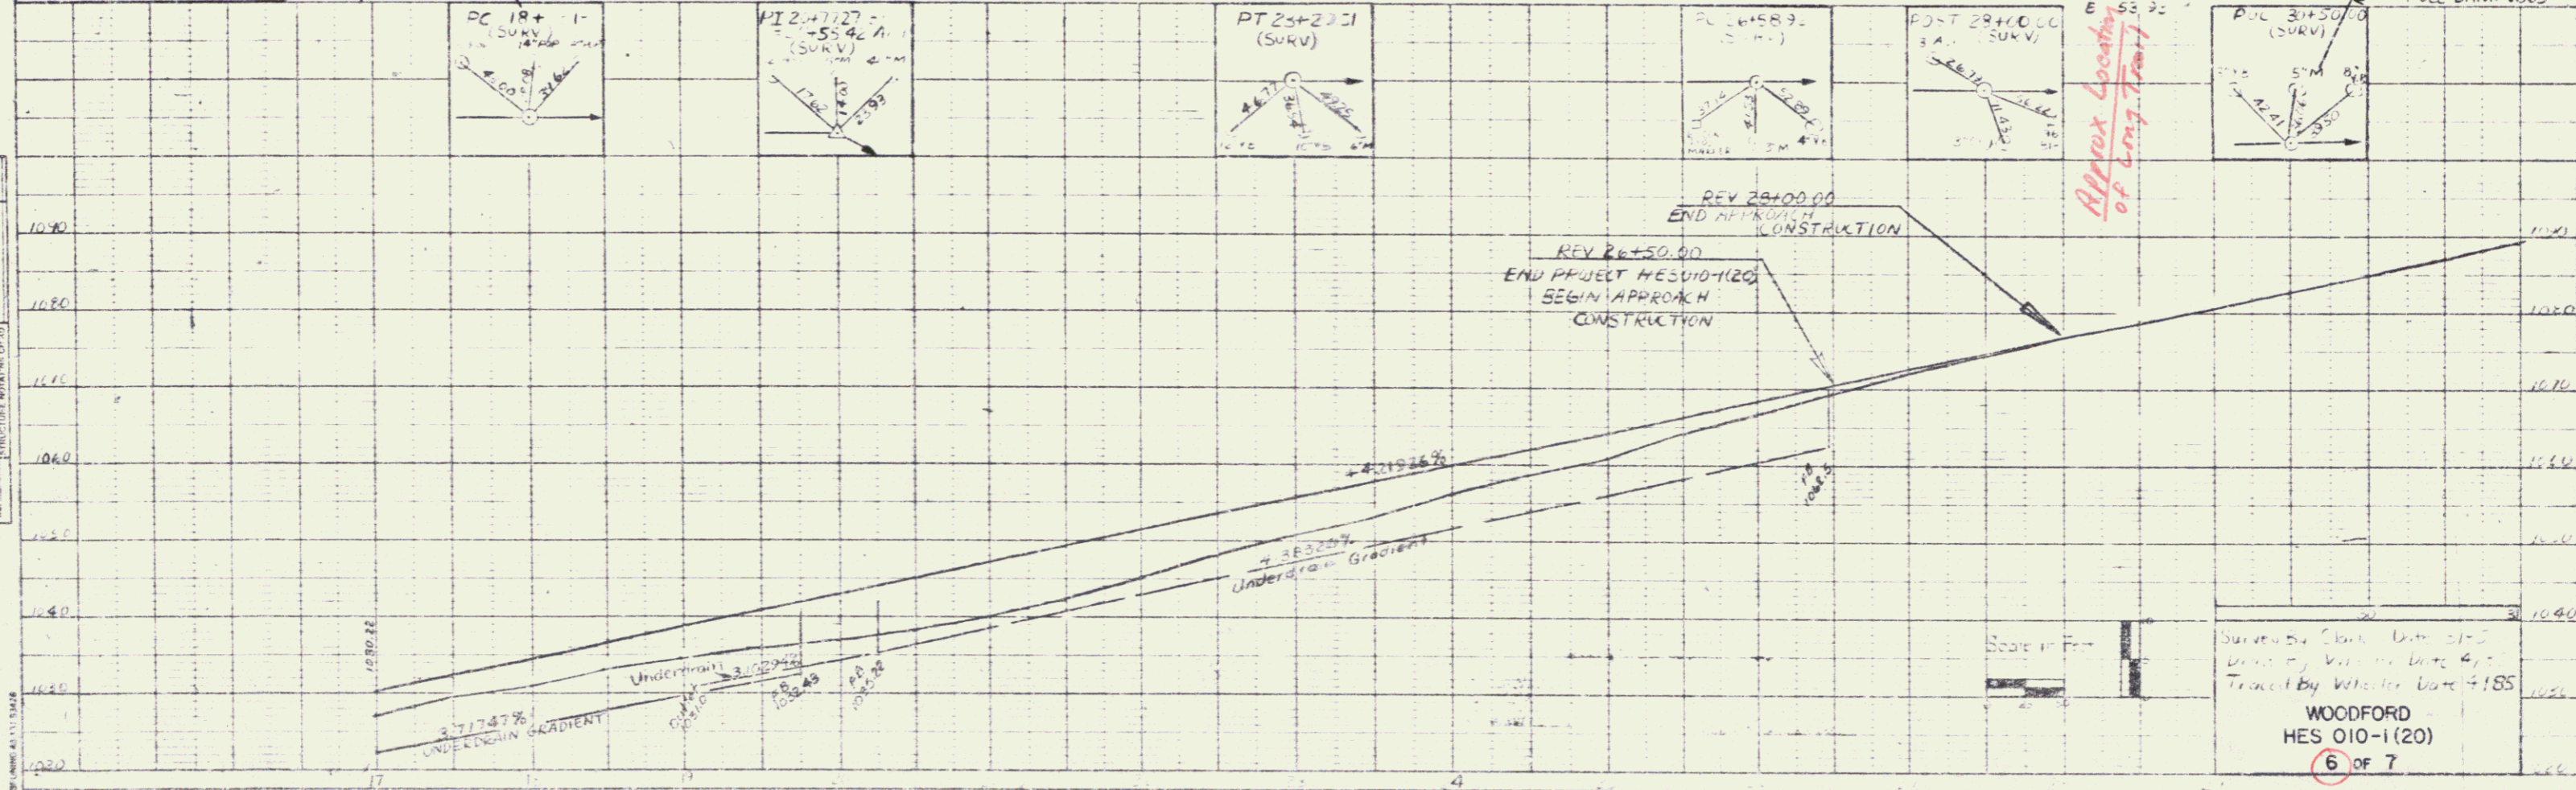
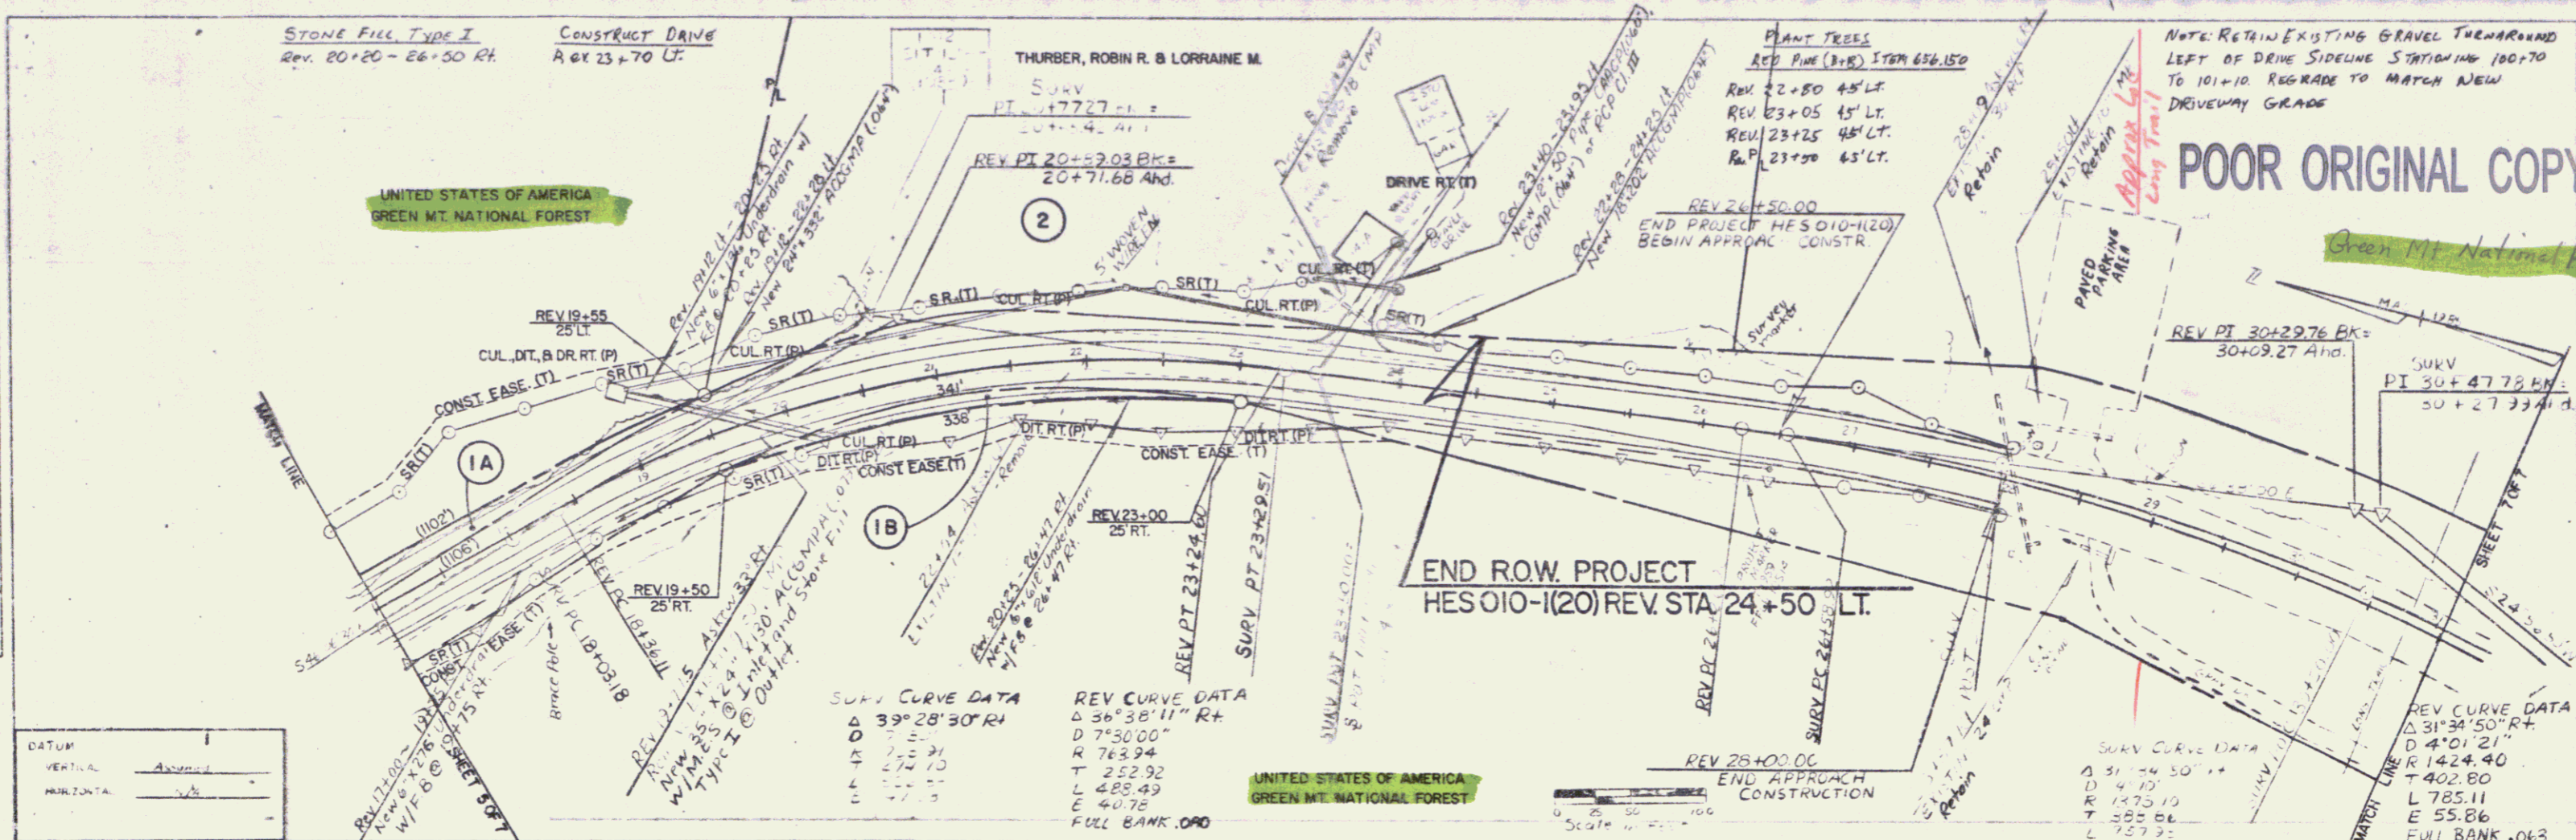


PLATE 1 SINGLE PLAN PROFILE  
 CHARLES SPRING CO.