



PROJECT NOT CONSTRUCTED
TEMP RIGHTS ONLY

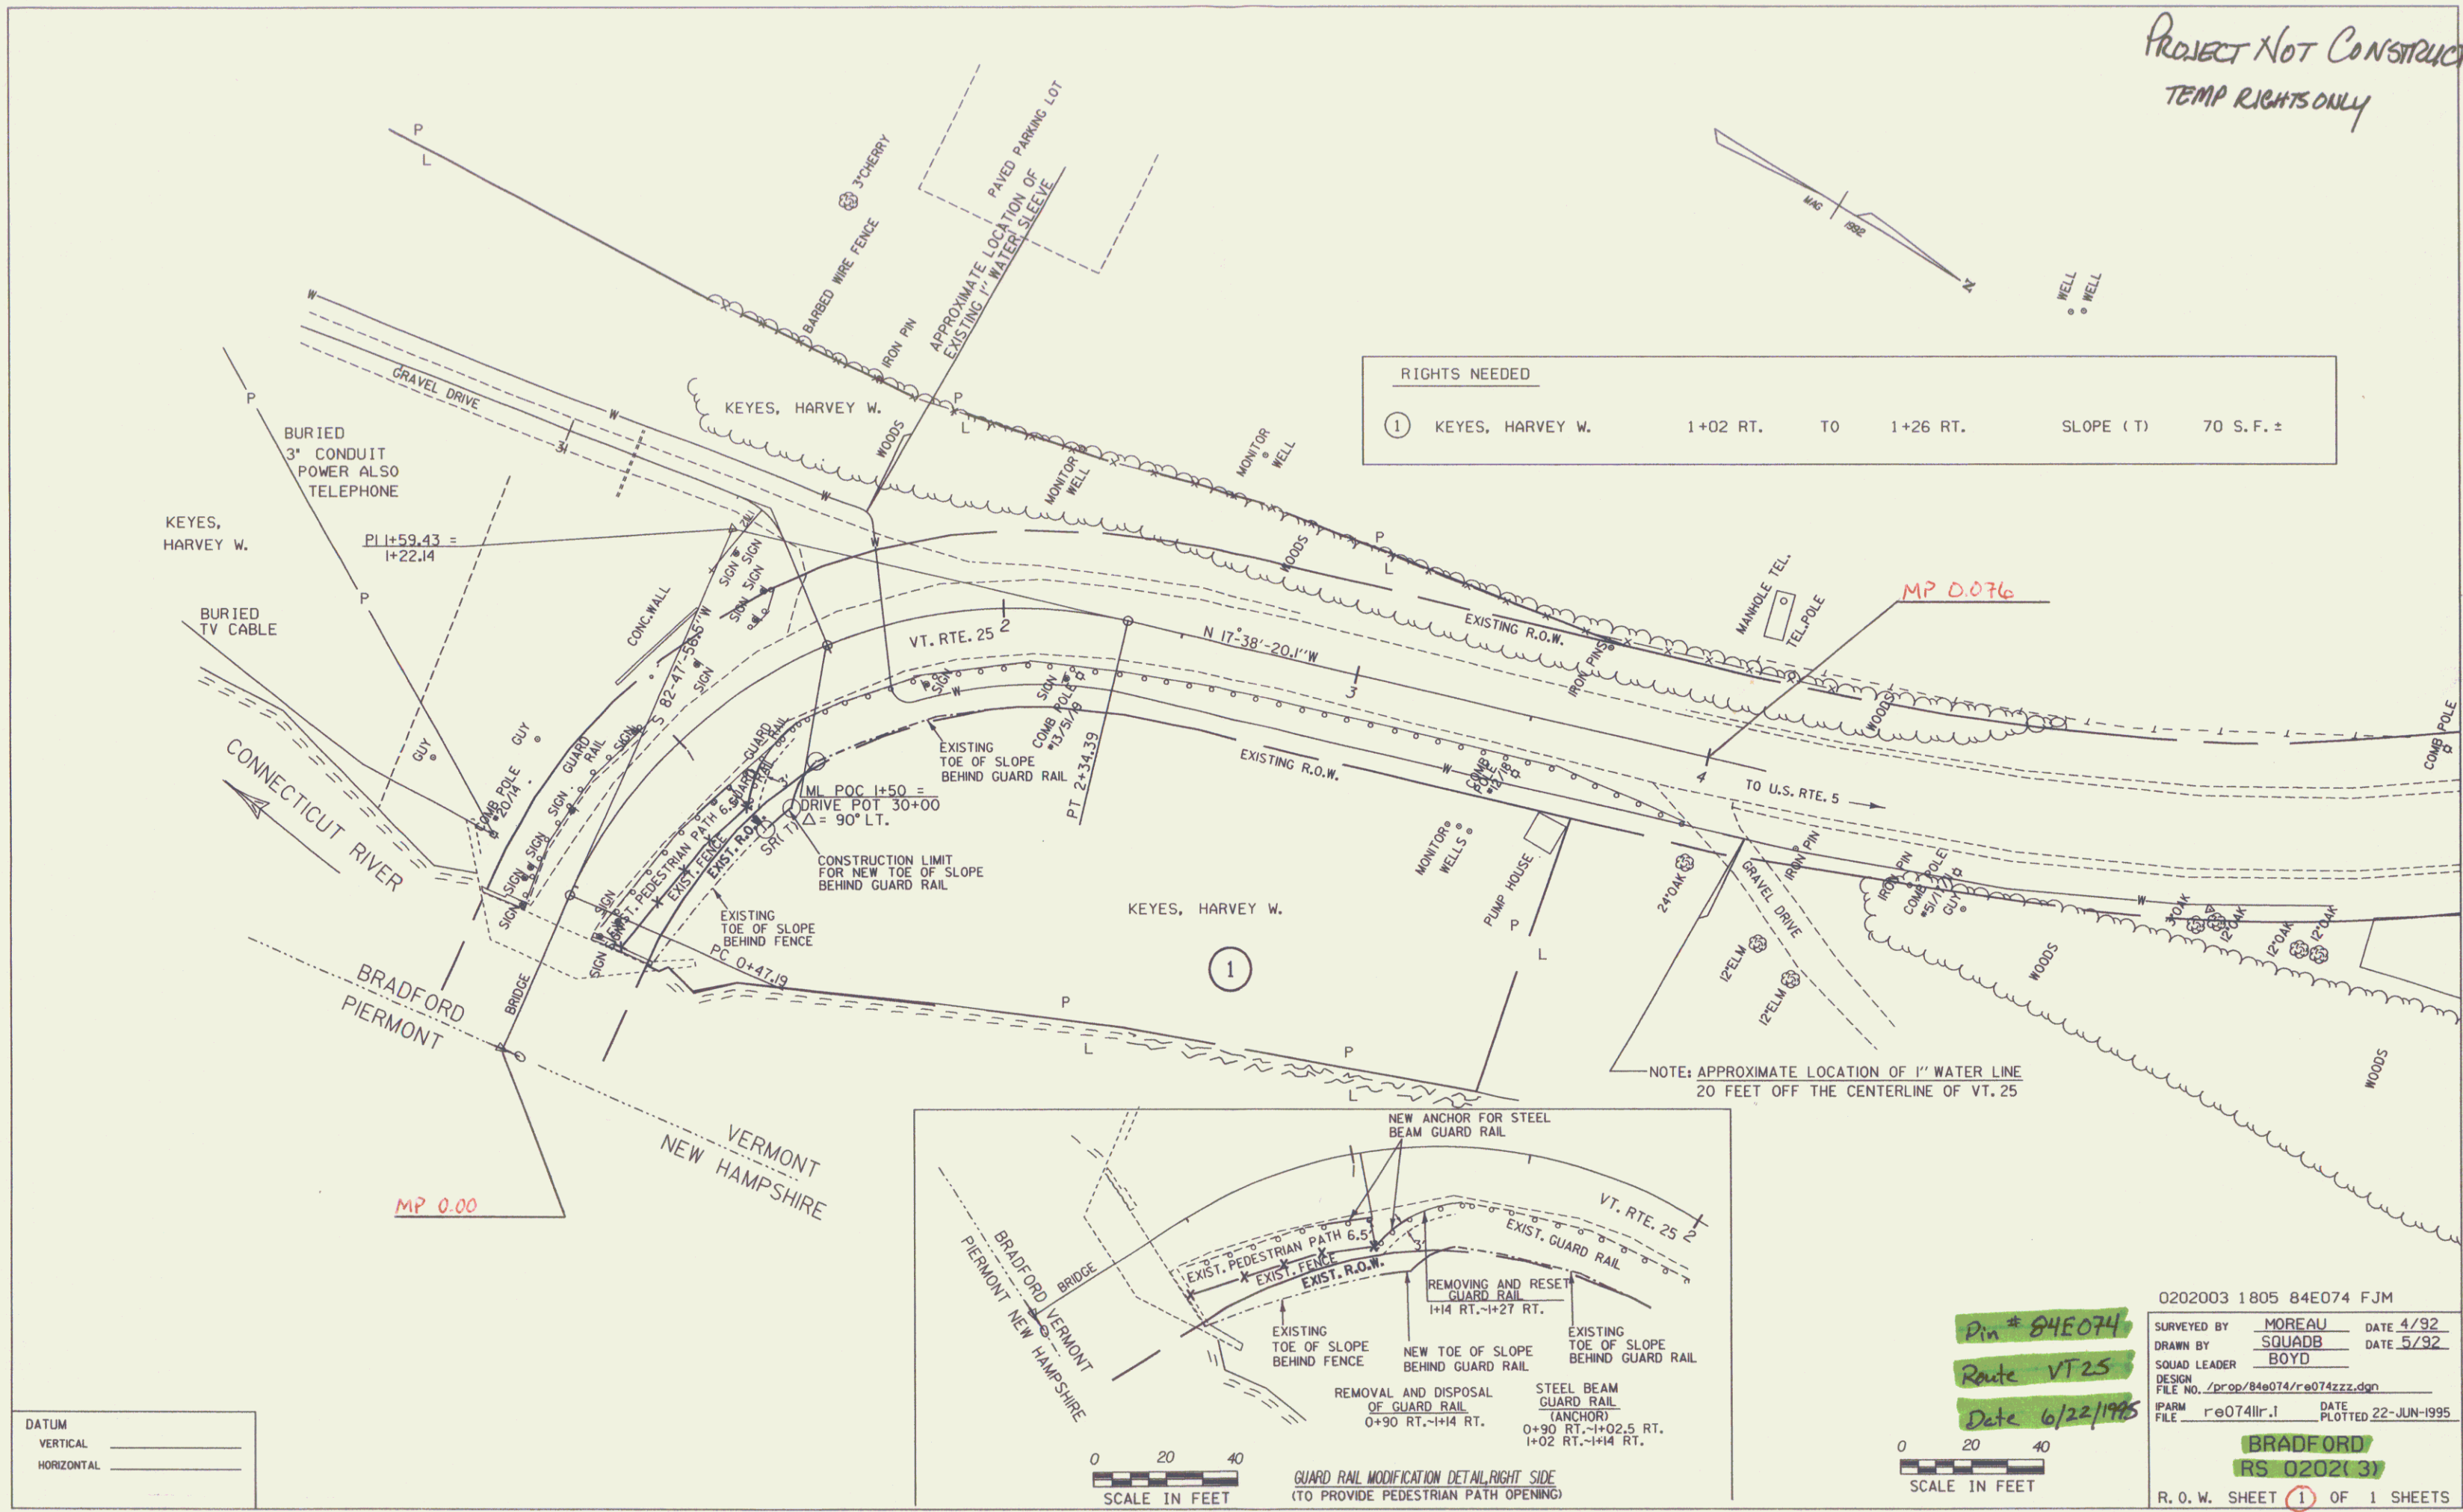

RIGHTS NEEDED			
①	KEYES, HARVEY W.	1+02 RT. TO 1+26 RT.	SLOPE (T) 70 S.F. ±

DATUM	_____
VERTICAL	_____
HORIZONTAL	_____

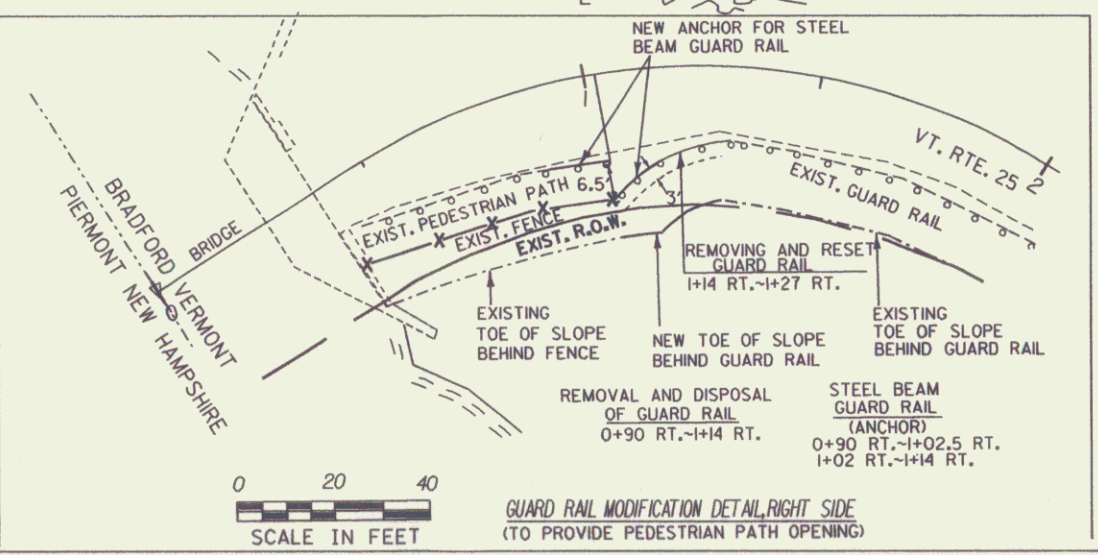

Pin # 84E074
Route VT25
Date 6/22/1995

0202003 1805 84E074 FJM
SURVEYED BY MOREAU DATE 4/92
DRAWN BY SQUADB DATE 5/92
SQUAD LEADER BOYD
DESIGN FILE NO. /prop/84e074/re074zzz.dgn
IPARM FILE re074lr.1 DATE PLOTTED 22-JUN-1995
BRADFORD RS 0202(3)
R. O. W. SHEET ① OF 1 SHEETS

0 20 40
SCALE IN FEET

0 20 40
SCALE IN FEET