
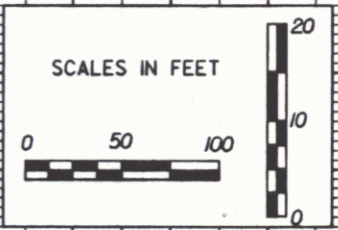


04E0750FP

DATUM
VERTICAL NGVD 1929
HORIZONTAL NAD 1927

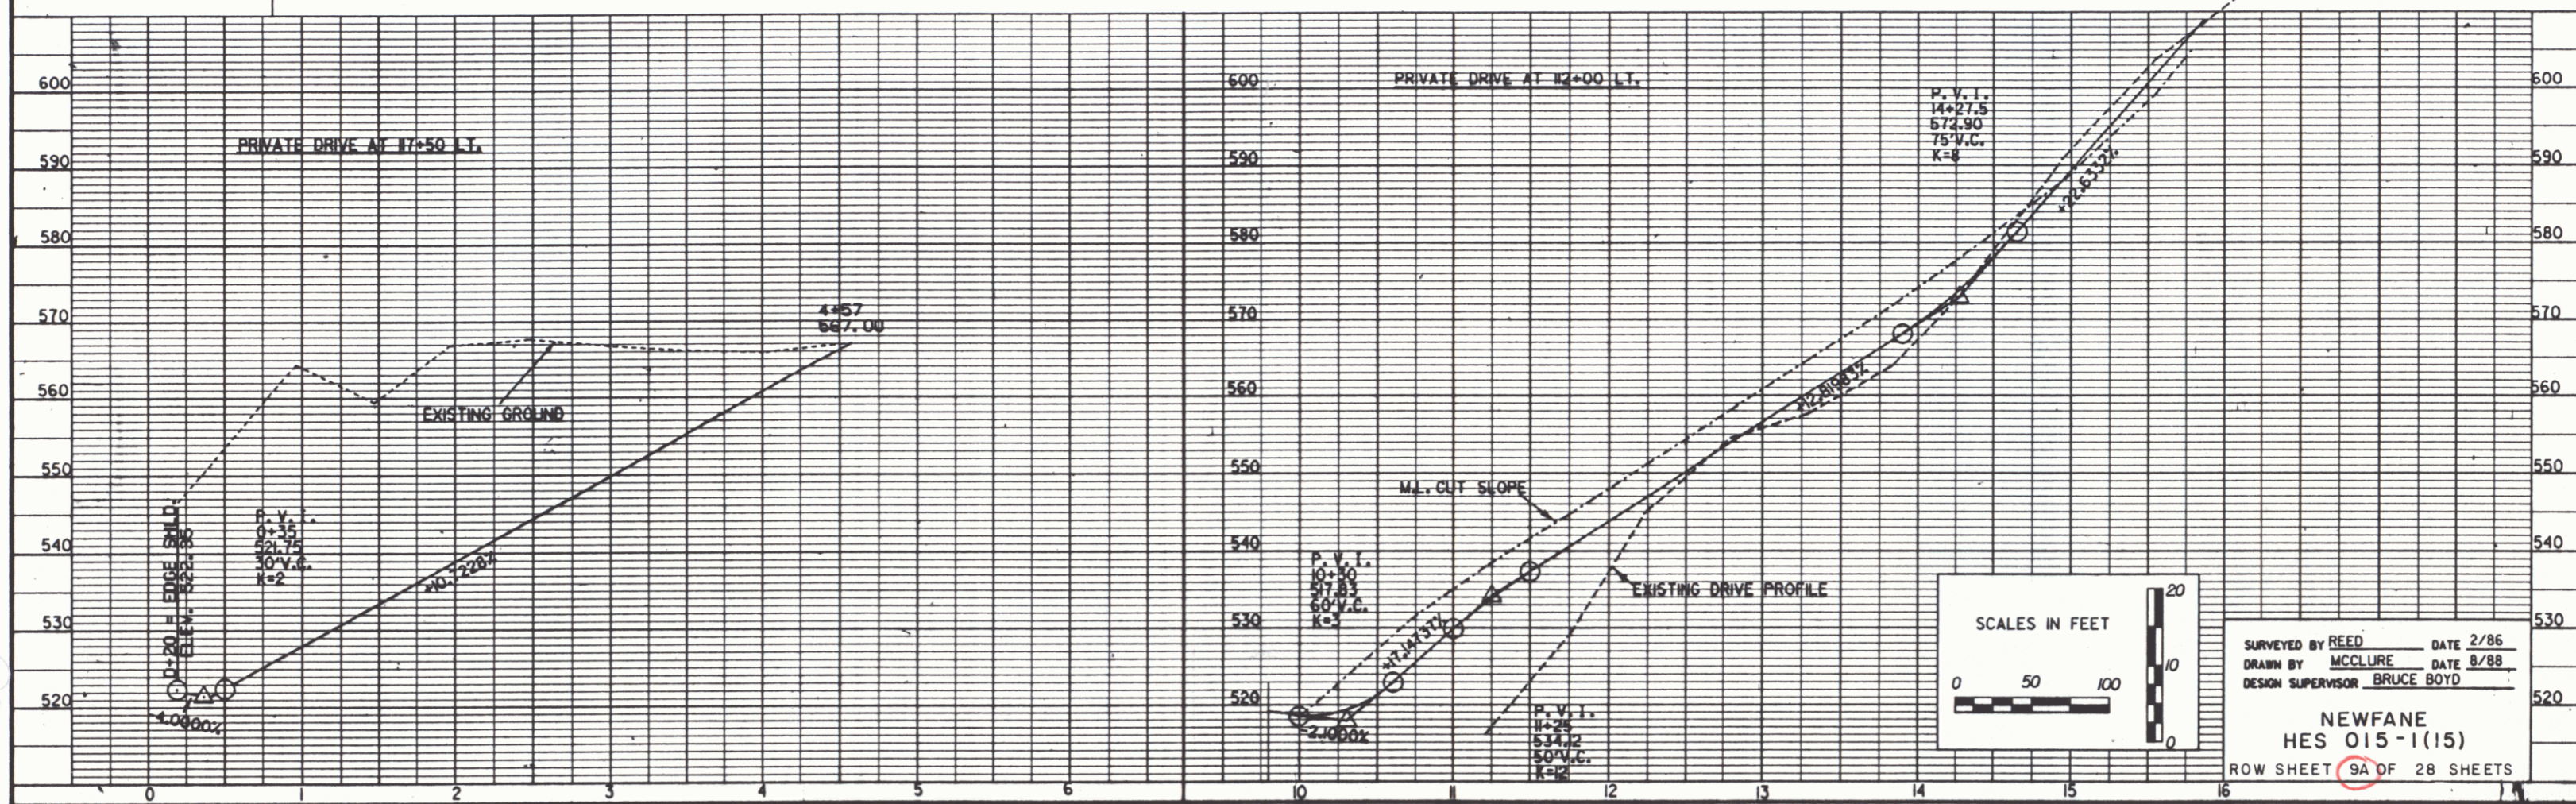

SURVEYED BY REED DATE 2/86
DRAWN BY MCCLURE DATE 8/88
DESIGN SUPERVISOR BRUCE BOYD
NEWFANE
HES 015-1(15)
ROW SHEET 9A OF 28 SHEETS