

INDEX OF SHEETS	
1	TITLE SHEET
2	TYPICAL SHEET
3-5	QUANTITY SHEETS
6	BLANK
7	ITEM DETAIL AND DRAINAGE SHEET
8-9	GRADE AND EARTHWORK SHEET
10-13	R.O.W. DETAIL SHEETS
14-15	PLAN AND PROFILE SHEETS
16-17	BLANK
18-21	TRAFFIC SIGN AND PAVEMENT MARKING SHEETS
22	GUARD RAIL AND OTHER DETAILS
23	RAILBOX SINGLE SUPPORT
24-27	RR DETAILS
28-31	BR 100
32	BLANK
33-40	CROSS SECTION SHEETS+ML
41-45	CROSS SECTION SHEETS+RR
46	BLANK
47	CULVERT SECTIONS

STANDARDS	
A-60	SLOPES IN SOLID ROCK EXCAV. (50MPH & OVER)
B-5	SLOPE GRADING, EMBANKMENTS, RUCK
B-17	GUARD RAIL - BRIDGES, REST AREA, TURNOUTS
B-71A	RESIDENTIAL DRIVES
C-1	CURBS, BITUMINOUS CONCRETE SIDEWALKS
D-2	C.C.M. HEADWALLS, UNDERDRAIN
D-3	TREATED GUTTERS
D-4	FLUSHING BASINS, END SECTION, ELBOWS
D-14	PRECAST CURB DET. GRATE - RCP END SECTION, ETC.
E-100	CONSTRUCTION APPROACH SIGNS
E-101	CONSTRUCTION SIGN DETAILS
E-102	CONSTRUCTION SIGN DETAILS
E-106	TRAFFIC CONTROL - MISCELLANEOUS DETAILS
E-107	DELINEATION, BARRICADES AND DETOURS FOR CONSTRUCTION AREAS
E-107A	BREAKAWAY BARRICADE DETAILS
E-110	MAJOR MAINTENANCE OPERATION LANE CLOSURE
E-121	STANDARD SIGN PLACEMENT - CONVENTIONAL ROAD
E-123	GUIDE SIGN PLACEMENT - MISCELLANEOUS DETAILS
E-132	GENERAL MOTORIST SERVICES SIGN DETAILS
E-151	WARNING SIGN DETAILS
E-152	WARNING SIGN DETAILS
E-140	FLANGED CHANNEL STEEL SIGN POST DETAIL
E-142	TUBULAR ALUMINUM SIGN POST
E-190	RAILROAD CROSSING SIGNS AND PAVEMENT MARKINGS
G-1	STEEL BEAM GUARDRAIL (50MPH & OVER)
G-14	BREAKAWAY CABLE TERMINAL WOOD POSTS
J-1	PROJECT AND BOUNDARY MARKERS
T-1	TEMPORARY EROSION CONTROL DETAILS
T-2	TEMPORARY EROSION CONTROL DETAILS

STATE OF VERMONT
AGENCY OF TRANSPORTATION




PROPOSED IMPROVEMENT
TOWN OF SHELDON
COUNTY OF FRANKLIN
VERMONT ROUTE 105 (FAP)

BEGINNING AT A POINT ON VERMONT ROUTE 105 APPROXIMATELY 6.964 MILES
EASTERLY OF THE SWANTON - SHELDON TOWN LINE AND EXTENDING
EASTERLY 0.483 MILES.

LENGTH OF ROADWAY 2,516 FEET = 0.477 MILES
LENGTH OF RAILROAD CROSSING 3400 FEET = 0.006 MILES
LENGTH OF PROJECT 2,550 FEET = 0.483 MILES

WORK TO BE PERFORMED UNDER THIS PROJECT INCLUDES GRADING, DRAINAGE,
SUBBASE, AND PAVEMENT FOR A VERMONT STATE HIGHWAY RELOCATION AND
INSTALLATION OF A NEW PREFABRICATED RAIL-HIGHWAY CROSSING (ELASTOMERIC)
AND APPROACHES.

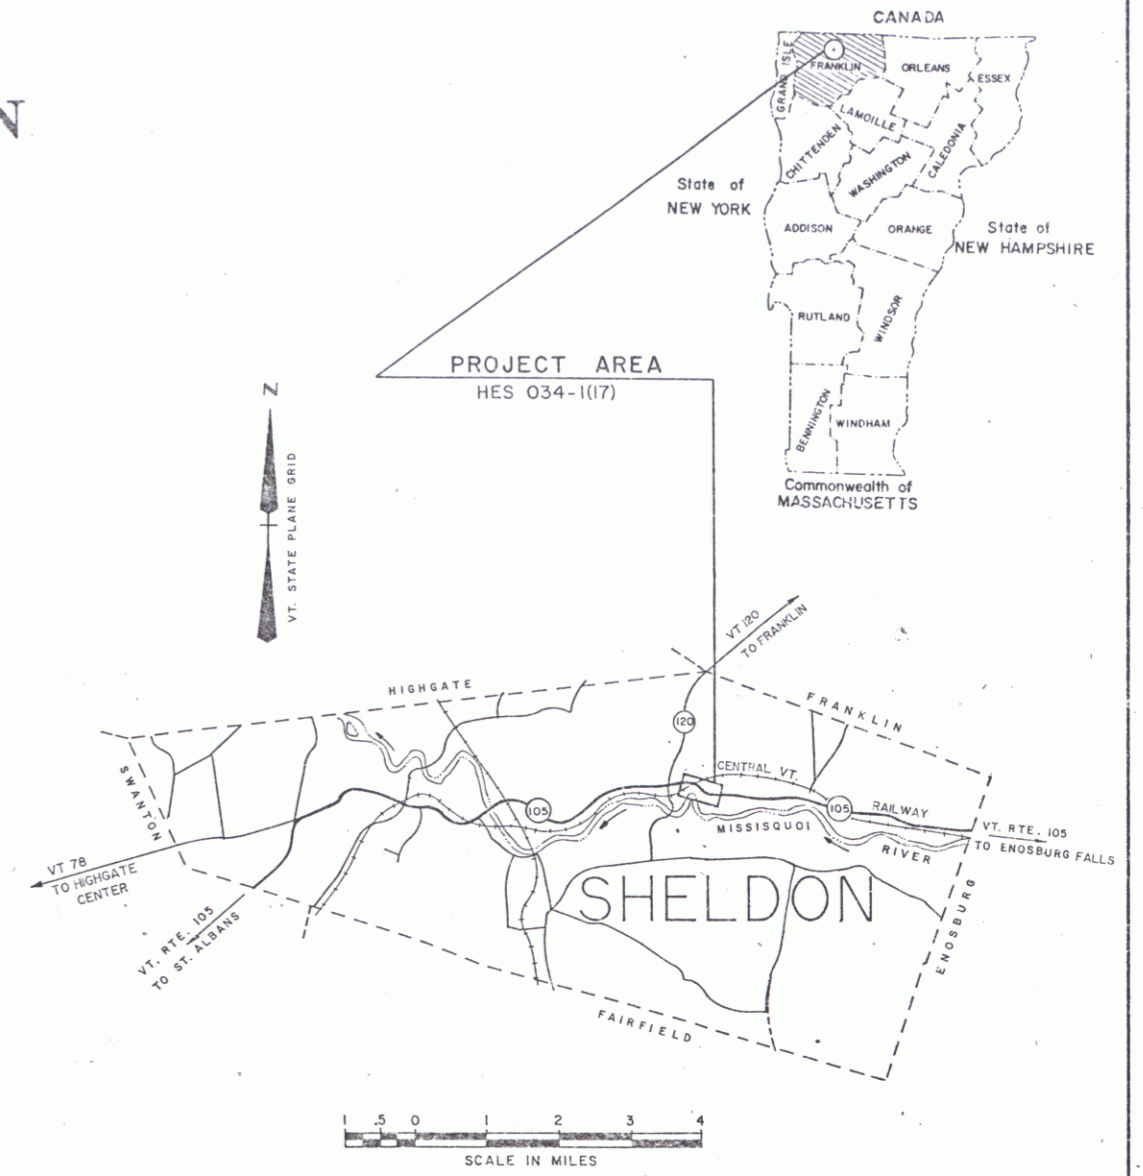

RECORD PLANS

CONTRACTOR J. A. McDonald, Inc.
Lyndon, VT.

RESIDENT ENGINEER R. Hayes
Lyndon, VT.

CONSTRUCTION BEGAN 10/29/90
CONSTRUCTION COMPLETED 12/17/91


RECORD PLANS BY J. Marcell

I hereby certify that all the construction required
by this set of drawings has been accomplished as
indicated herein.

By Edward W. Hayes Resident Engineer
Date April 18, 1992

NOTE: Any further information concerning final quantities,
amounts or other details relative to this project may be found
microfilm in Central Files

CONVENTIONAL SIGNS	
COUNTY LINE	---
TOWN LINE	- - - -
LIMITS OF ACCESS	○
POINT OF ACCESS	X
FENCE LINE	— · — · — ·
STONE WALL	— · — · — ·
TRAVELED WAY	— · — · — ·
GUARD RAIL	— · — · — ·
RAILROAD	— · — · — ·
SURVEY LINE	— · — · — ·
CULVERT	— · — · — ·
POWER POLE	○
TELEPHONE POLE	○
TREES	○
CONTROL OF ACCESS	///
PROPERTY LINE	— · — · — ·
ROW TAKING LINE	— · — · — ·
SLOPE RIGHTS	○ SR △
TOP OF CUT	△
TOE OF SLOPE	○
EXISTING DITCH	— · — · — ·
NEW DITCH	— · — · — ·

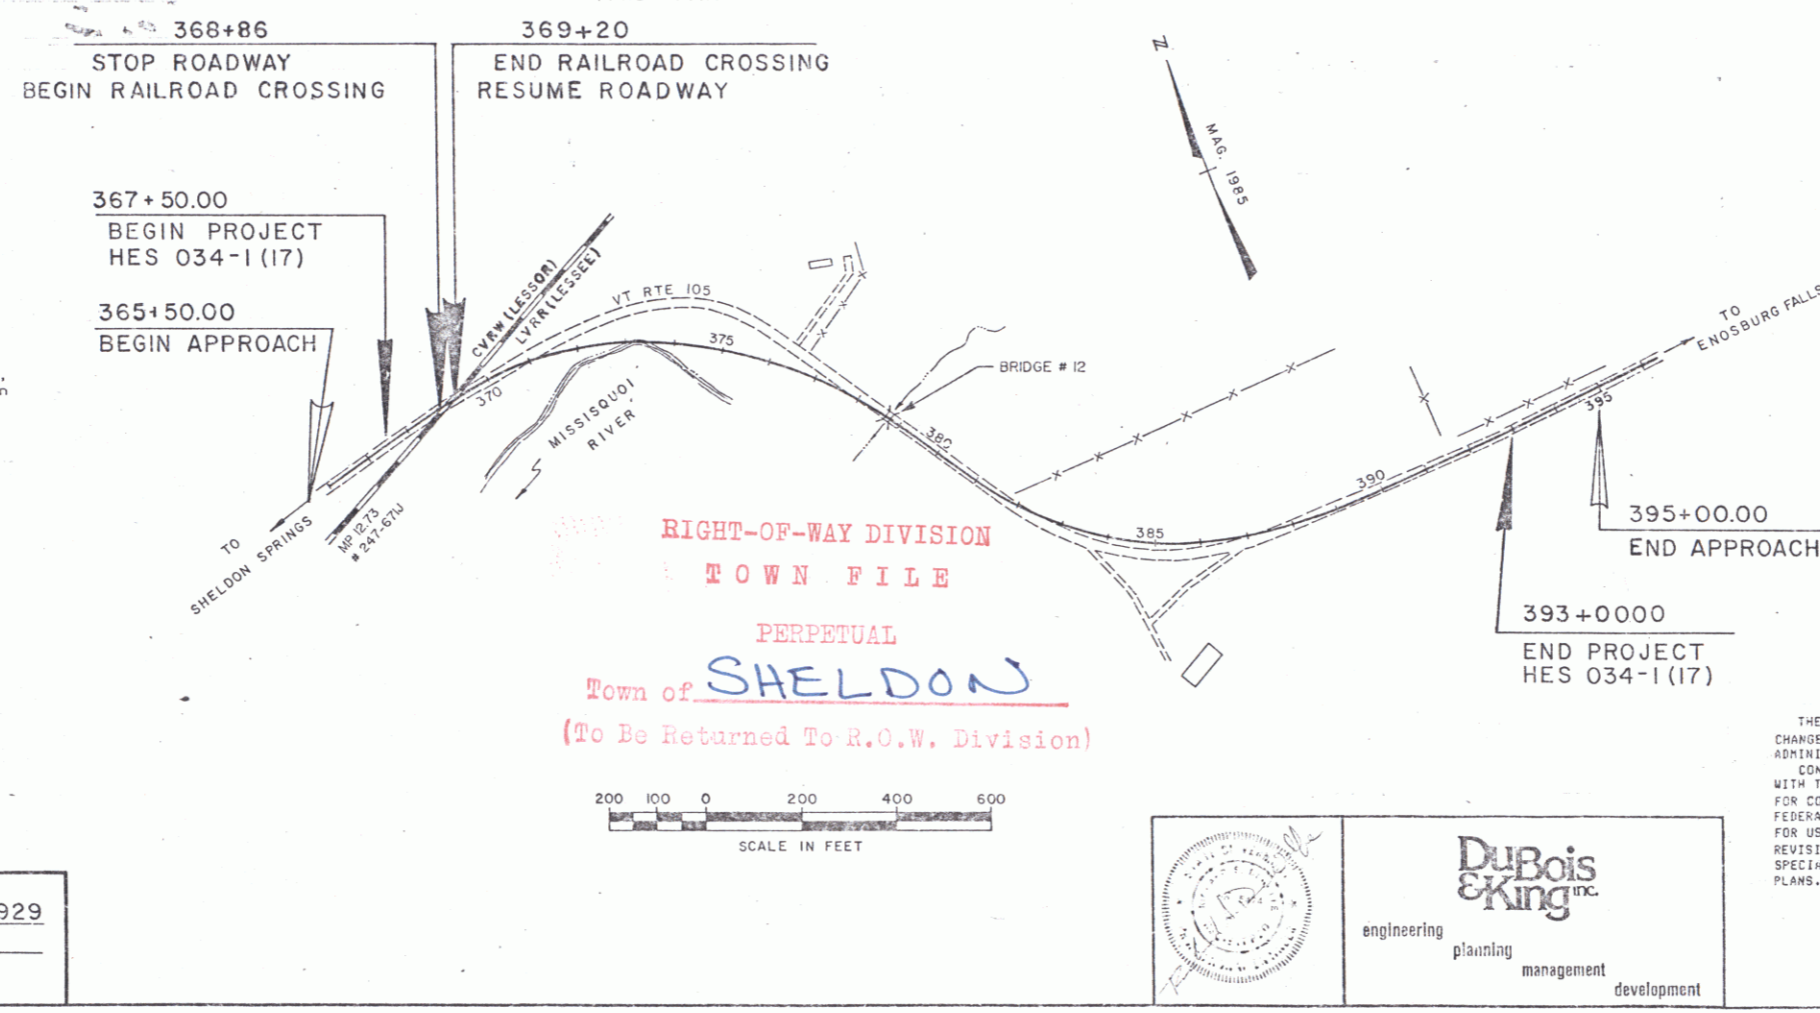

CONSTRUCTION
PLANS

TRAFFIC DATA

1988 ADT	= 3260
2008 ADT	= 4390
2008 DHV	= 600
D	= 57%
T	= 9%
V	= 50 MPH

THESE PLANS ARE SUBJECT TO SUCH ENGINEERING
CHANGES AS MAY BE REQUIRED BY THE FEDERAL HIGHWAY
ADMINISTRATION OR THE AGENCY SECRETARY.
CONSTRUCTION IS TO BE CARRIED ON IN ACCORDANCE
WITH THESE PLANS AND THE STANDARD SPECIFICATIONS
FOR CONSTRUCTION DATED 1984, AS APPROVED BY THE
FEDERAL HIGHWAY ADMINISTRATION ON NOVEMBER 21, 1985
FOR USE ON THIS PROJECT, INCLUDING ALL SUBSEQUENT
REVISIONS AND SUCH REVISED SPECIFICATIONS AND
SPECIAL PROVISIONS AS ARE INCORPORATED IN THESE
PLANS.

SUBMITTED BY ORDER OF THE STATE TRANSPORTATION BOARD	
APPROVED <u>Arthur J. G...</u>	DATE <u>12/27/91</u>
DIRECTOR OF PLANNING	
DEPARTMENT OF TRANSPORTATION	
FEDERAL HIGHWAY ADMINISTRATION	
APPROVED <u>Frank L. ...</u>	DATE <u>8/11/90</u>
DIVISION ADMINISTRATOR	
SHELDON	
PROJECT HES # 034-1(17)	
SHEET <u>1A</u>	SHEETS