


DESIGNED BY: [Name]  
 CHECKED BY: [Name]  
 DATE: [Date]



DATUM  
 VERTICAL NGVD 1929  
 HORIZONTAL N/A

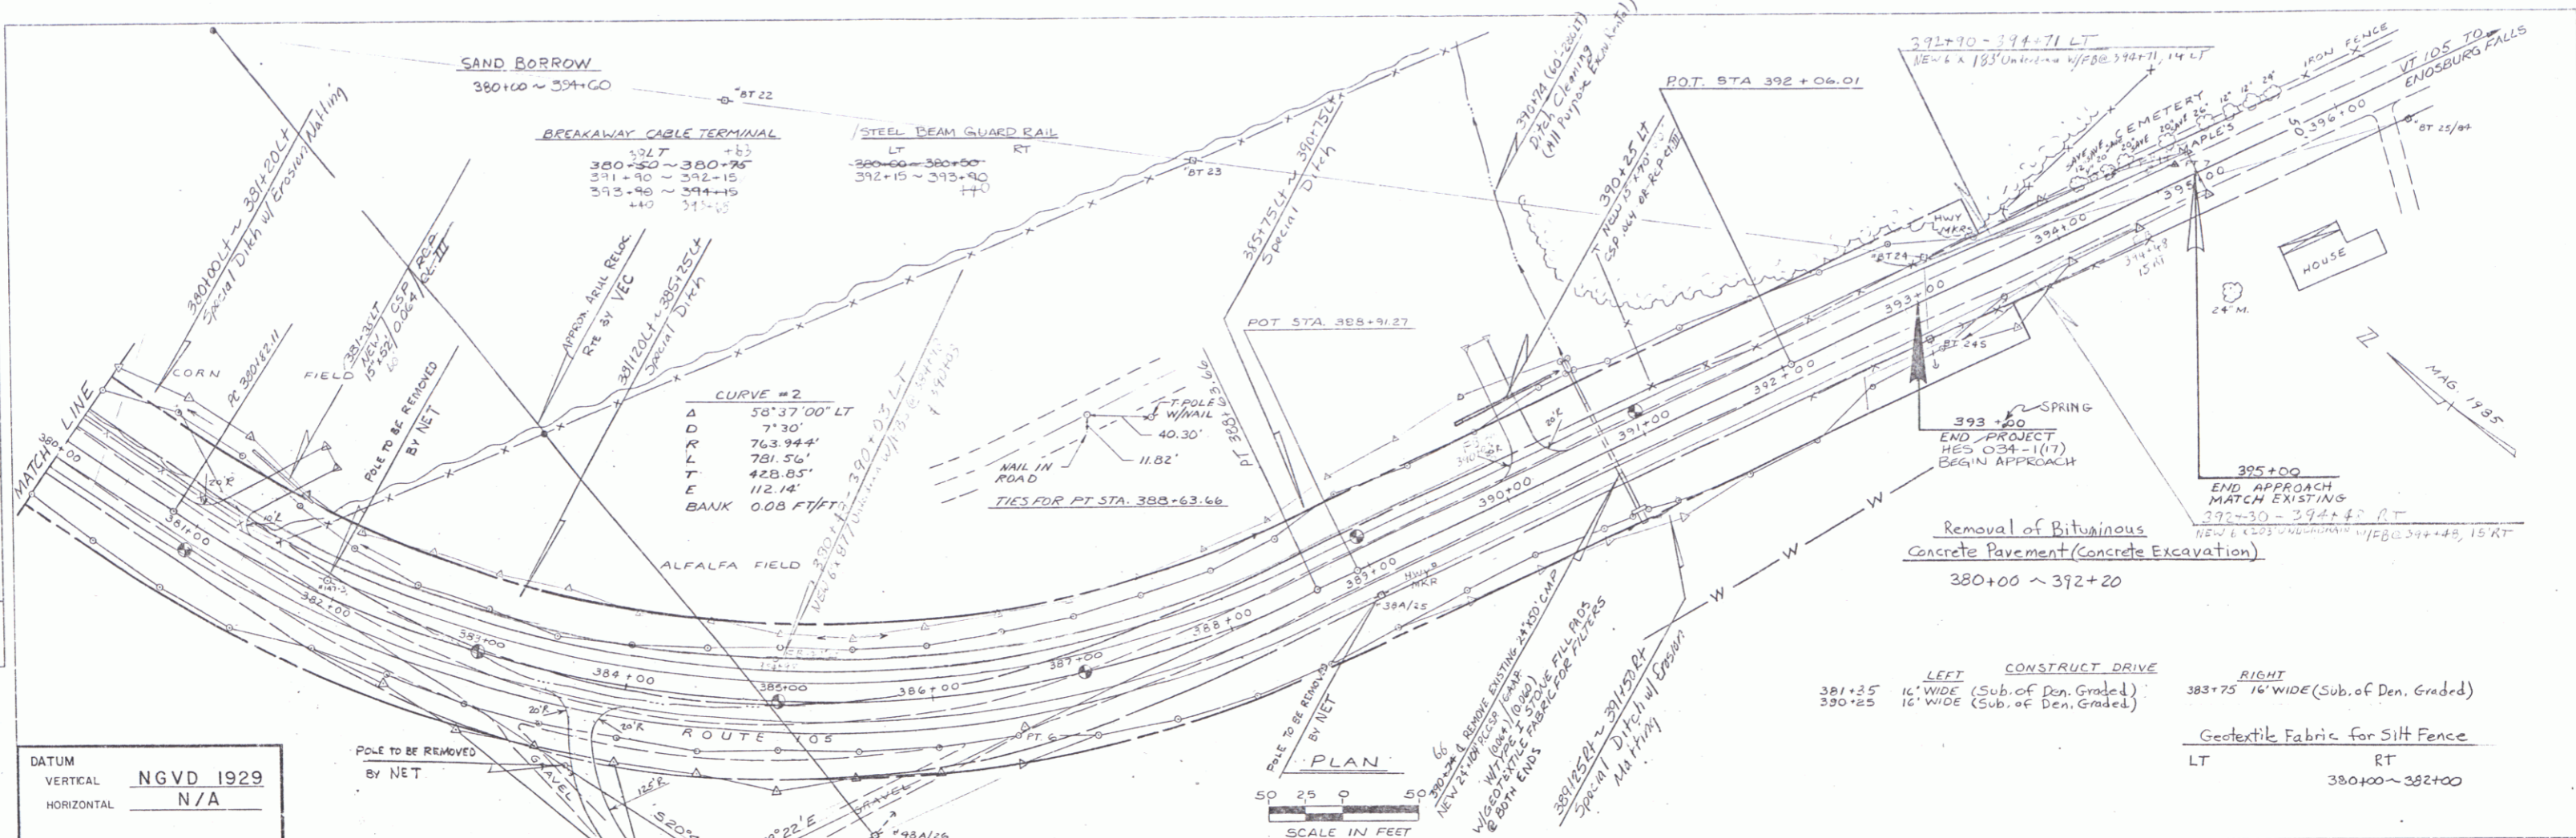