



GPS CONTROL POINTS

HVCTRL #1

V.T.G.S. SURVEY DISK STAMPED
 * GODDARD *
 N = 140062.8520
 E = 482218.6380
 EL. = 240.600

GENERAL LOCATION, STOCKBRIDGE, VT. OWNERSHIP, EDITH GODDARD, 2678 VT RTE 107, STOCKBRIDGE, VT.05772. TO REACH FROM THE INTERSECTION OF VT ROUTES 100 AND 107 GO EAST ALONG VT ROUTE 107 FOR 2.7 MI (4.3 KM) TO THE INTERSECTION OF BLACKMER BOULEVARD LEFT AND A GRAVEL DRIVE RIGHT. TURN RIGHT AND GO SOUTHEAST ALONG THE GRAVEL DRIVE FOR ABOUT 75 M (246.1 FT) TO THE SITE OF THE MARK ON THE RIGHT IN THE FRONT LAWN OF THE GODDARD RESIDENCE. THE MARK IS SET FLUSH WITH GROUND SURFACE IN THE TOP OF A ROCK OUTCROP OF WHICH 0.2 M (0.7 FT) IS EXPOSED. IT IS 30.2 M (99.1 FT) WEST SOUTHWEST OF AND ABOUT 3.5 M (11.5 FT) HIGHER THAN THE CENTERLINE OF THE GRAVEL DRIVE, 19.4 M (63.6 FT) NORTHWEST OF THE NORTH CORNER OF THE HOUSE, 28.2 M (92.5 FT) NORTH OF THE WEST CORNER OF THE ADDITION ON THE HOUSE, 8.2 M (26.9 FT) SOUTHWEST OF A FLAG POLE, AND 25.2 M (82.7 FT) HEAST OF POLE NO IC/79-1.


* DESCRIPTION PROVIDED BY VERMONT AGENCY OF TRANSPORTATION GEODETIC SURVEY UNIT.

HVCTRL #2


V.T.G.S. SURVEY DISK STAMPED
 * GODDARD AZ MK *
 N = 140489.2110
 E = 482565.4360
 EL. = 225.690

GENERAL LOCATION, STOCKBRIDGE, VT. OWNERSHIP, ELOISE THOMPSON, 3080 VT ROUTE 107, STOCKBRIDGE, VT.05772. TO REACH FROM THE INTERSECTION OF VT ROUTES 100 AND 107 GO EAST ALONG VT ROUTE 107 FOR 3.0 MI (4.8 KM) TO THE SITE OF THE MARK ON THE LEFT IN A LAWN. IT IS JUST EAST OF THE STOCKBRIDGE CENTRAL SCHOOL. THE MARK IS SET FLUSH WITH GROUND SURFACE IN THE TOP OF A 30 CM DIAMETER CONCRETE MONUMENT POURED 1.2 M (3.9 FT) DEEP. IT IS 17.6 M (57.7 FT) NORTH OF AND ABOUT 0.5 M (1.6 FT) LOWER THAN THE NORTH EDGE OF PAVEMENT OF VT ROUTE 107, 43.9 M (144.0 FT) NORTHEAST OF POLE NO 177/3/85, 21.0 M (68.9 FT) SOUTHWEST OF THE SOUTHWEST CORNER OF A FOUR BAY GARAGE, AND 17.6 M (57.7 FT) NORTH NORTHWEST OF POLE NO 1761/2 /85X AND


TRAVERSE TIES

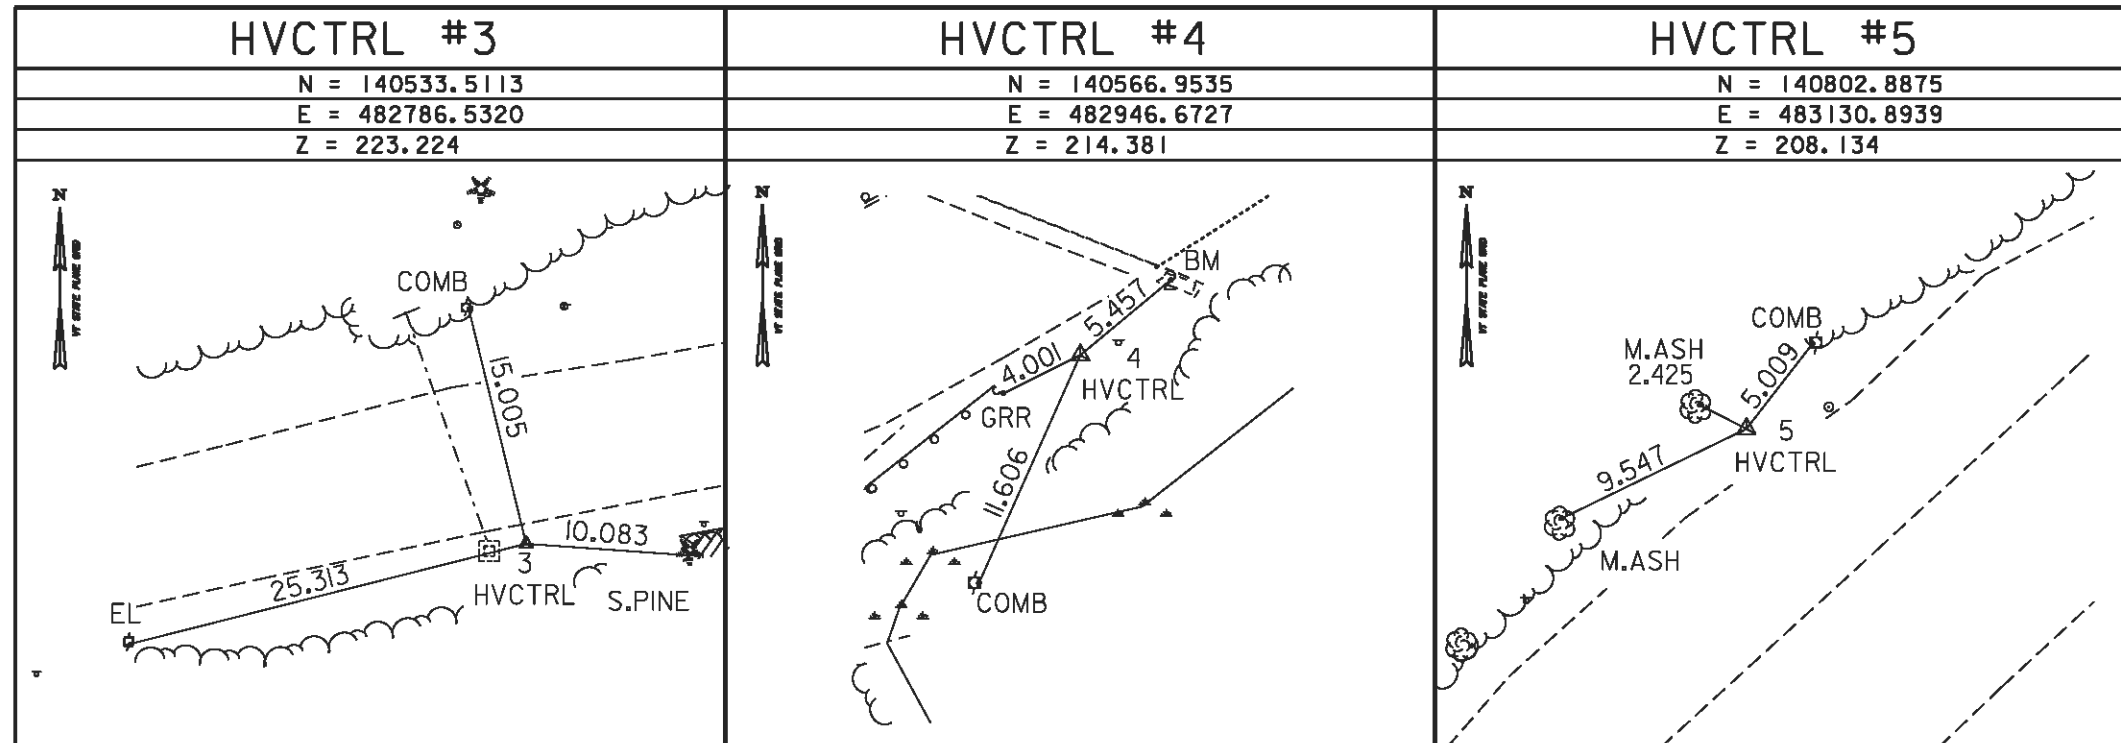

ALIGNMENT TIES

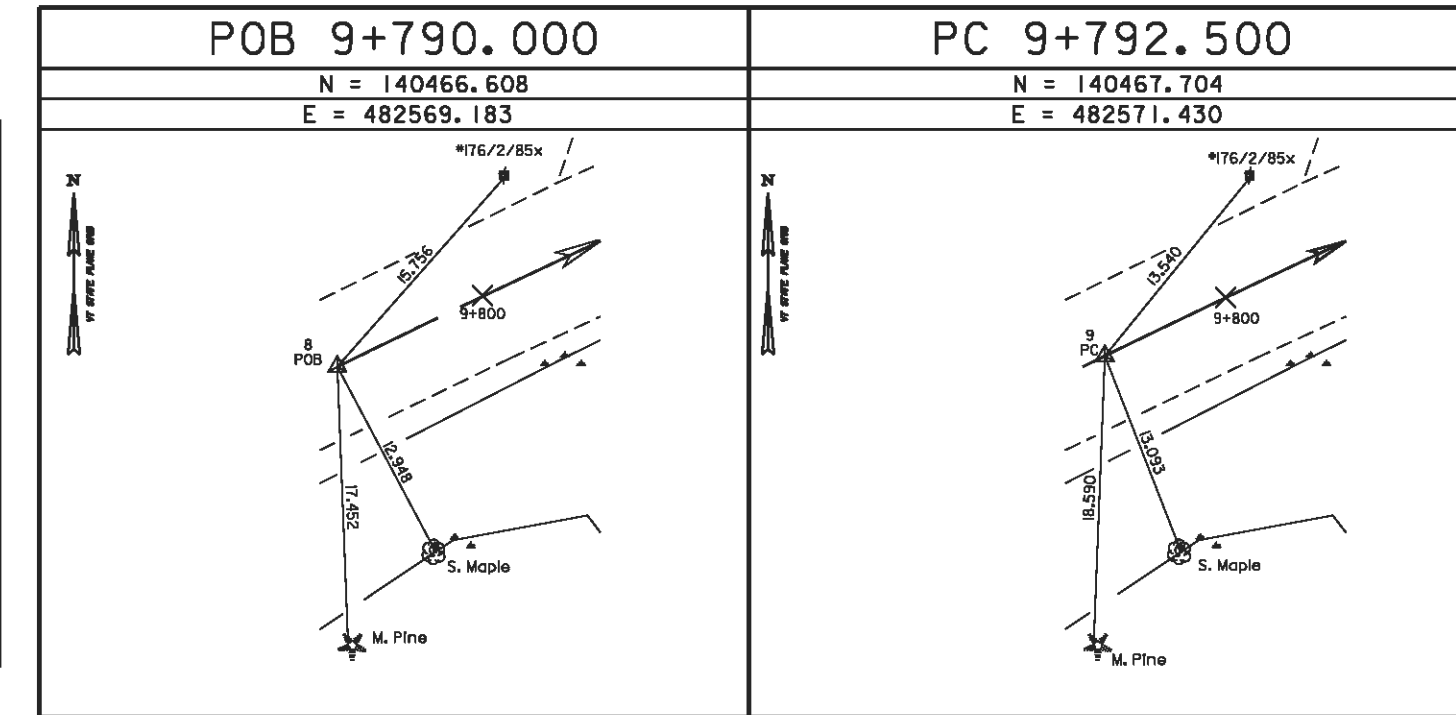

ALIGNMENT TIES

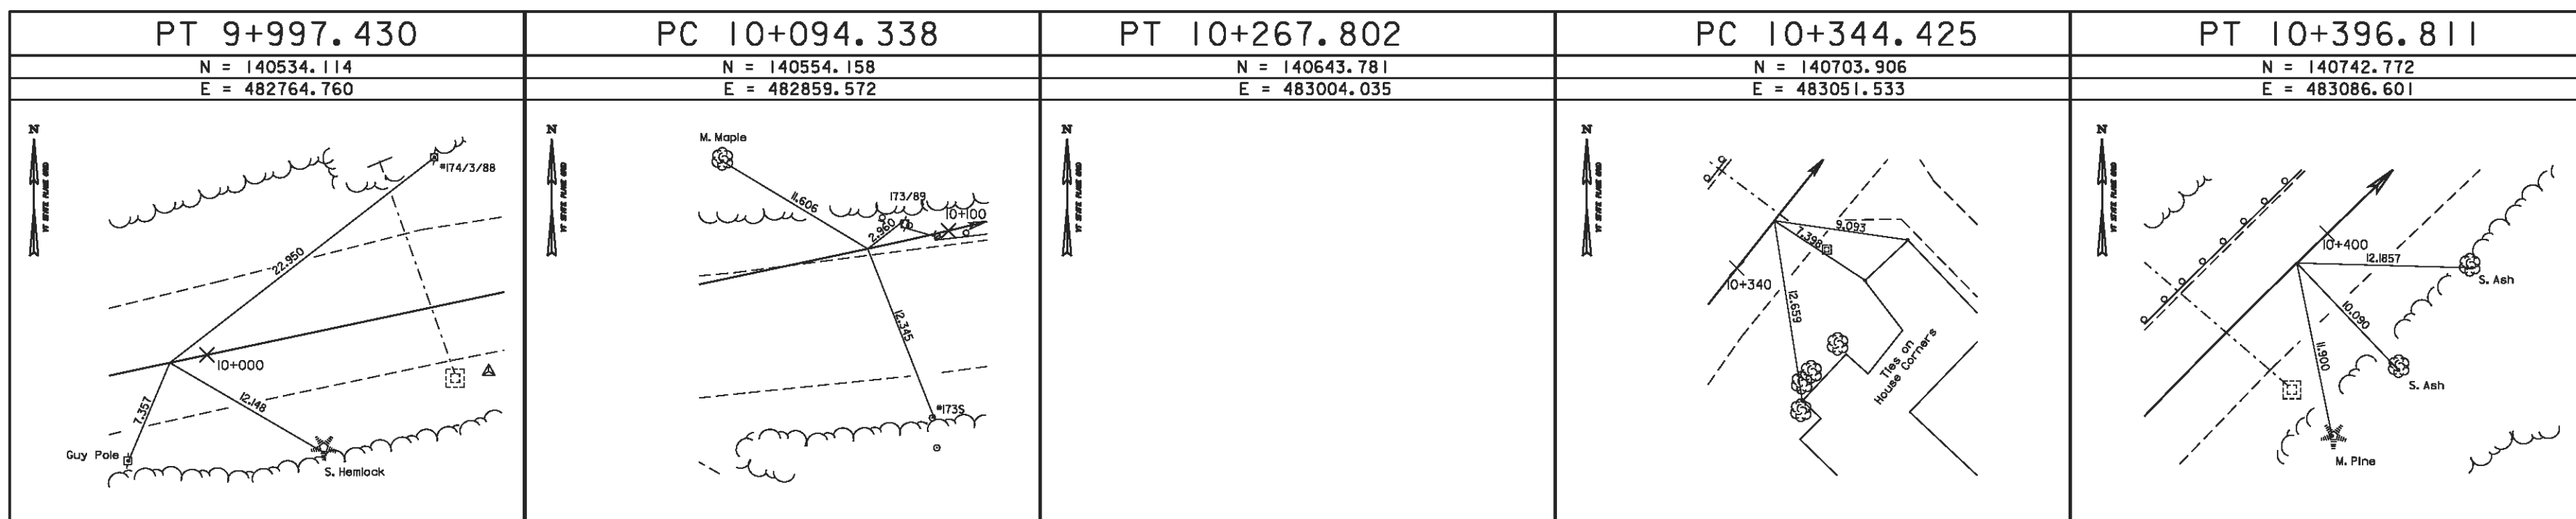

DATUM	
VERTICAL	NAVD 88
HORIZONTAL	NAD 83/96
ADJUSTMENT	none

PROJECT NAME:	STOCKBRIDGE	PLOT DATE:	04-MAR-2010
PROJECT NUMBER:	BRF 022-1(20)SC	DRAWN BY:	H.I. SALLS
FILE NAME:	str4/85e039/ds039t1.dgn	CHECKED BY:	R.S. YOUNG
PROJECT LEADER:	C.P. WILLIAMS	TIE SHEET 1	ROW SHEET 4 OF 33