

INDEX OF SHEETS


1.	TITLE	
2.	TYPICAL SECTION, WATERBURY-STOWE	
3.	TYPICAL SECTION, MORRISTOWN-WOLCOTT	
4-5.	QUANTITY SHEETS	
6-10.	ITEM DETAIL SHEETS	
11.	DRAINAGE DETAILS	
12.	GUARD RAIL DETAILS	
13-14.	MAILBOX SUPPORT HARDWARE	
15-16.	DETAILS FOR WIDENING AT BEN & JERRY'S @ WATERBURY MM 1.21	
17-19.	BLANK	
19-22.	BR100 SERIES-VT 15 OVER GREEN RIVER @ WOLCOTT MM 0.63	
23-39.	TRAFFIC SIGN AND PAVEMENT MARKING DETAILS	
40.	TEMPORARY SIGNAL AT WOLCOTT MM 0.63	
41-74.	EXISTING R.O.W. PLAN SHEETS	
75.	C-1 CURB	10/25/85R
76.	D-2 UNDERDRAIN	10/30/85R
77.	D-4 METAL END SECTIONS	10/30/85R
78.	D-6 RCDI	04/04/73R
79.	D-8 RCDI	12/06/71
80.	D-9 TOP FOR RCDI	12/06/71
81.	D-11 CAST IRON GRATE TYPE A	08/24/81R
82.	D-15 CAST IRON GRATE TYPE E	10/30/85R
83.	D-16 CAST IRON GRATE TYPE B	10/30/85R
84.	E-2 ROAD CONSTRUCTION APPROACH SIGNS	02/03/86R
85.	E-6 ON PROJECT CONSTRUCTION SIGNS	02/03/86R
86.	E-7 DELINEATION AND BARRICADES FOR CONSTRUCTION AREAS	02/03/86R
87.	E-7A BARRICADE DETAILS-BREAKAWAY	02/03/86R
88.	E-8 TYPICAL MAJOR MAINTENANCE OPERATION	02/03/86R
89.	E-11 INTERSTATE ROUTE AND AUXILIARY MARKERS	02/03/86R
90.	E-13 STATE ROUTE AND AUXILIARY MARKERS	02/03/86R
91.	E-14B GENERAL SERVICE SIGNS	02/03/86R
92.	E-15A REGULATORY SIGNS	02/03/86R
93.	E-15B REGULATORY SIGNS	02/03/86R
94.	E-15C REGULATORY SIGNS	02/03/86R
95.	E-19 WARNING SIGNS	02/03/86R
96.	E-19A WARNING SIGNS	02/03/86R
97.	E-19B WARNING SIGNS	02/03/86R
98.	E-23 GUIDE SIGNS	12/03/86R
99.	E-24A SIGN SUPPORTS	02/03/86R
100.	E-25 SIGN SUPPORTS	02/03/86R
101.	E-29 STANDARD SIGN PLACEMENT, NON-EXPRESSWAY	02/03/86R
102.	E-34 TRAFFIC SIGNAL ITEM DETAILS	02/03/86R
103.	E-50 PAVEMENT MARKING DETAILS	02/03/86R
104.	G-1 STEEL BEAM GUARD RAIL	10/31/85R
105.	G-1D STEEL BEAM GUARD RAIL	10/31/85R
106.	G-4 WOOD MARKER POSTS	10/31/85R
107.	G-14 BREAKAWAY CABLE TERMINAL	10/31/85R
108.	SR-R6-82 BRIDGE RAILING-HEAVY DUTY STEEL BEAM	12/13/84R

STATE OF VERMONT AGENCY OF TRANSPORTATION



PROPOSED IMPROVEMENT TOWNS OF WATERBURY, STOWE, MORRISTOWN AND WOLCOTT COUNTIES OF WASHINGTON & LAMOILLE VT. RTE. 100 AND VT. RTE. 15 (F.A.P.) 1986 PAVING PROGRAM - DISTRICT 6

WORK TO BE DONE UNDER THIS CONTRACT INCLUDES HIGHWAY RESURFACING, UPGRADING
GUARD RAIL, DRAINAGE FEATURES, AND SIGN POSTS.

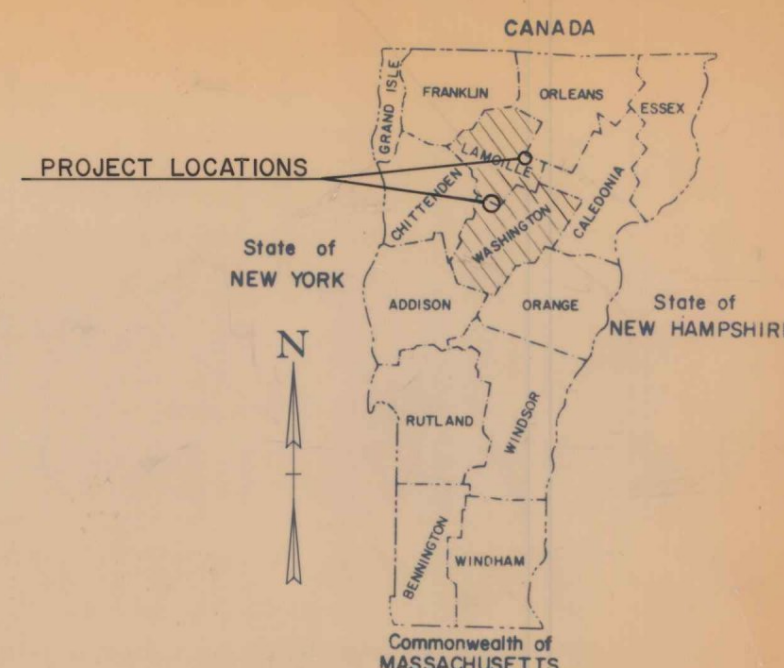

RECORD PLANS AND MATERIAL SUPPLIERS
CONTRACTOR: PIKE INDUSTRIES R.F.D. #2 BOX 91
TILTON, N.H.

RESIDENT ENGINEER: RAY HAYES
CONTRACT DATED: JUNE 5, 1987
CONSTRUCTION BEGAN: JUNE 29, 1987
CONSTRUCTION COMPLETED: OCT. 16, 1987
CONSTRUCTION ACCEPTED: OCT. 27, 1987

RECORD PLANS: ROBERT E. SMITH
GRAVEL: FERLANO PIT, HYDE PARK, VT.

WALKER PIT, EDEN VT.
AGGREGATE SHOULDERS: COTA PIT, WOLCOTT, VT.
METAL PIPE: PENN CULVERT CO. INC., NORTH
BELLICA, MASS.

CONC. PIPE: S.T. GRISWOLD CO. INC. WILLISTON, VT.
BIT. CONC. PAVEMENT: PIKE INDUSTRIES, JOHNSON VT.
C.S. RES.: CONTECH CONSTRUCTION PRODUCTS
SENTON ST. PALMER, MASS.

TREATED TIMBER CURB, WOOD MARKER POSTS,
STEEL BEAM GUARD RAIL, TRAFFIC SIGNS, SIGN
POSTS: F.R. LAFAYETTE, KELLOGG RD.
ESSEX JCT., VT.

REINFORCING STEEL: K. ROSS BLDG. SUPPLY CO. INC.
LEBANON, N.H.
MORRISTOWN-WOLCOTT CONC. CLASS B: A.G. ANDERSON CO. INC.
WATERBURY, VT.

WATERBURY-STOWE
F 029-1(12)
VT 100
BEGINNING ON VT 100 AT WATERBURY M.M. 0.858
AND EXTENDING NORTHERLY 8.830 MILES TO STOWE M.M. 2.945
LENGTH OF PROJECT=46,624 FEET=8.830 MILES.
1986 ADT=6670

PROJECT
WATERBURY - STOWE F 029-1(12)

PROJECT
MORRISTOWN - WOLCOTT F 030-2(16)


MORRISTOWN-WOLCOTT
F 030-2(16)
VT 15
BEGINNING ON VT 15 AT MORRISTOWN M.M. 3.095
AND EXTENDING EASTERLY 3.988 MILES TO WOLCOTT M.M. 2.716
LENGTH OF PROJECT=21,054 FEET=3.988 MILES.
1986 ADT=3590

CONVENTIONAL SIGNS

COUNTY LINE	---
TOWN LINE	---
LIMITS OF ACCESS	---
POINT OF ACCESS	X
FENCE LINE	---
STONE WALL	---
TRAVELED WAY	---
GUARD RAIL	---
RAILROAD	---
SURVEY LINE	---
CULVERT	---
POWER POLE	---
TELEPHONE POLE	---
TREES	---
CONTROL OF ACCESS	---
PROPERTY LINE	---
RIGHT TAKING LINE	---
SLOPE RIGHTS	SR
TOP OF CUT	---
TOP OF SLOPE	---

DATUM	
VERTICAL	N.A.
HORIZONTAL	N.A.

SCALE: 1" = 5 Miles

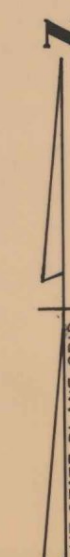

THESE PLANS ARE SUBJECT TO SUCH ENGINEERING
CHANGES AS MAY BE REQUIRED BY THE FEDERAL HIGHWAY
ADMINISTRATION OR THE CHIEF ENGINEER.
CONSTRUCTION IS TO BE CARRIED ON IN ACCORDANCE
WITH THESE PLANS AND THE STANDARD SPECIFICATIONS
FOR CONSTRUCTION DATED 1986, AS APPROVED BY THE
FEDERAL HIGHWAY ADMINISTRATION ON NOVEMBER 21, 1985
FOR USE ON THIS PROJECT, INCLUDING ALL SUBSEQUENT
REVISIONS AND SUCH REVISED SPECIFICATIONS AND
SPECIAL PROVISIONS AS ARE INCORPORATED IN THESE
PLANS.

SUBMITTED BY ORDER OF THE STATE TRANSPORTATION BOARD	
APPROVED	DATE 9-22-86
CHIEF ENGINEER	
DEPARTMENT OF TRANSPORTATION FEDERAL HIGHWAY ADMINISTRATION	
APPROVED	DATE
DIVISION ADMINISTRATOR	
PROJECT 1986 PAVING PROGRAM	
DISTRICT 6	
SHEET 1 OF 105 SHEETS	