

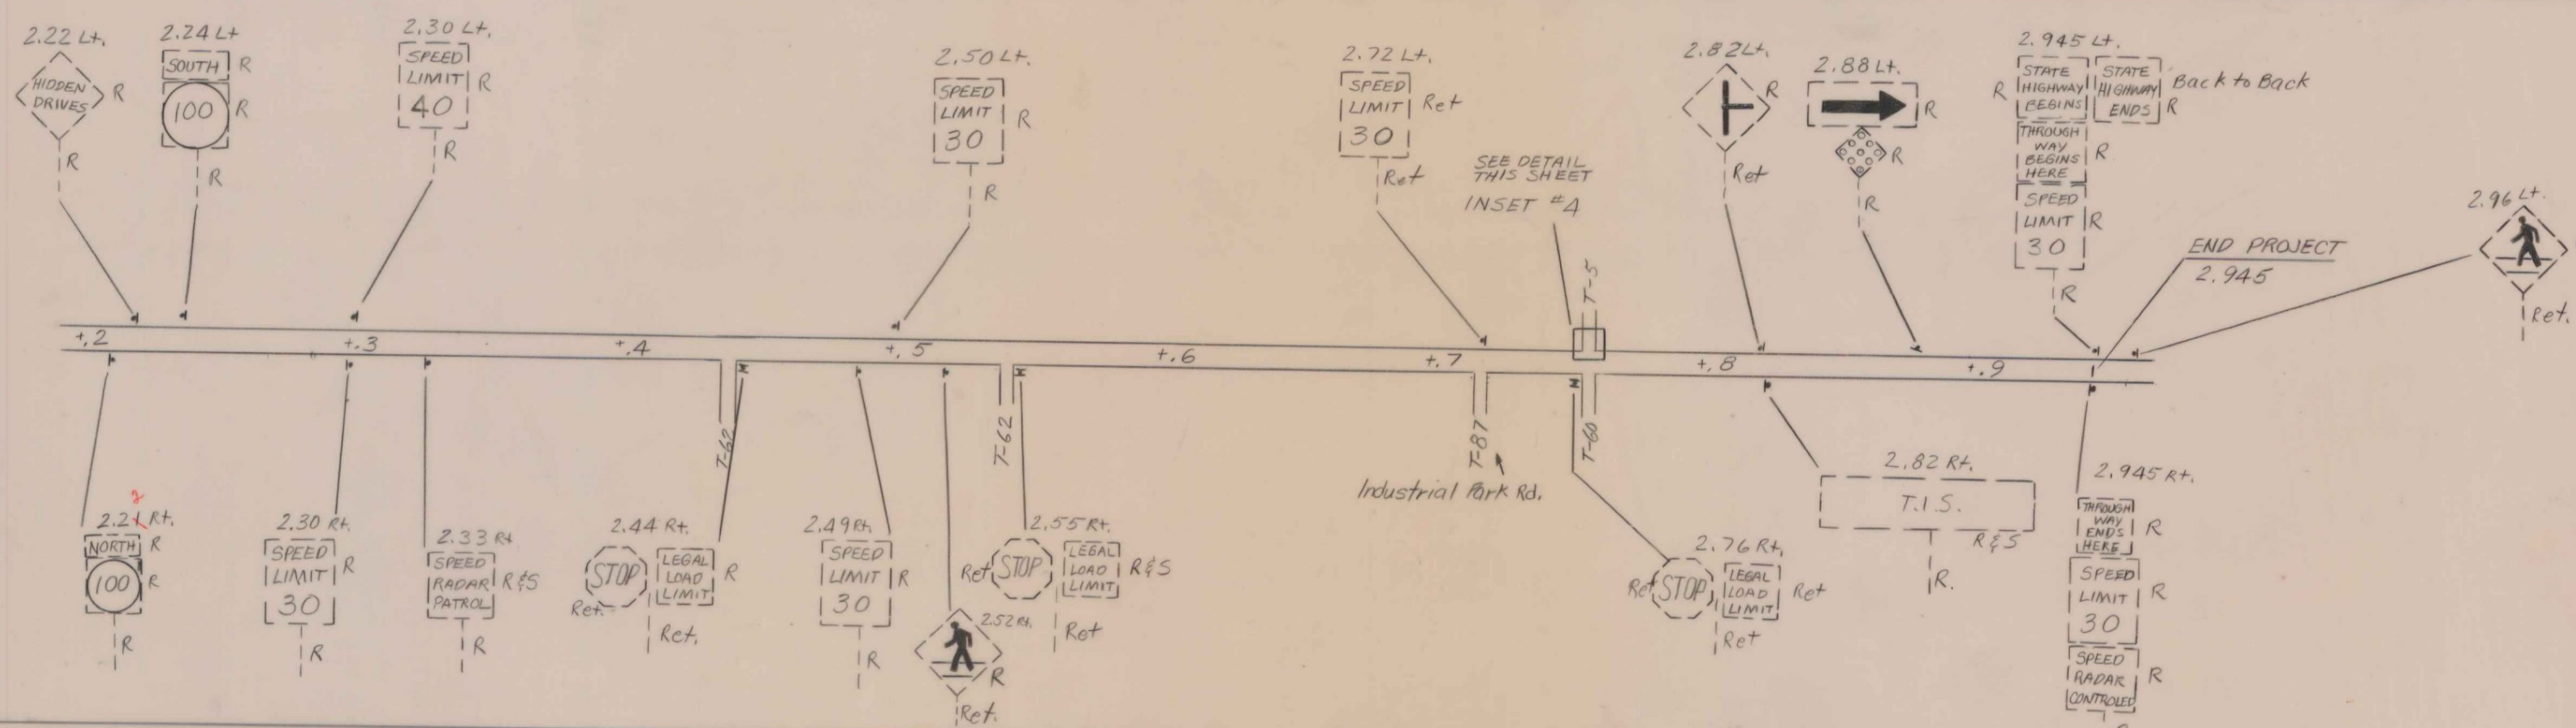
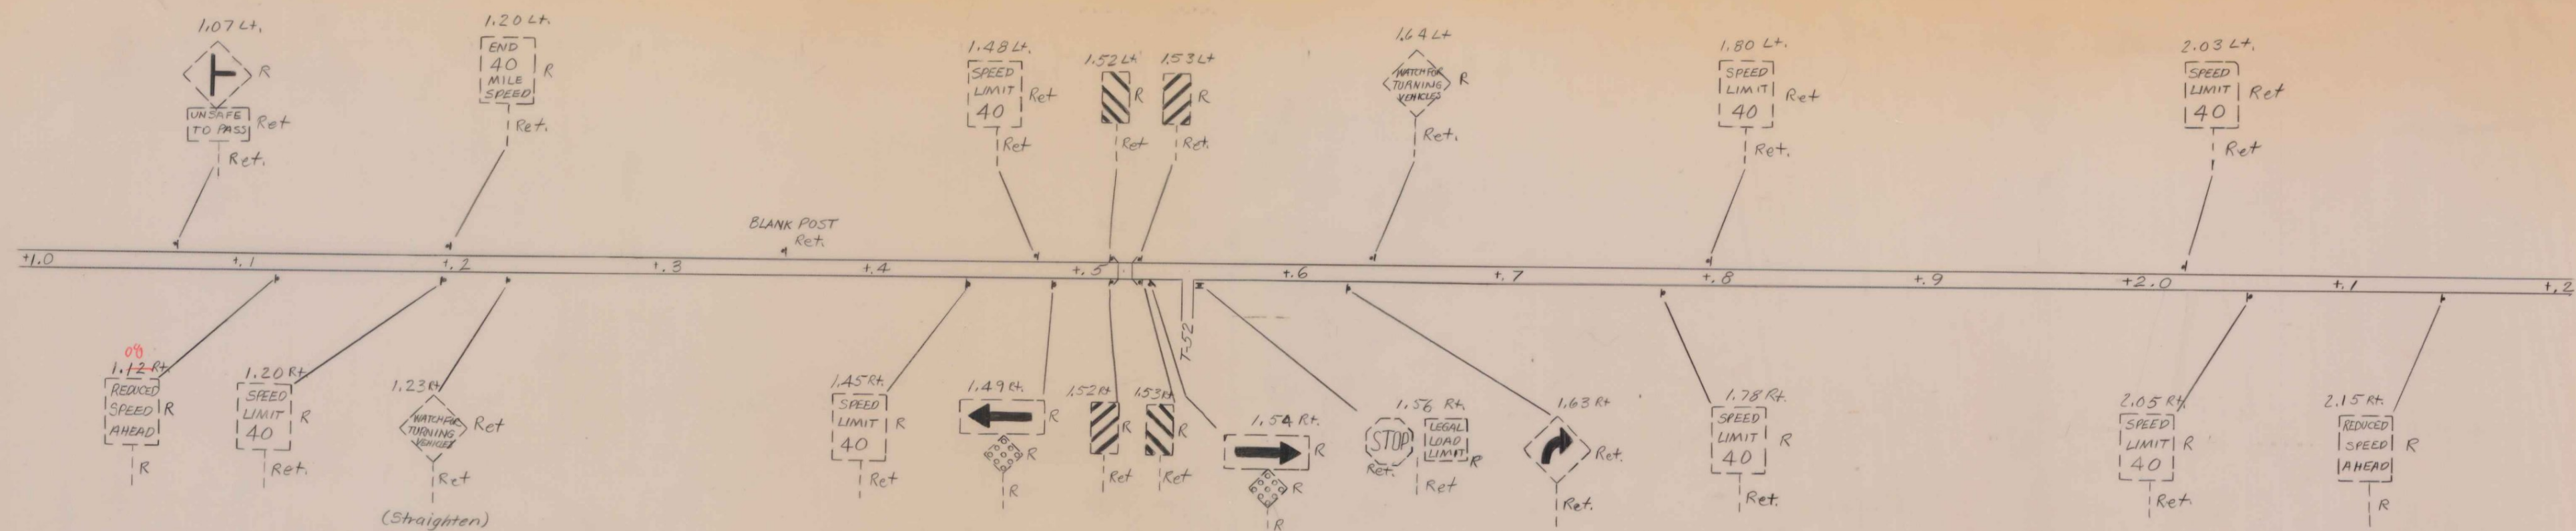
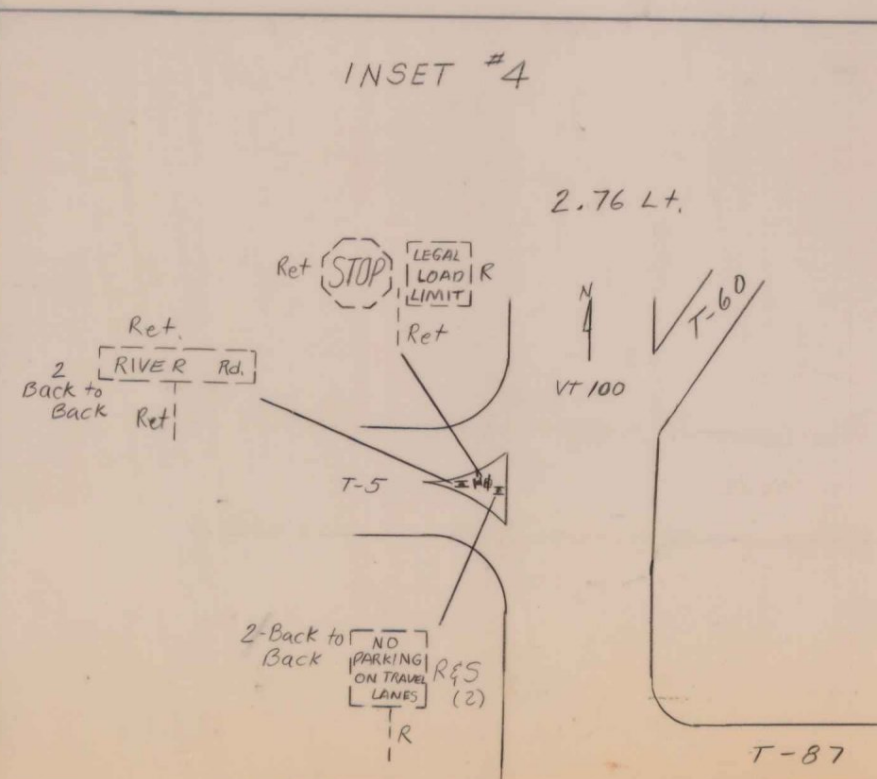
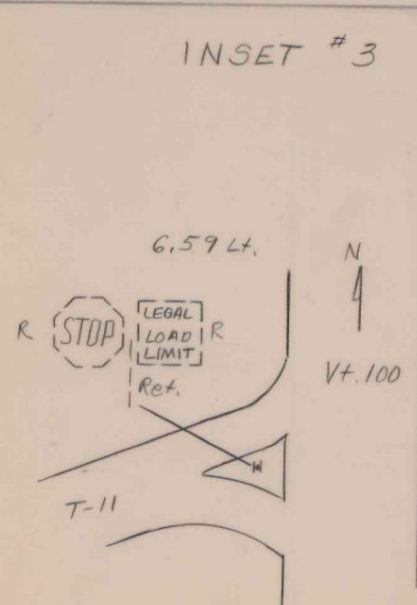


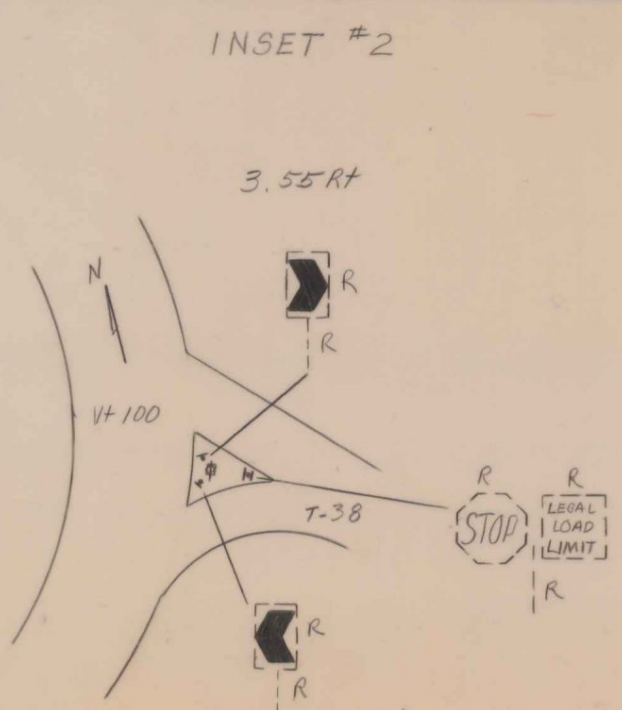

Removing Signs
Mainline - 43 Ea.
Insets - 10 Ea.

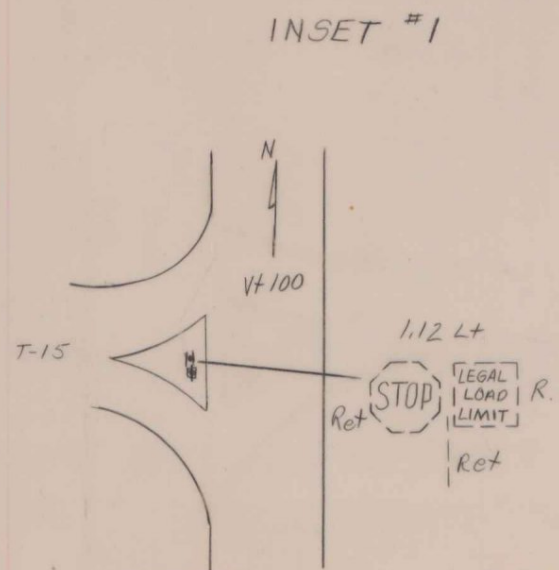

LEGEND

Ret. = Retain
R. = Remove
R & S. = Remove & Salvage

EXISTING SIGNS

PREPARED BY JB	DATE 8-86
CHECKED BY	DATE
WATERBURY ~ STOWE	
PROJ F NO. 029-1(12)	

TRAFFIC SHEET NO. 3	SHEET 25 OF 108
---------------------	-----------------