
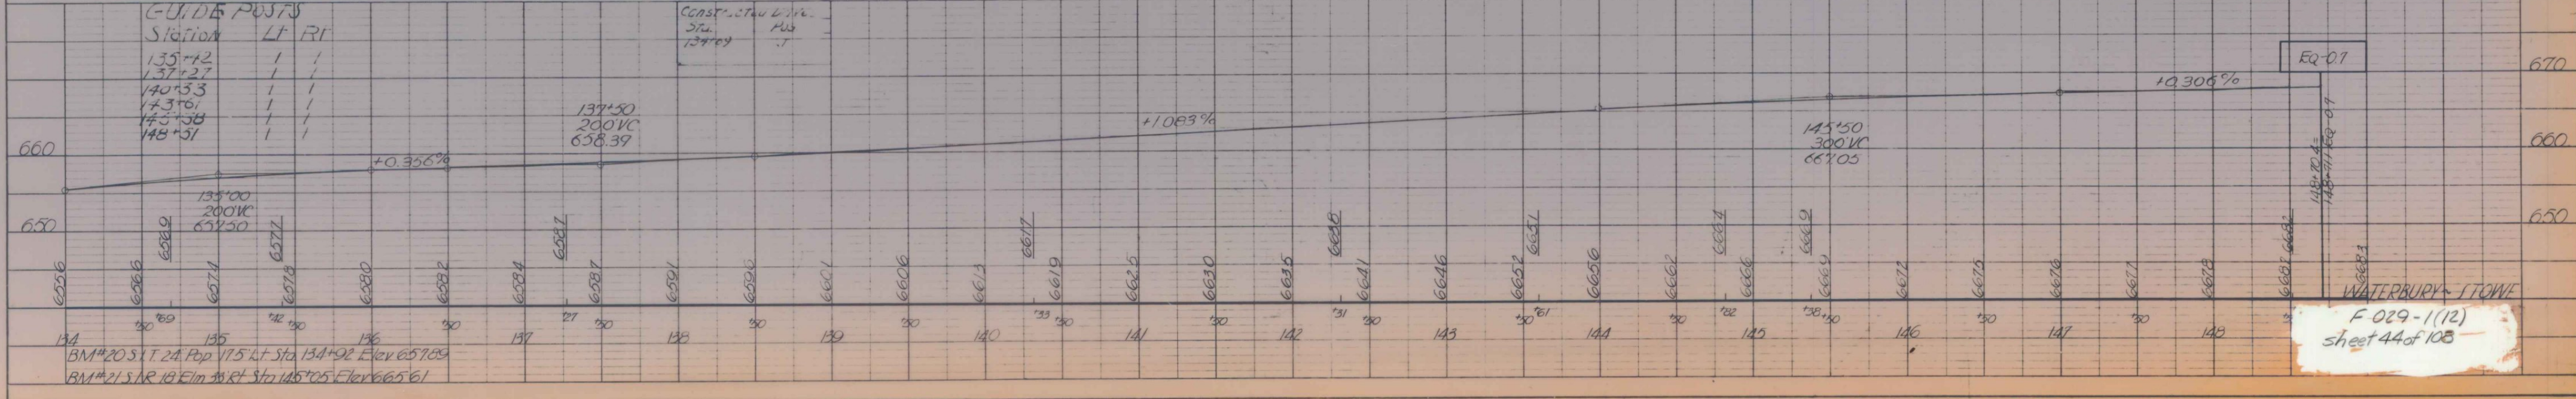
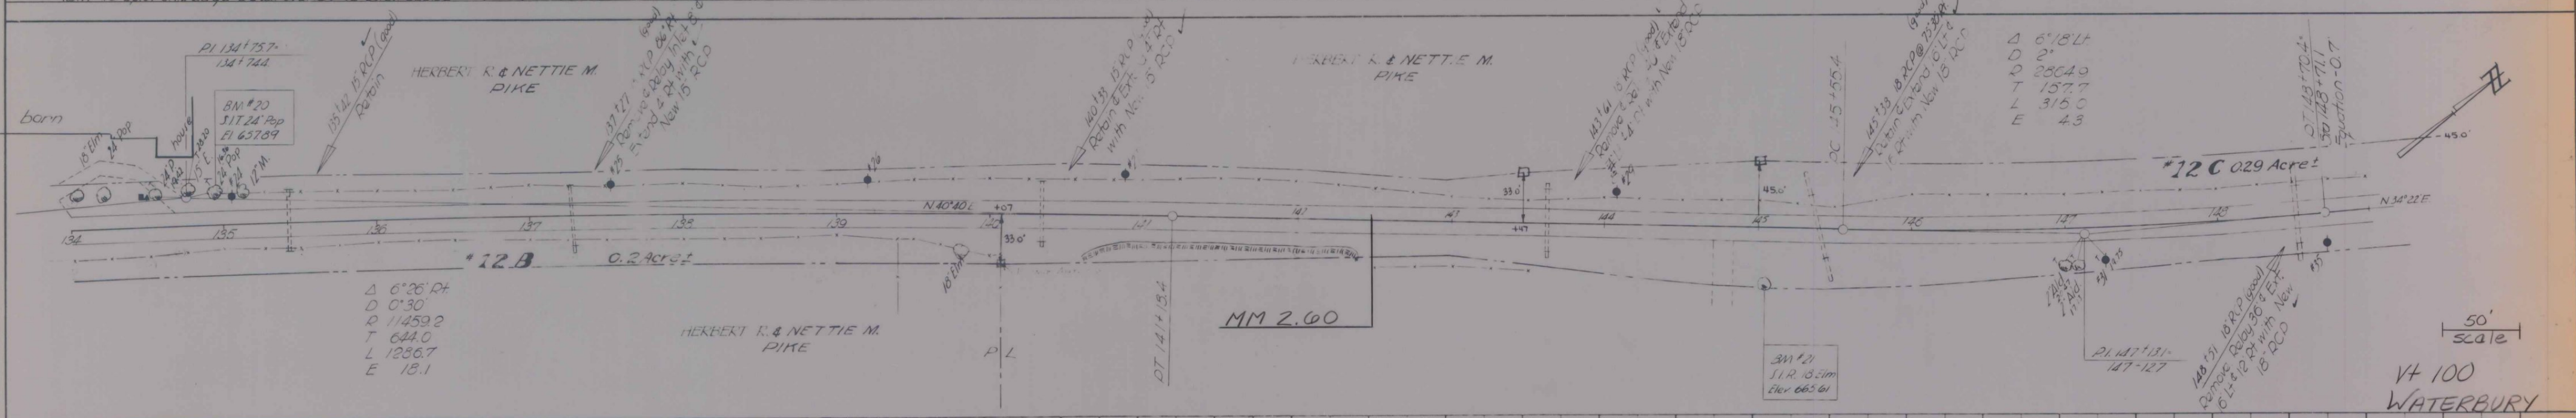
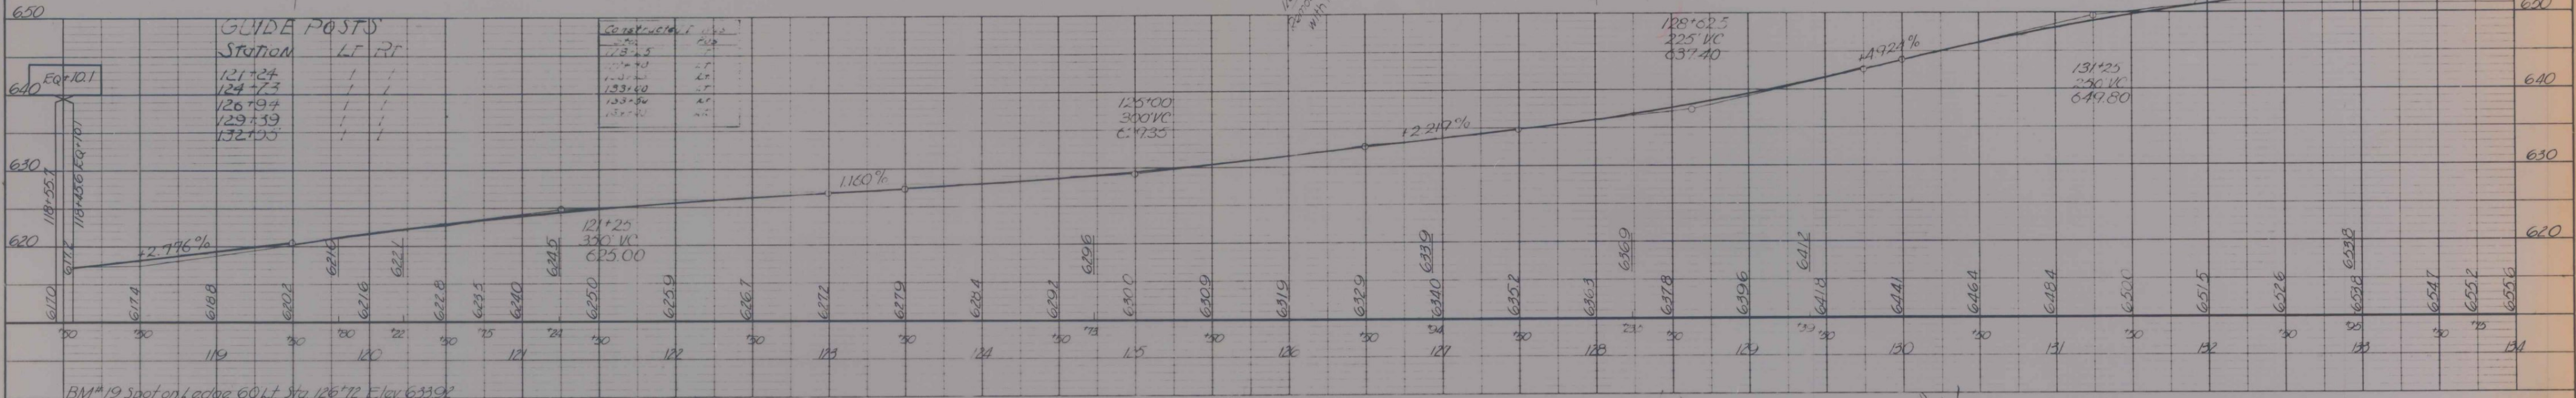


DATE: _____
 BY: Narr Lavery
 SURVEYED: _____
 PLOTTED: _____
 CHECKED: _____
 NOTE BOOK: _____
 NO. _____

DATE: _____
 BY: _____
 SURVEYED: _____
 PLOTTED: _____
 CHECKED: _____
 NOTE BOOK: _____
 NO. _____

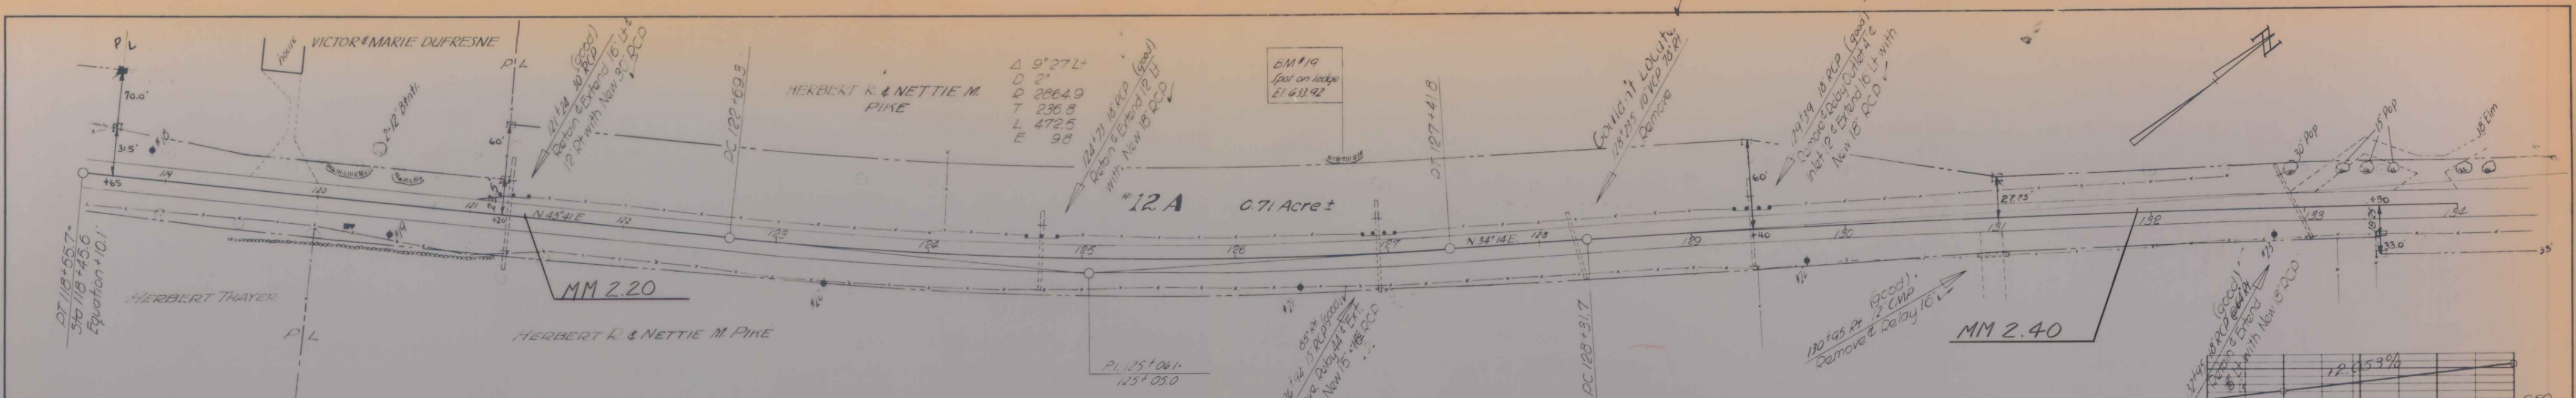

WATERBURY TOWNSHIP
 F 029-1(12)
 Sheet 44 of 108