
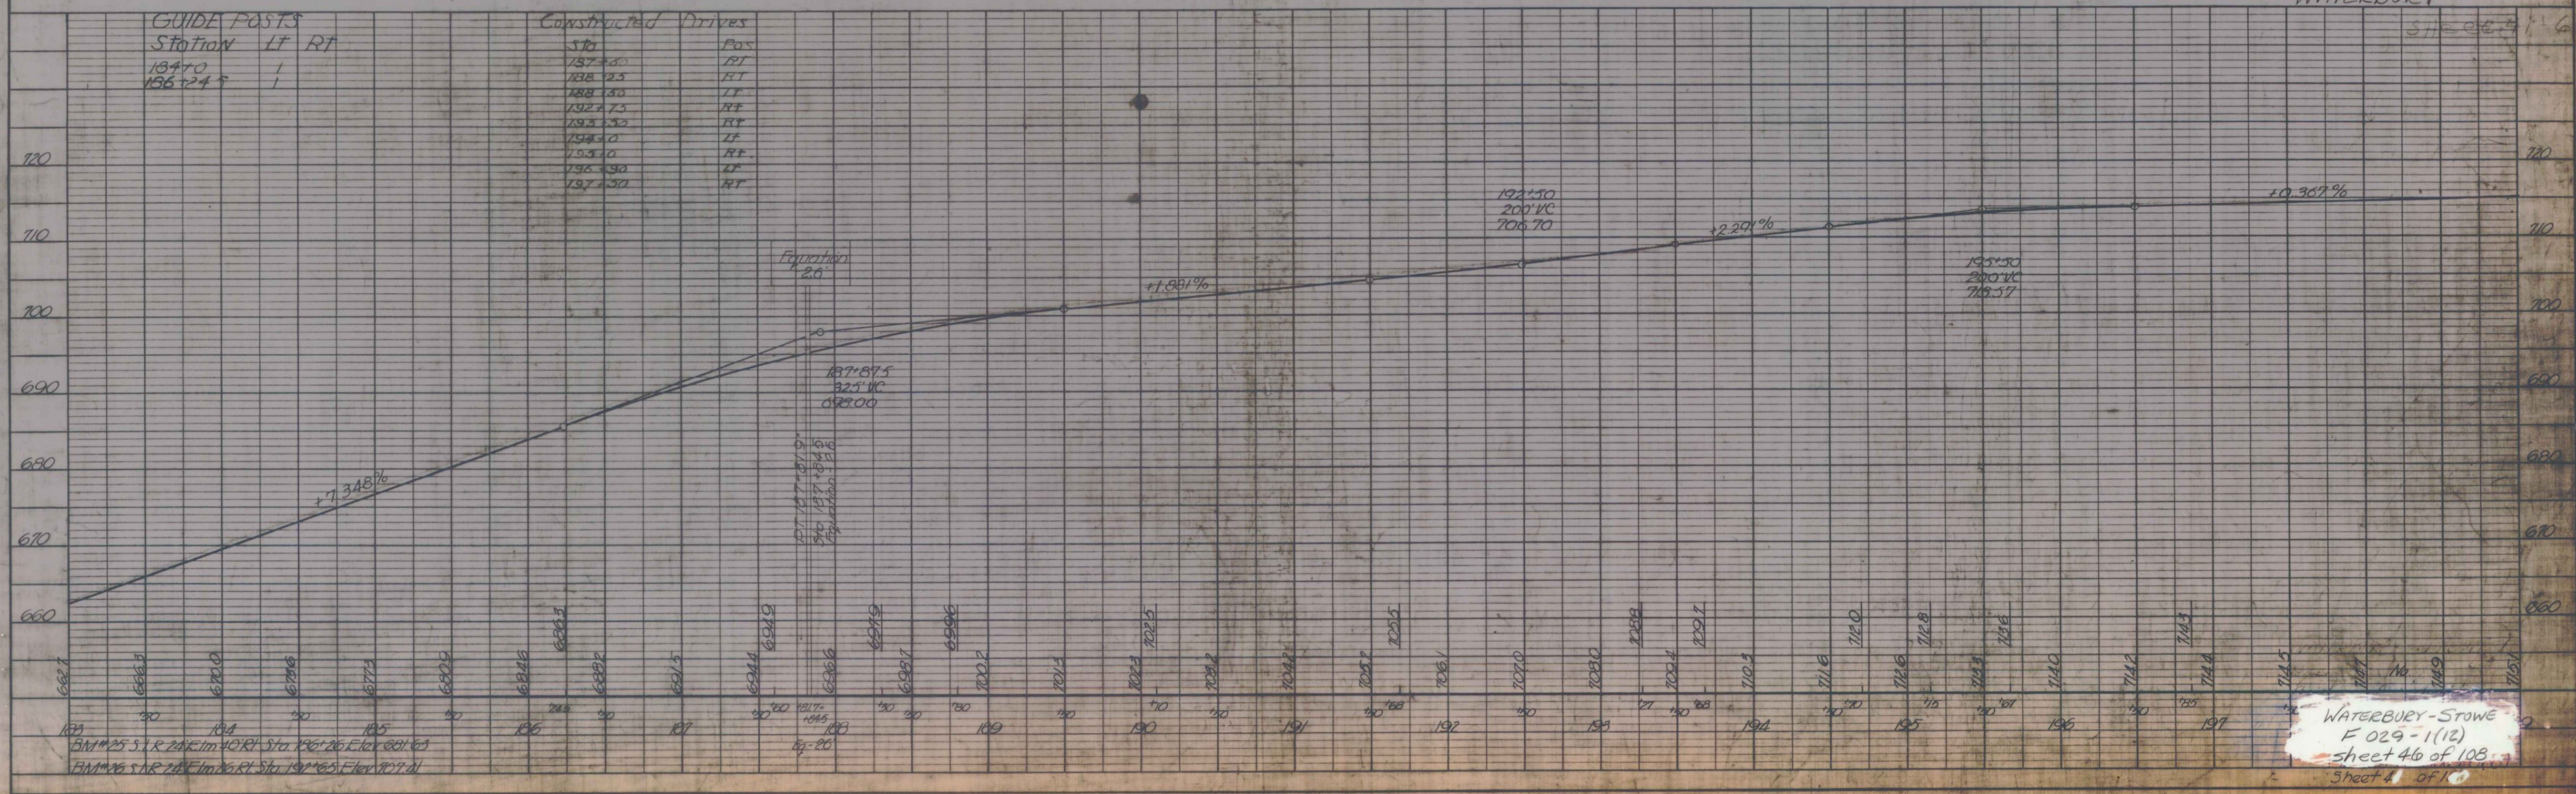


PLAN
 SURVEYED
 PLOTTED
 CHECKED
 BY
 DATE
 NO.

PROFILE
 SURVEYED
 PLOTTED
 CHECKED
 BY
 DATE
 NO.

PARCEL	#16A	#17A	#A
INSTRUMENT	W.D.O.E.	CORP.D.O.E.	W.D.O.E.
DATE	10-3-49	10-21-49	6-30-58
GRANTOR	FRANK H. & IVA B. EARL, FC. LUCE CO. INC. K. & C. Gibbs		
GRANTEE	ST. OF VT.	ST. OF VT.	St. of Vt.
RECORDED	WATERBURY	WATERBURY	Waterbury
BOOK	51	51	53
PAGE	443	464	228B
DATE	10-15-49	10-29-49	1-27-51
REMARKS			Curved Ris

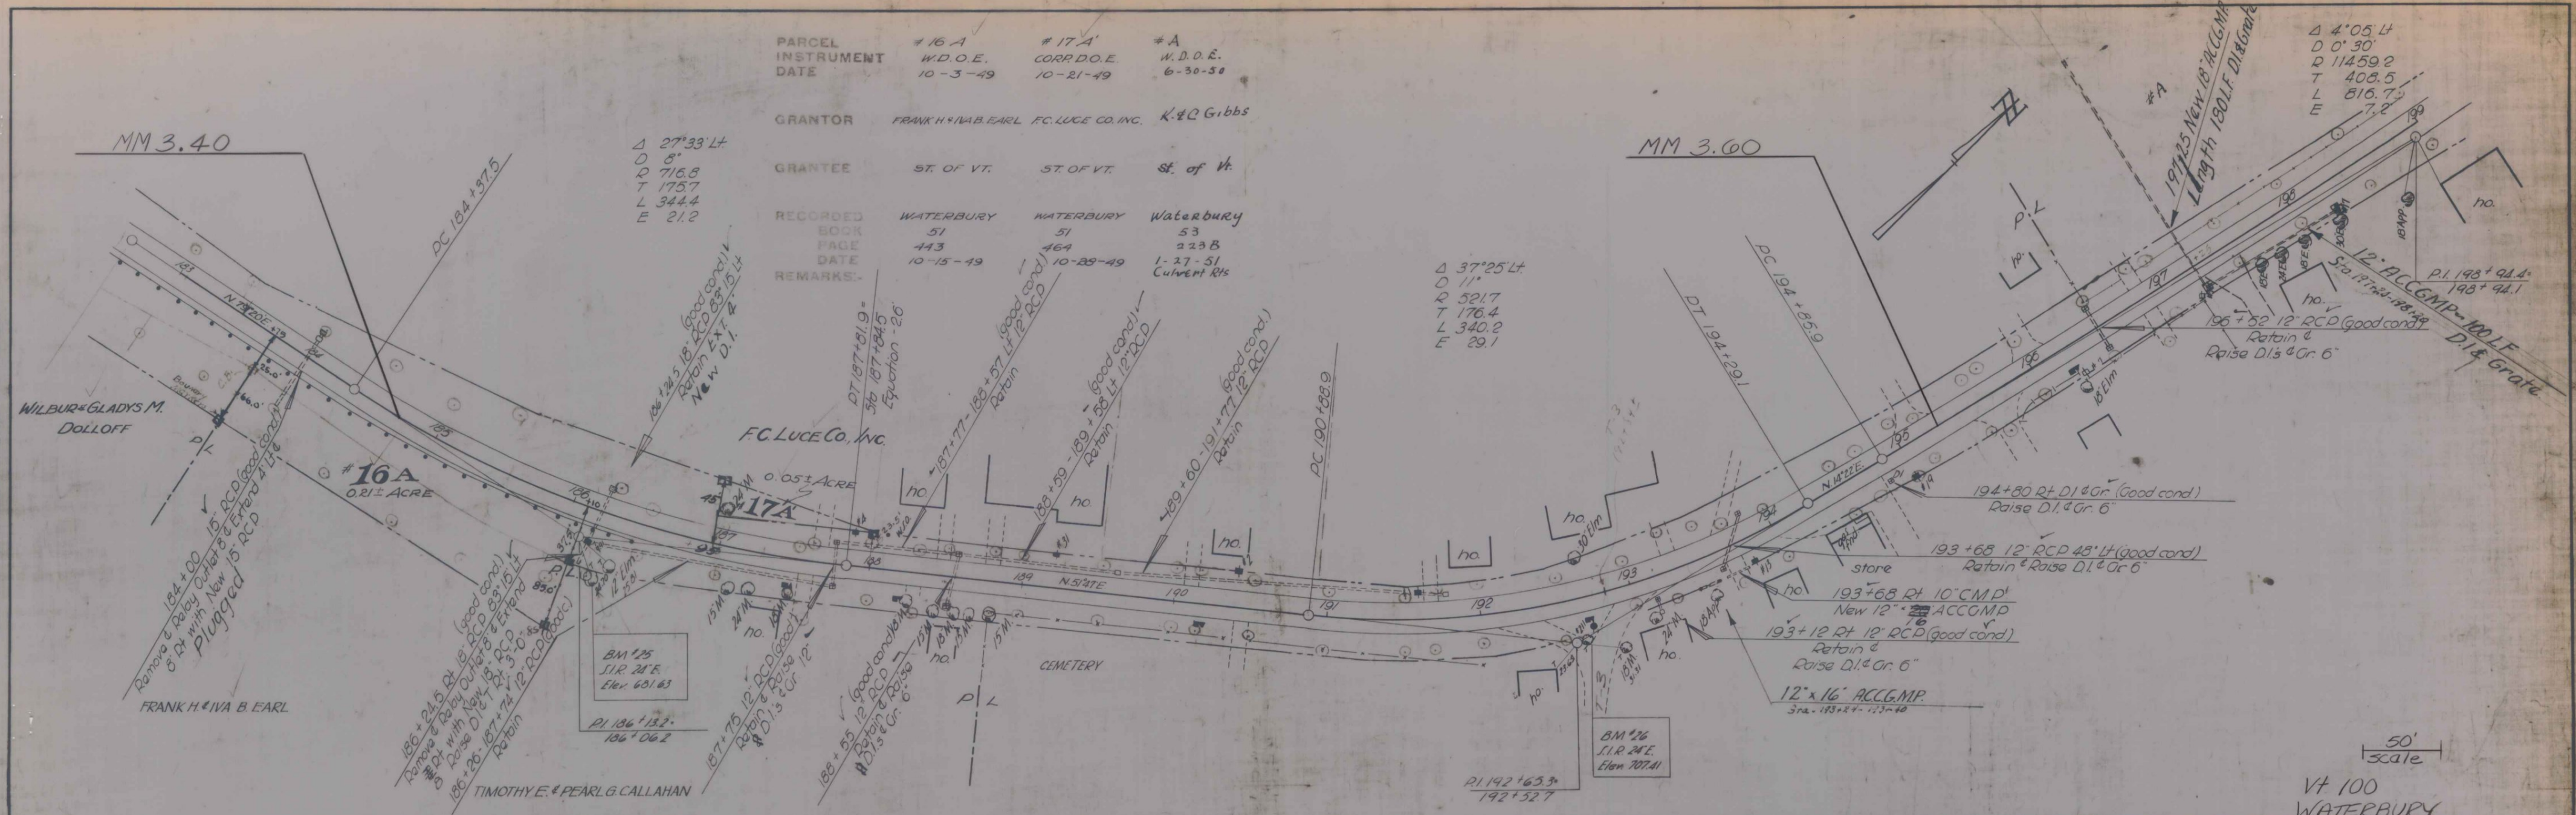

WATERBURY-STOWE
 F 029-1(12)
 sheet 46 of 103
 sheet 4 of 10