
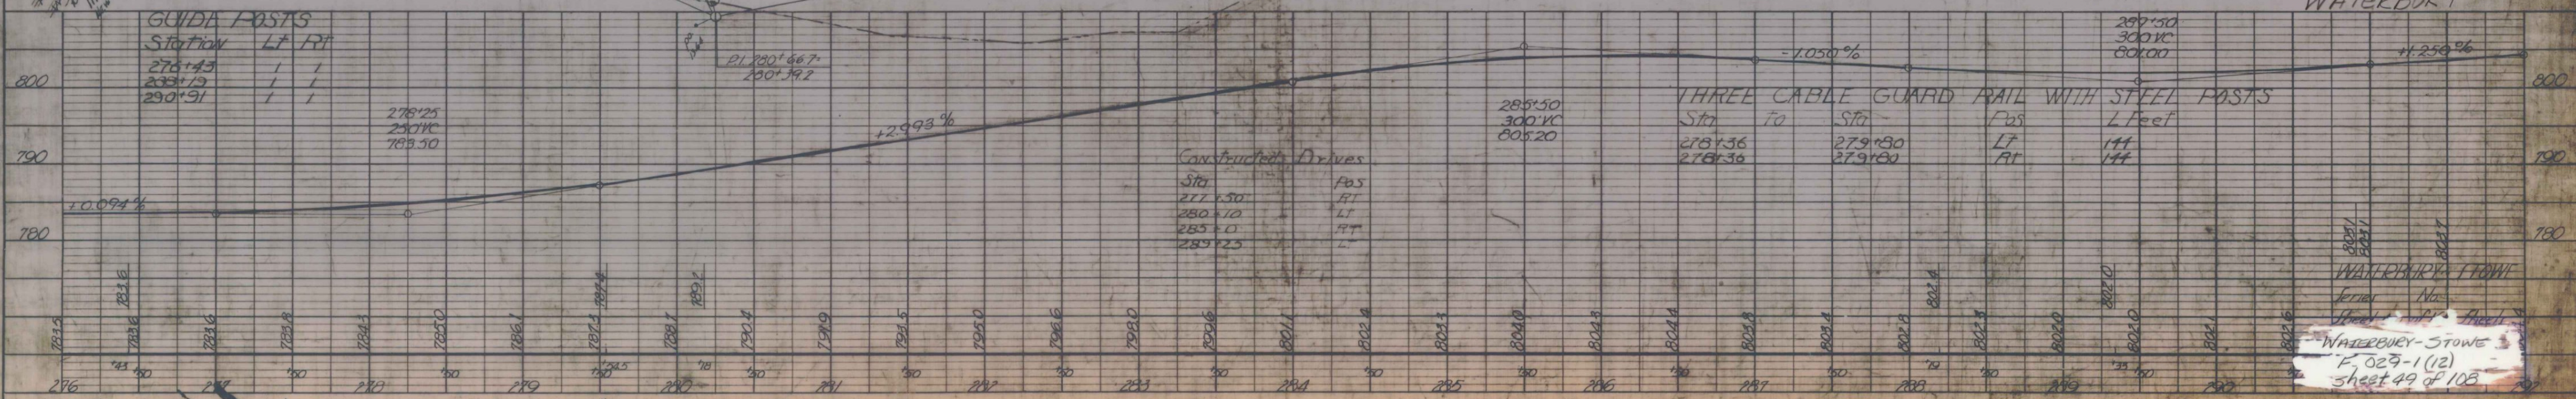
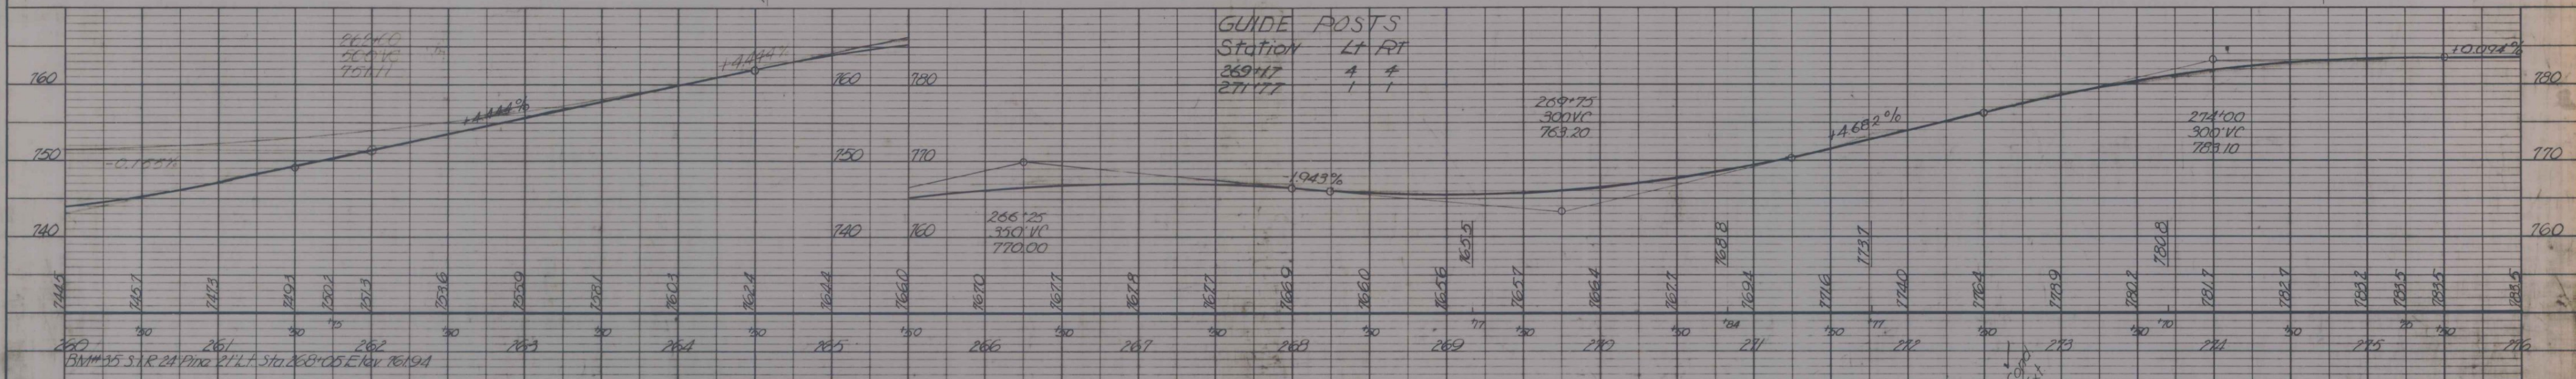


PARCEL	#23 A/B	#24 A, B, C	#25 A
INSTRUMENT	W.D.O.E.	W.D.O.E.	W.D.O.E.
DATE	11-3-49	10-6-49	10-18-49
GRANTOR	WENDELL T. & BERNICE R. DOLLOFF	HENRY B. & GRACE M. TITUS	DR. ROBERT F. KENNEDY, BURTON D. GUILD, HARRY F. WALKER, TRUSTEES, WATERBURY STOWE FISH & GAME CLUB
GRANTEE	WENDELL T. & BERNICE R. DOLLOFF	M. TITUS	HARRY F. WALKER, TRUSTEES, WATERBURY STOWE FISH & GAME CLUB
RECORDED BOOK	WATERBURY 51	WATERBURY 51	WATERBURY 51
PAGE	183	162	170-171
DATE	11-12-49	10-18-49	11-3-49
REMARKS		#24 DMC ON SHEET 15	

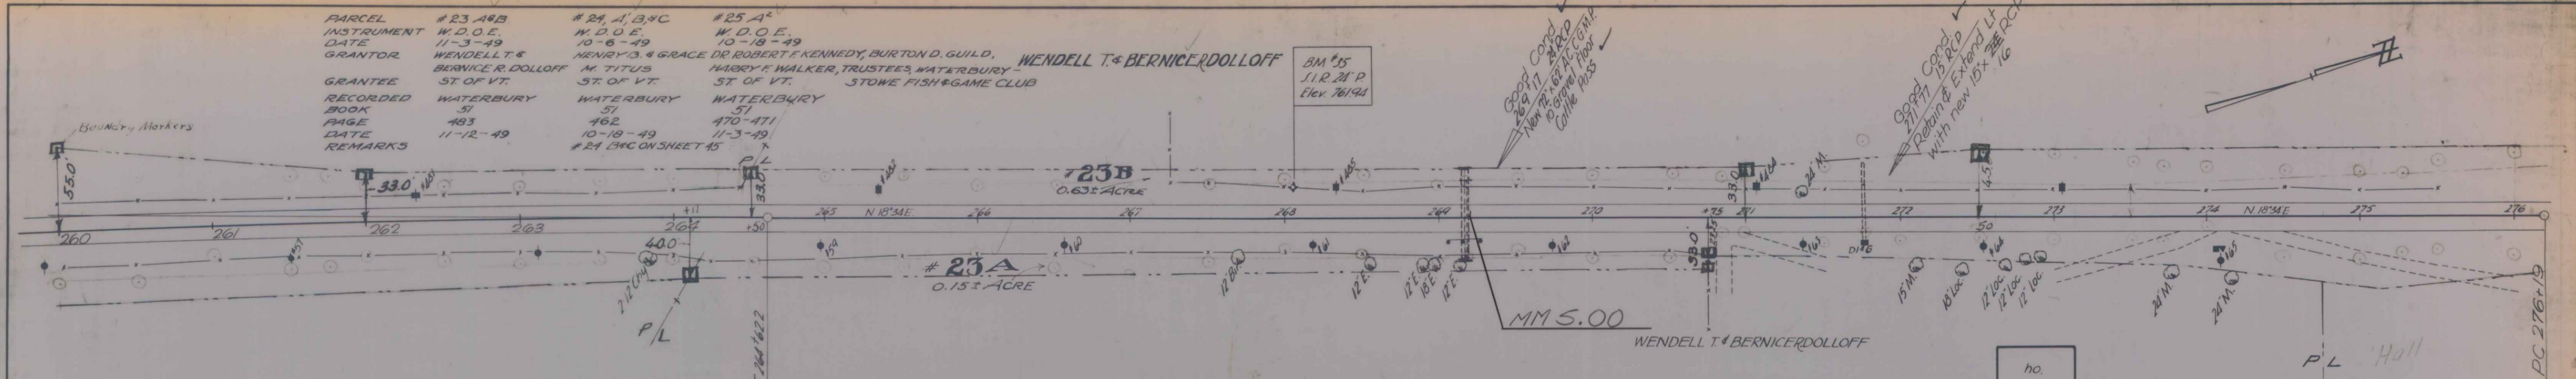

PLAN  
 SURVEYED BY  
 PLAN NO.  
 CHECKED BY  
 DATE

PROFILE  
 SURVEYED BY  
 PLAN NO.  
 CHECKED BY  
 DATE