
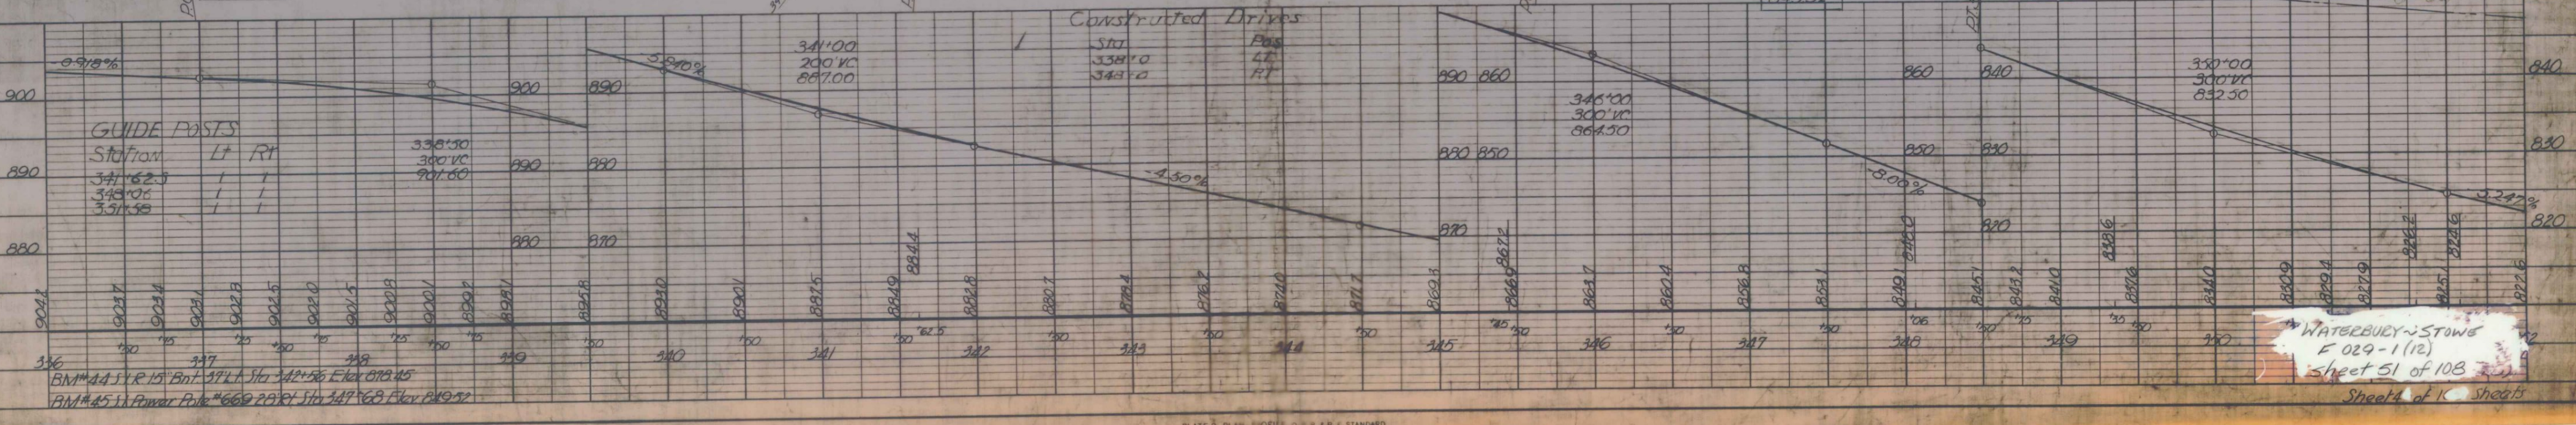
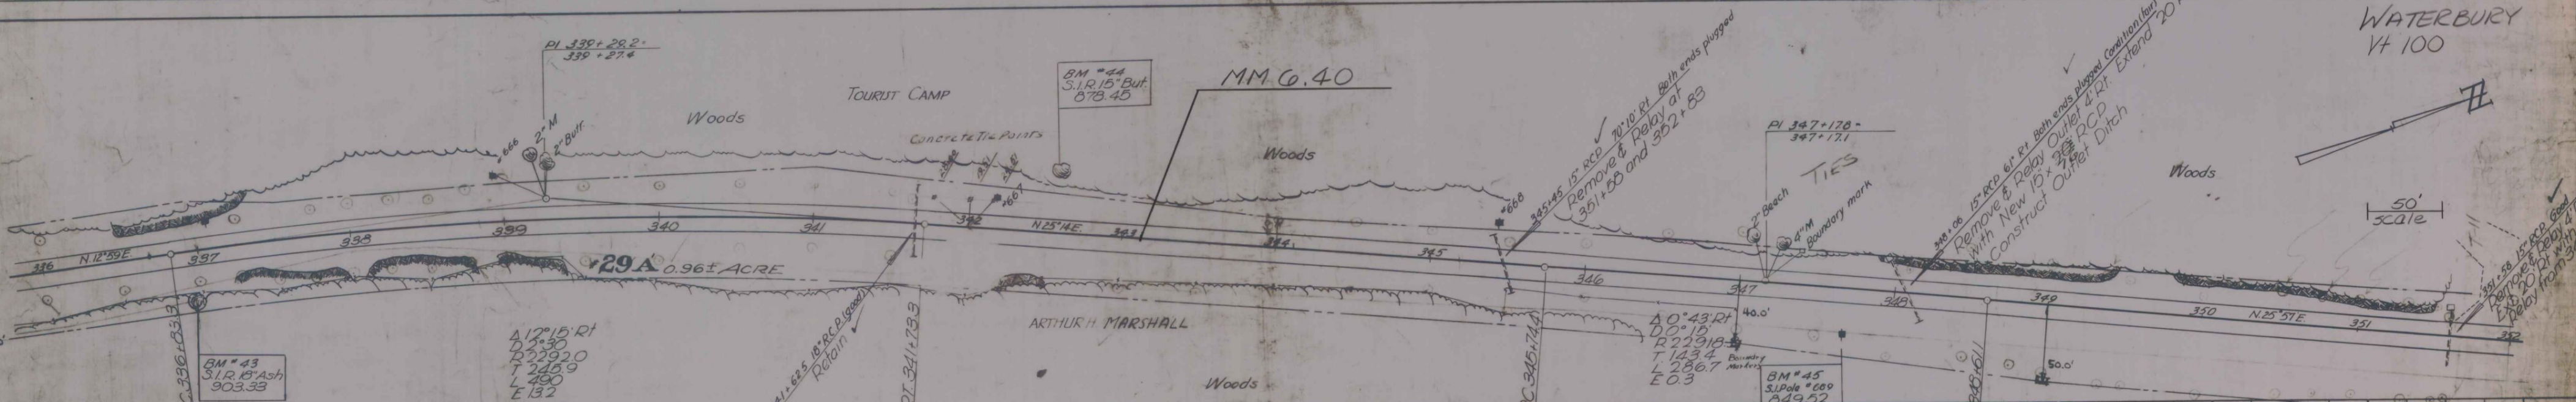
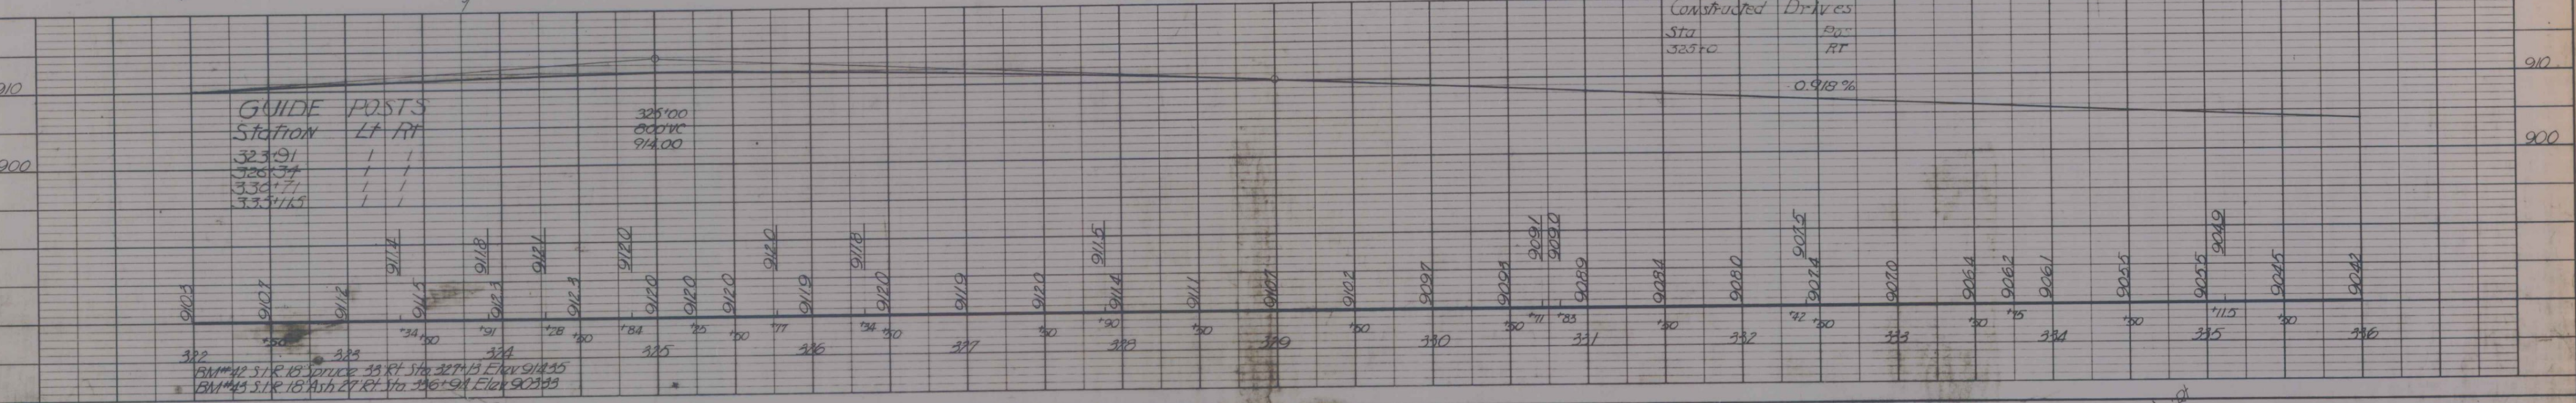


PARCEL #28 A #29 A+B
 INSTRUMENT W.D.O.E. W.D.O.E.
 DATE 11-1-49 11-1-49
 GRANTOR ARTHUR, RALPH, & DANIEL MARSHALL ARTHUR H. MARSHALL
 GRANTEE ST. OF VT. ST. OF VT.
 RECORDED WATERBURY 37 WATERBURY 37
 BOOK 487-6 487-8
 PAGE 11-16-49 11-16-49
 DATE 11-16-49 11-16-49
 REMARKS #29 B ON SHEET 47

EARLEPHYLINDA H LIFTON

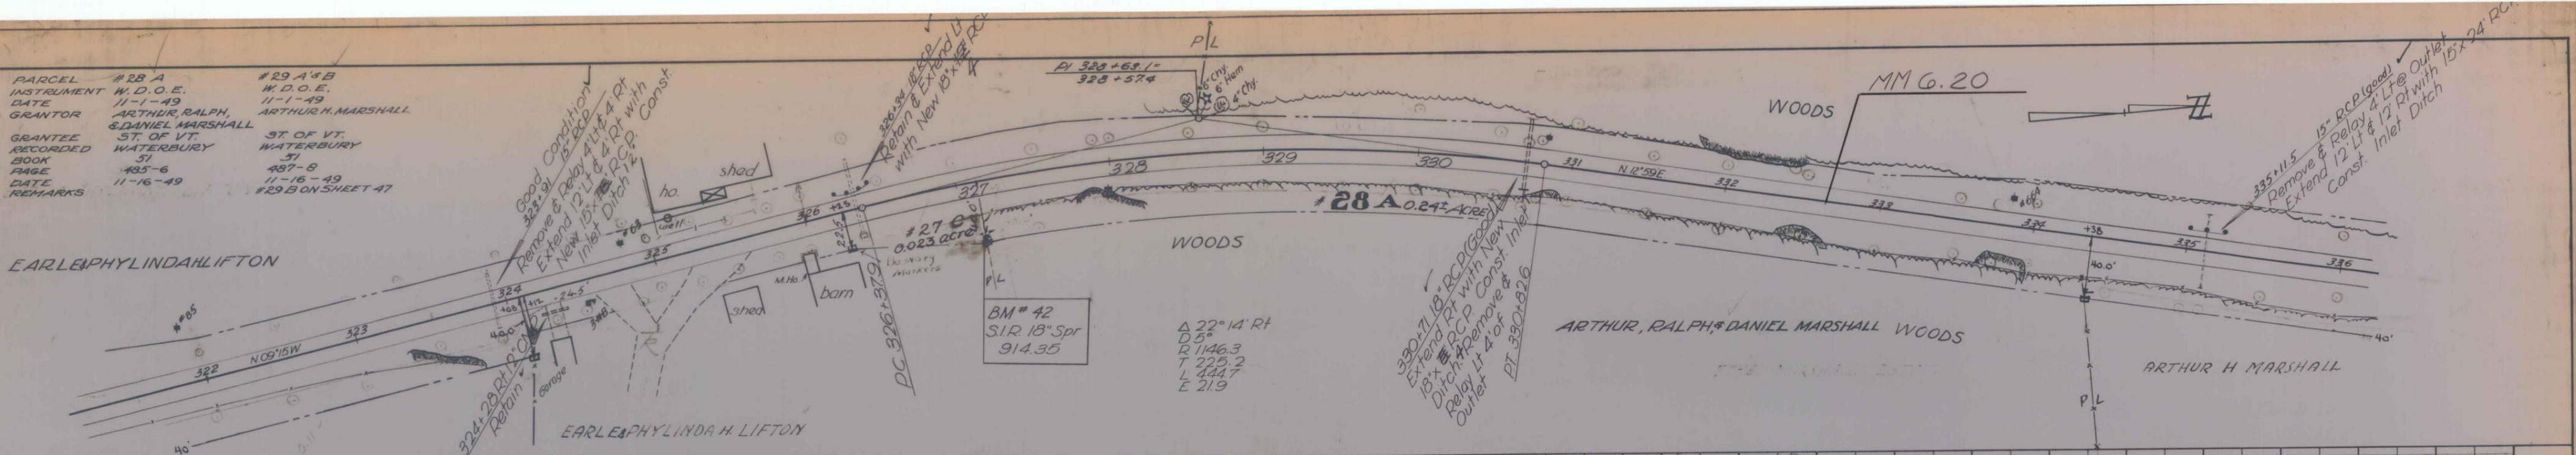

PLAN
 SURVEYED
 PLOTTED
 NOTE BOOK
 ALIGNMENT CHECKED
 RT. OF WAY CHECKED
 NO.

PROFILE
 SURVEYED
 PLOTTED
 NOTE BOOK
 B.M. CHECKED
 B.M. NOTED
 STRUCTURE IDENTIFIED
 NO.

WATERBURY-STOWS
 5 029-1 (12)
 sheet 51 of 108
 Sheets of 10 sheets